


CROSS SECTION-G-LOOKING WEST- Scale 1"=100'

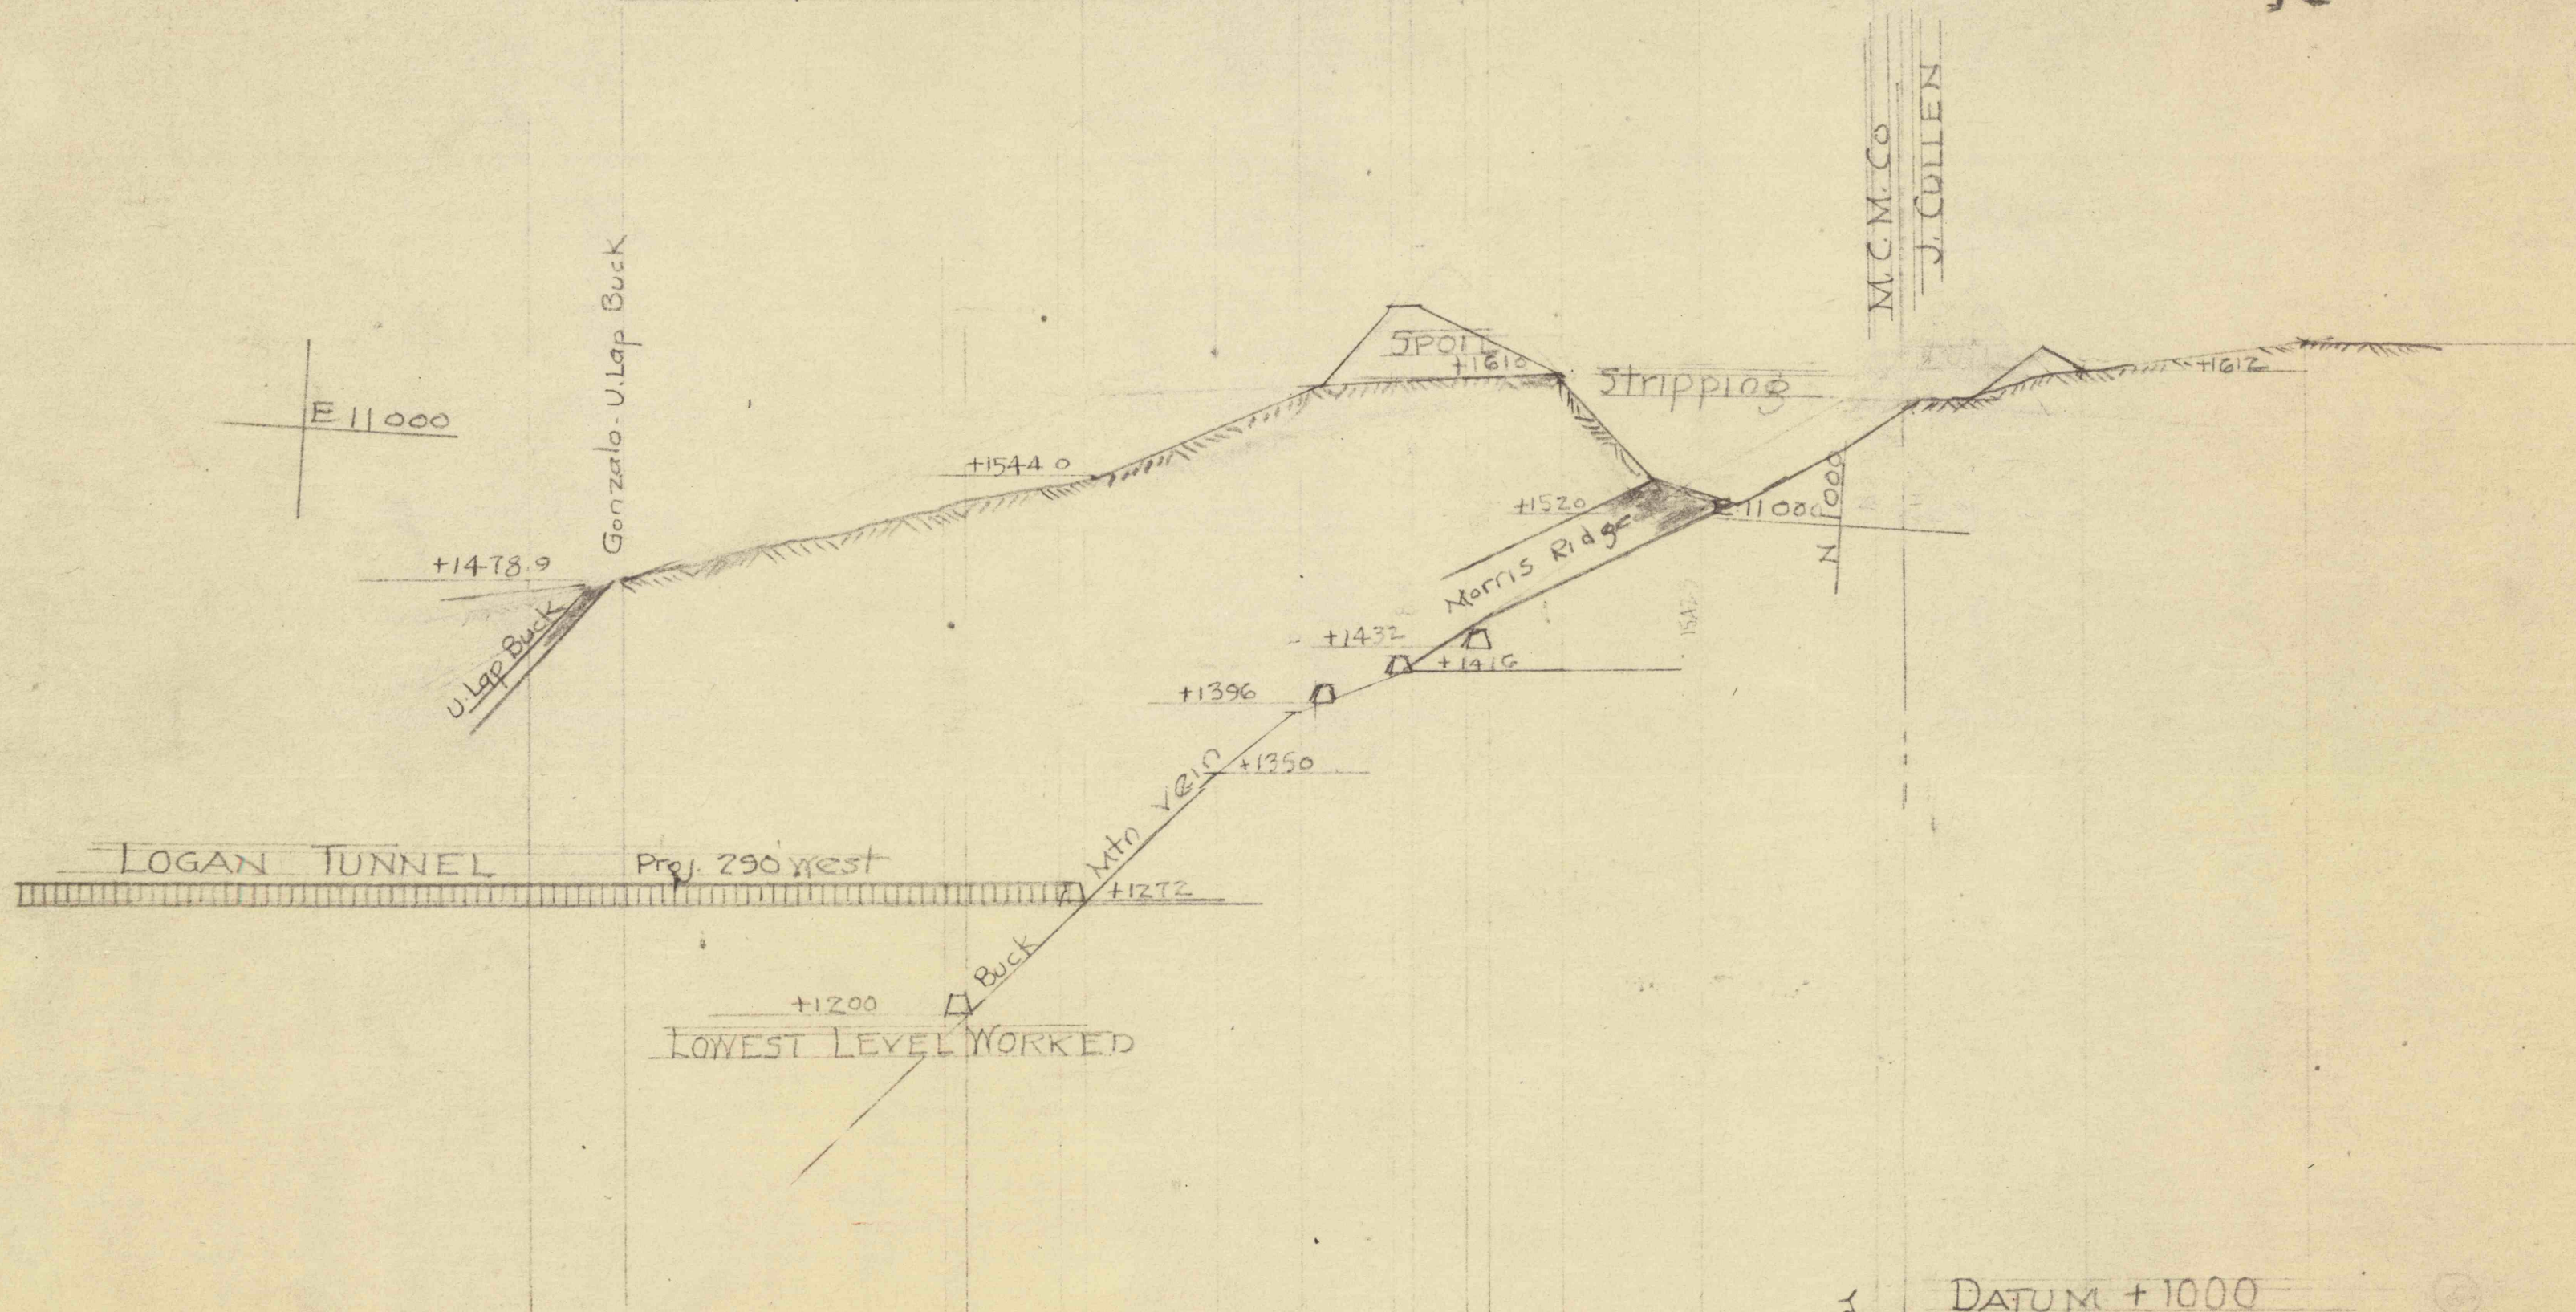

WESTERN MIDDLE FIELD. CENTRALIA COLLIERY.
NORTH CONYNGHAM TWP, COLUMBIA COUNTY, PA. LEHIGH VALLEY CO.
11-WEST MAHANOHY DISTRICT.