


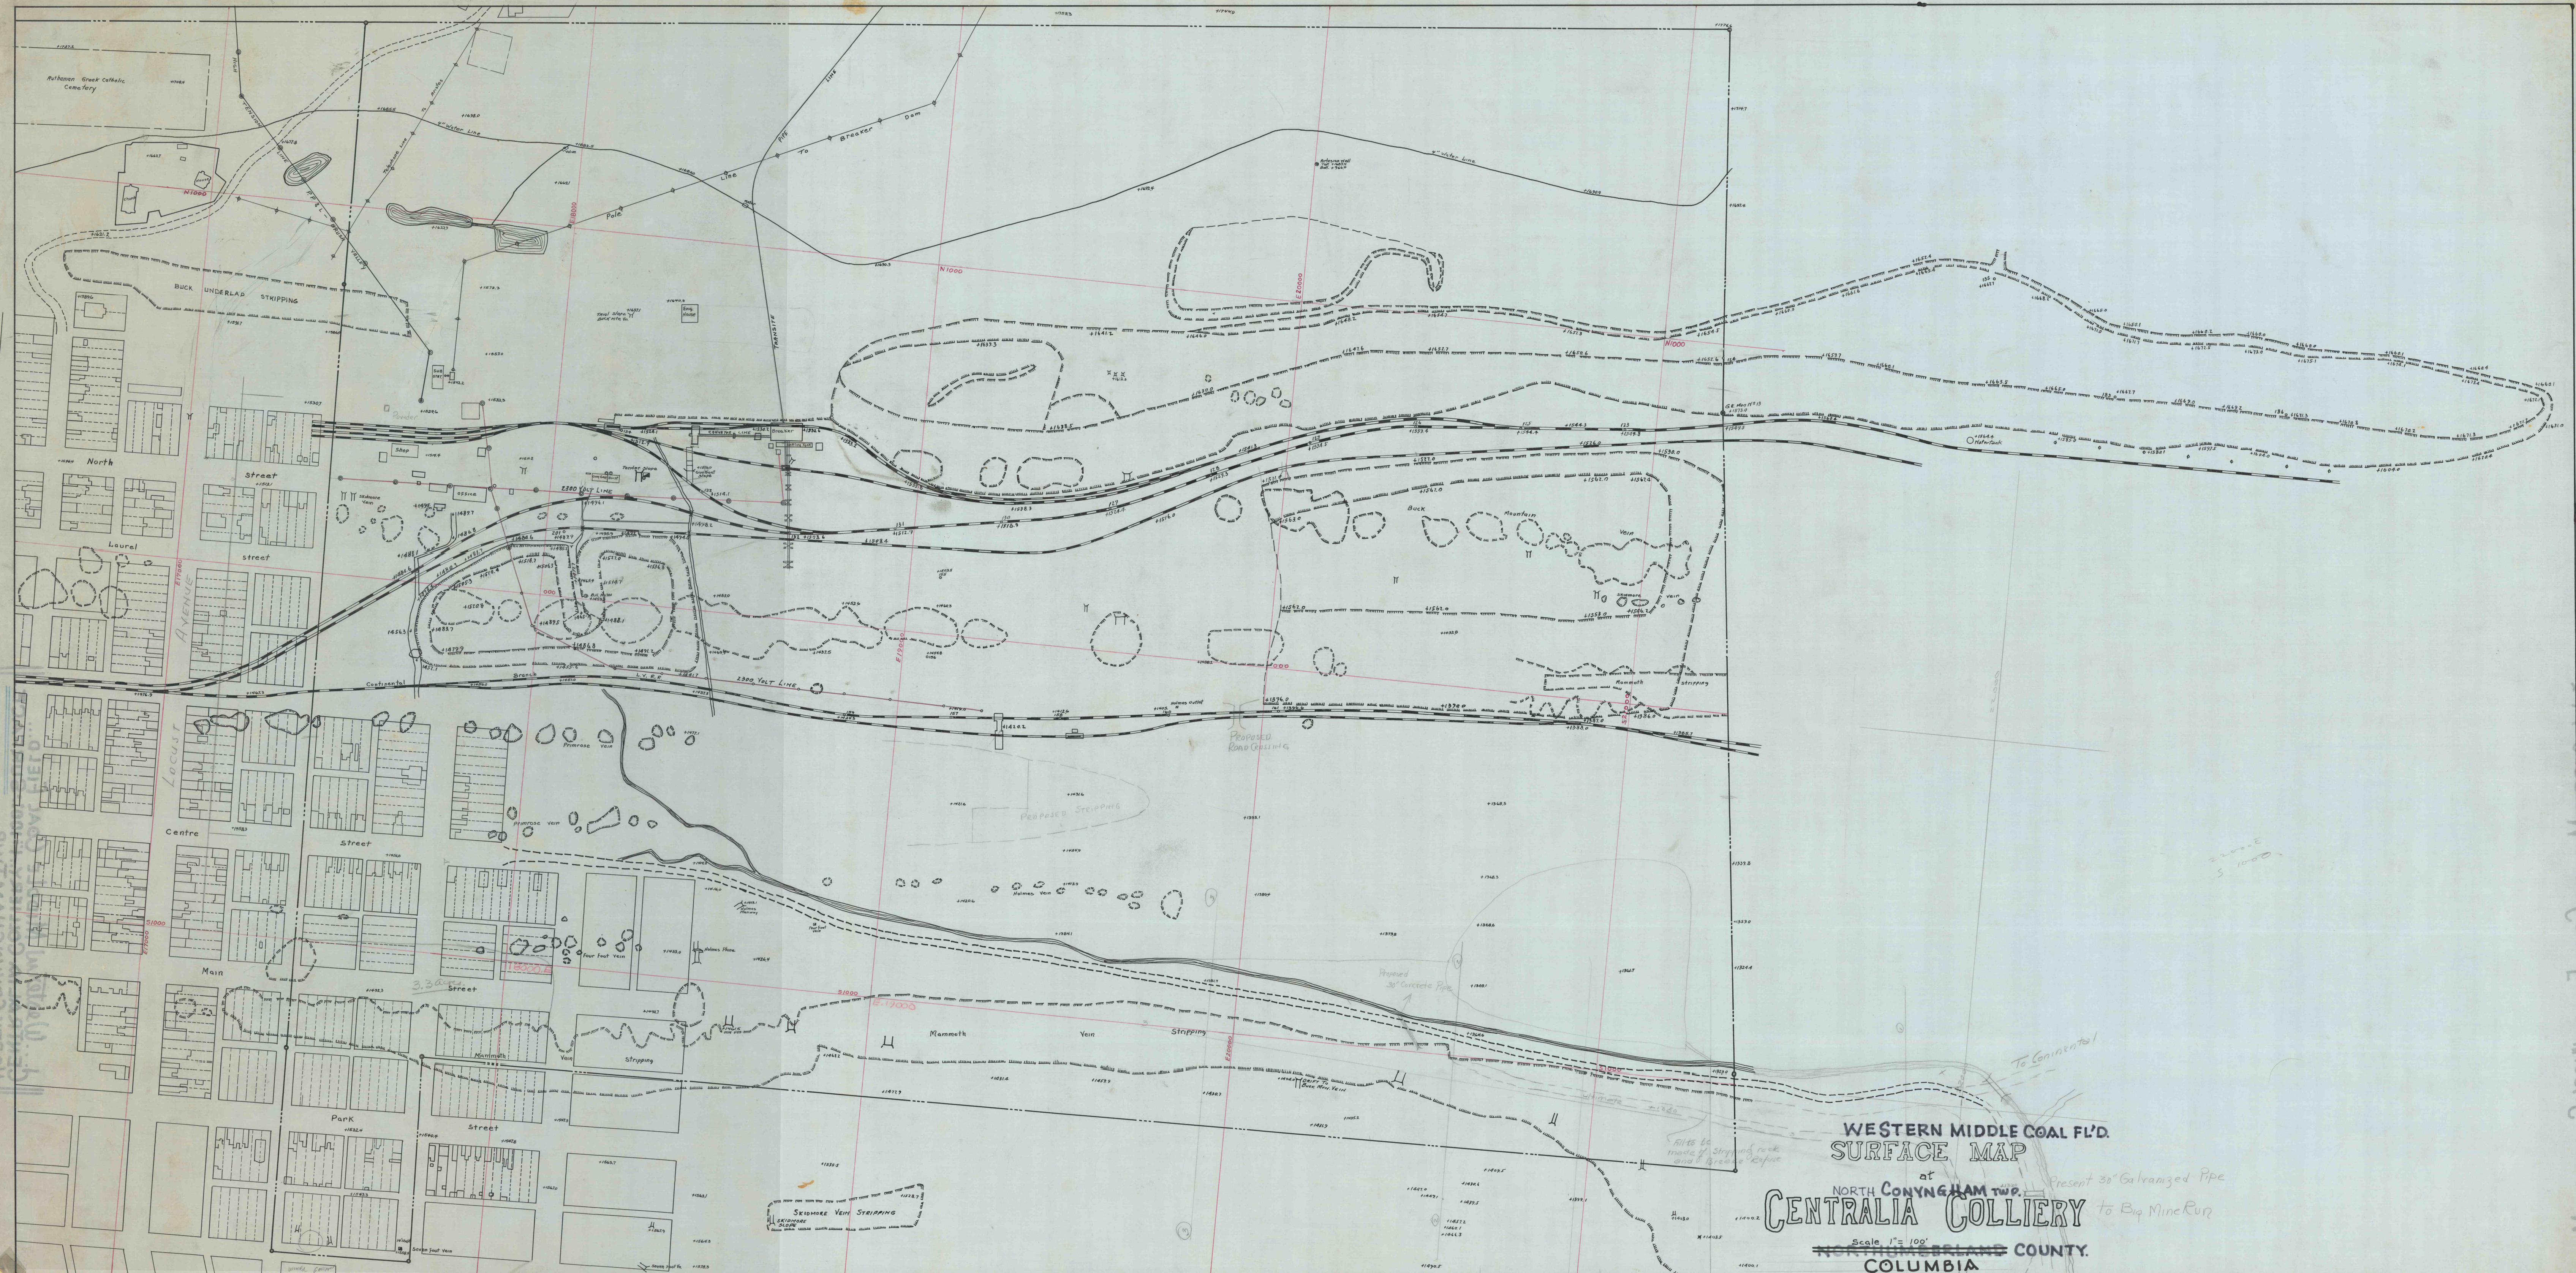

North Coningham Township...
