


Western MIDDLE FIELD...
HOLMES TOP SPLIT VEIN

at
CENTRALIA COLLIERY

Coningham TWP. OF THE Columbia County, PA.
Lehigh Valley Coal Company

ENGINEERING DEPARTMENT L.V.C. CO. MAHANT AND SHAMOKIN DIVISION
100 ft. = 1 in.

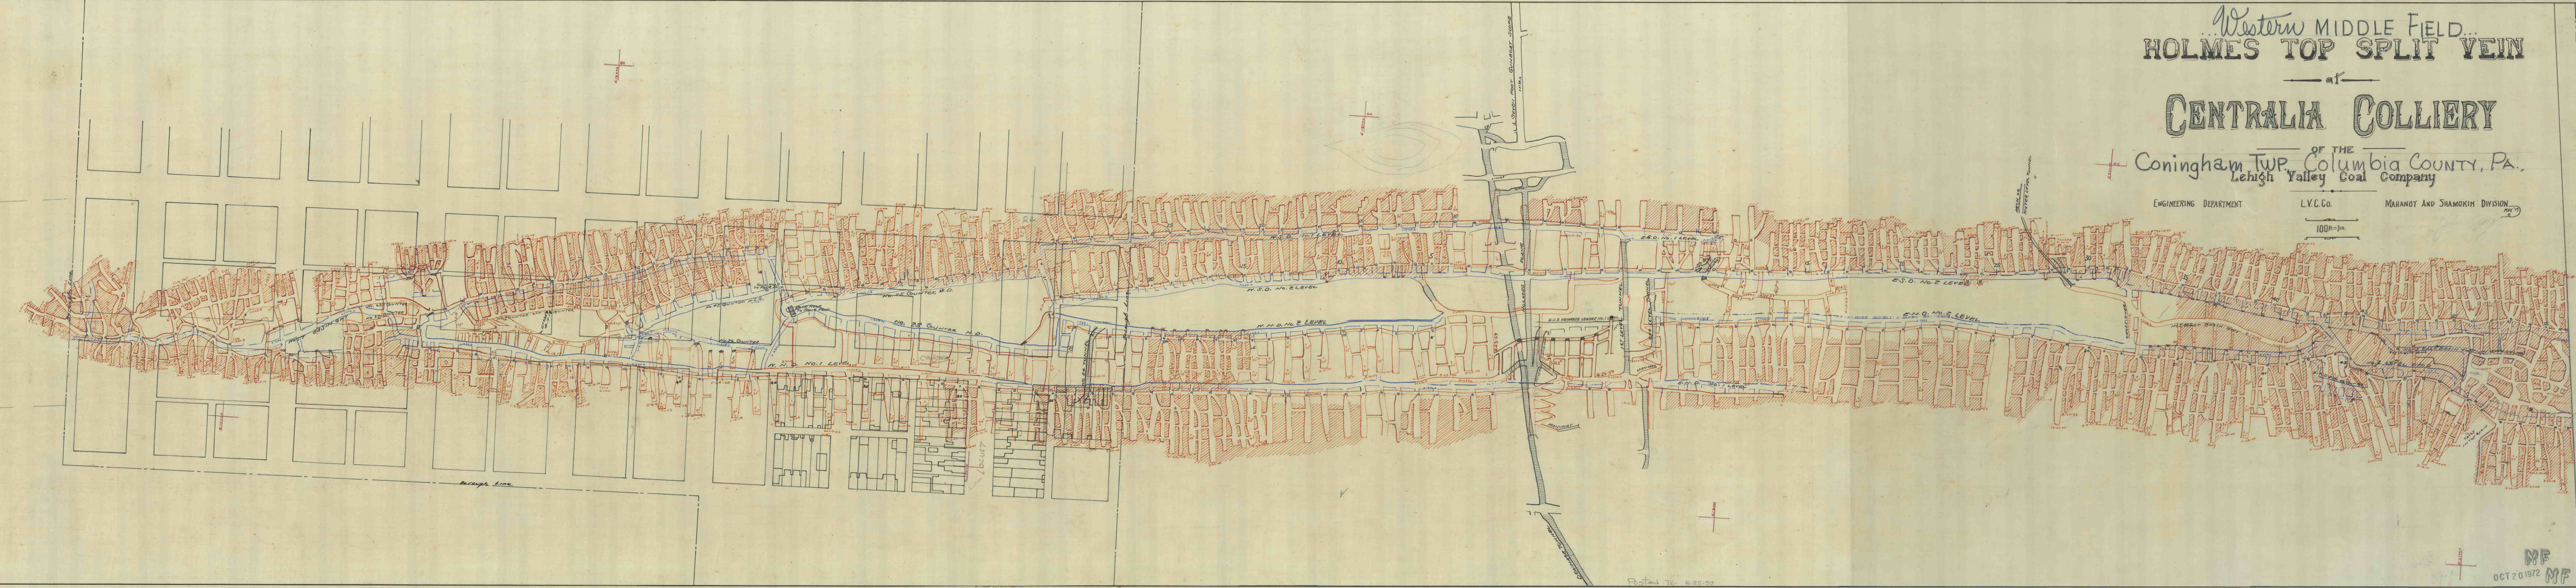

MF
OCT 20 1972 MF

GREENING
10-21