


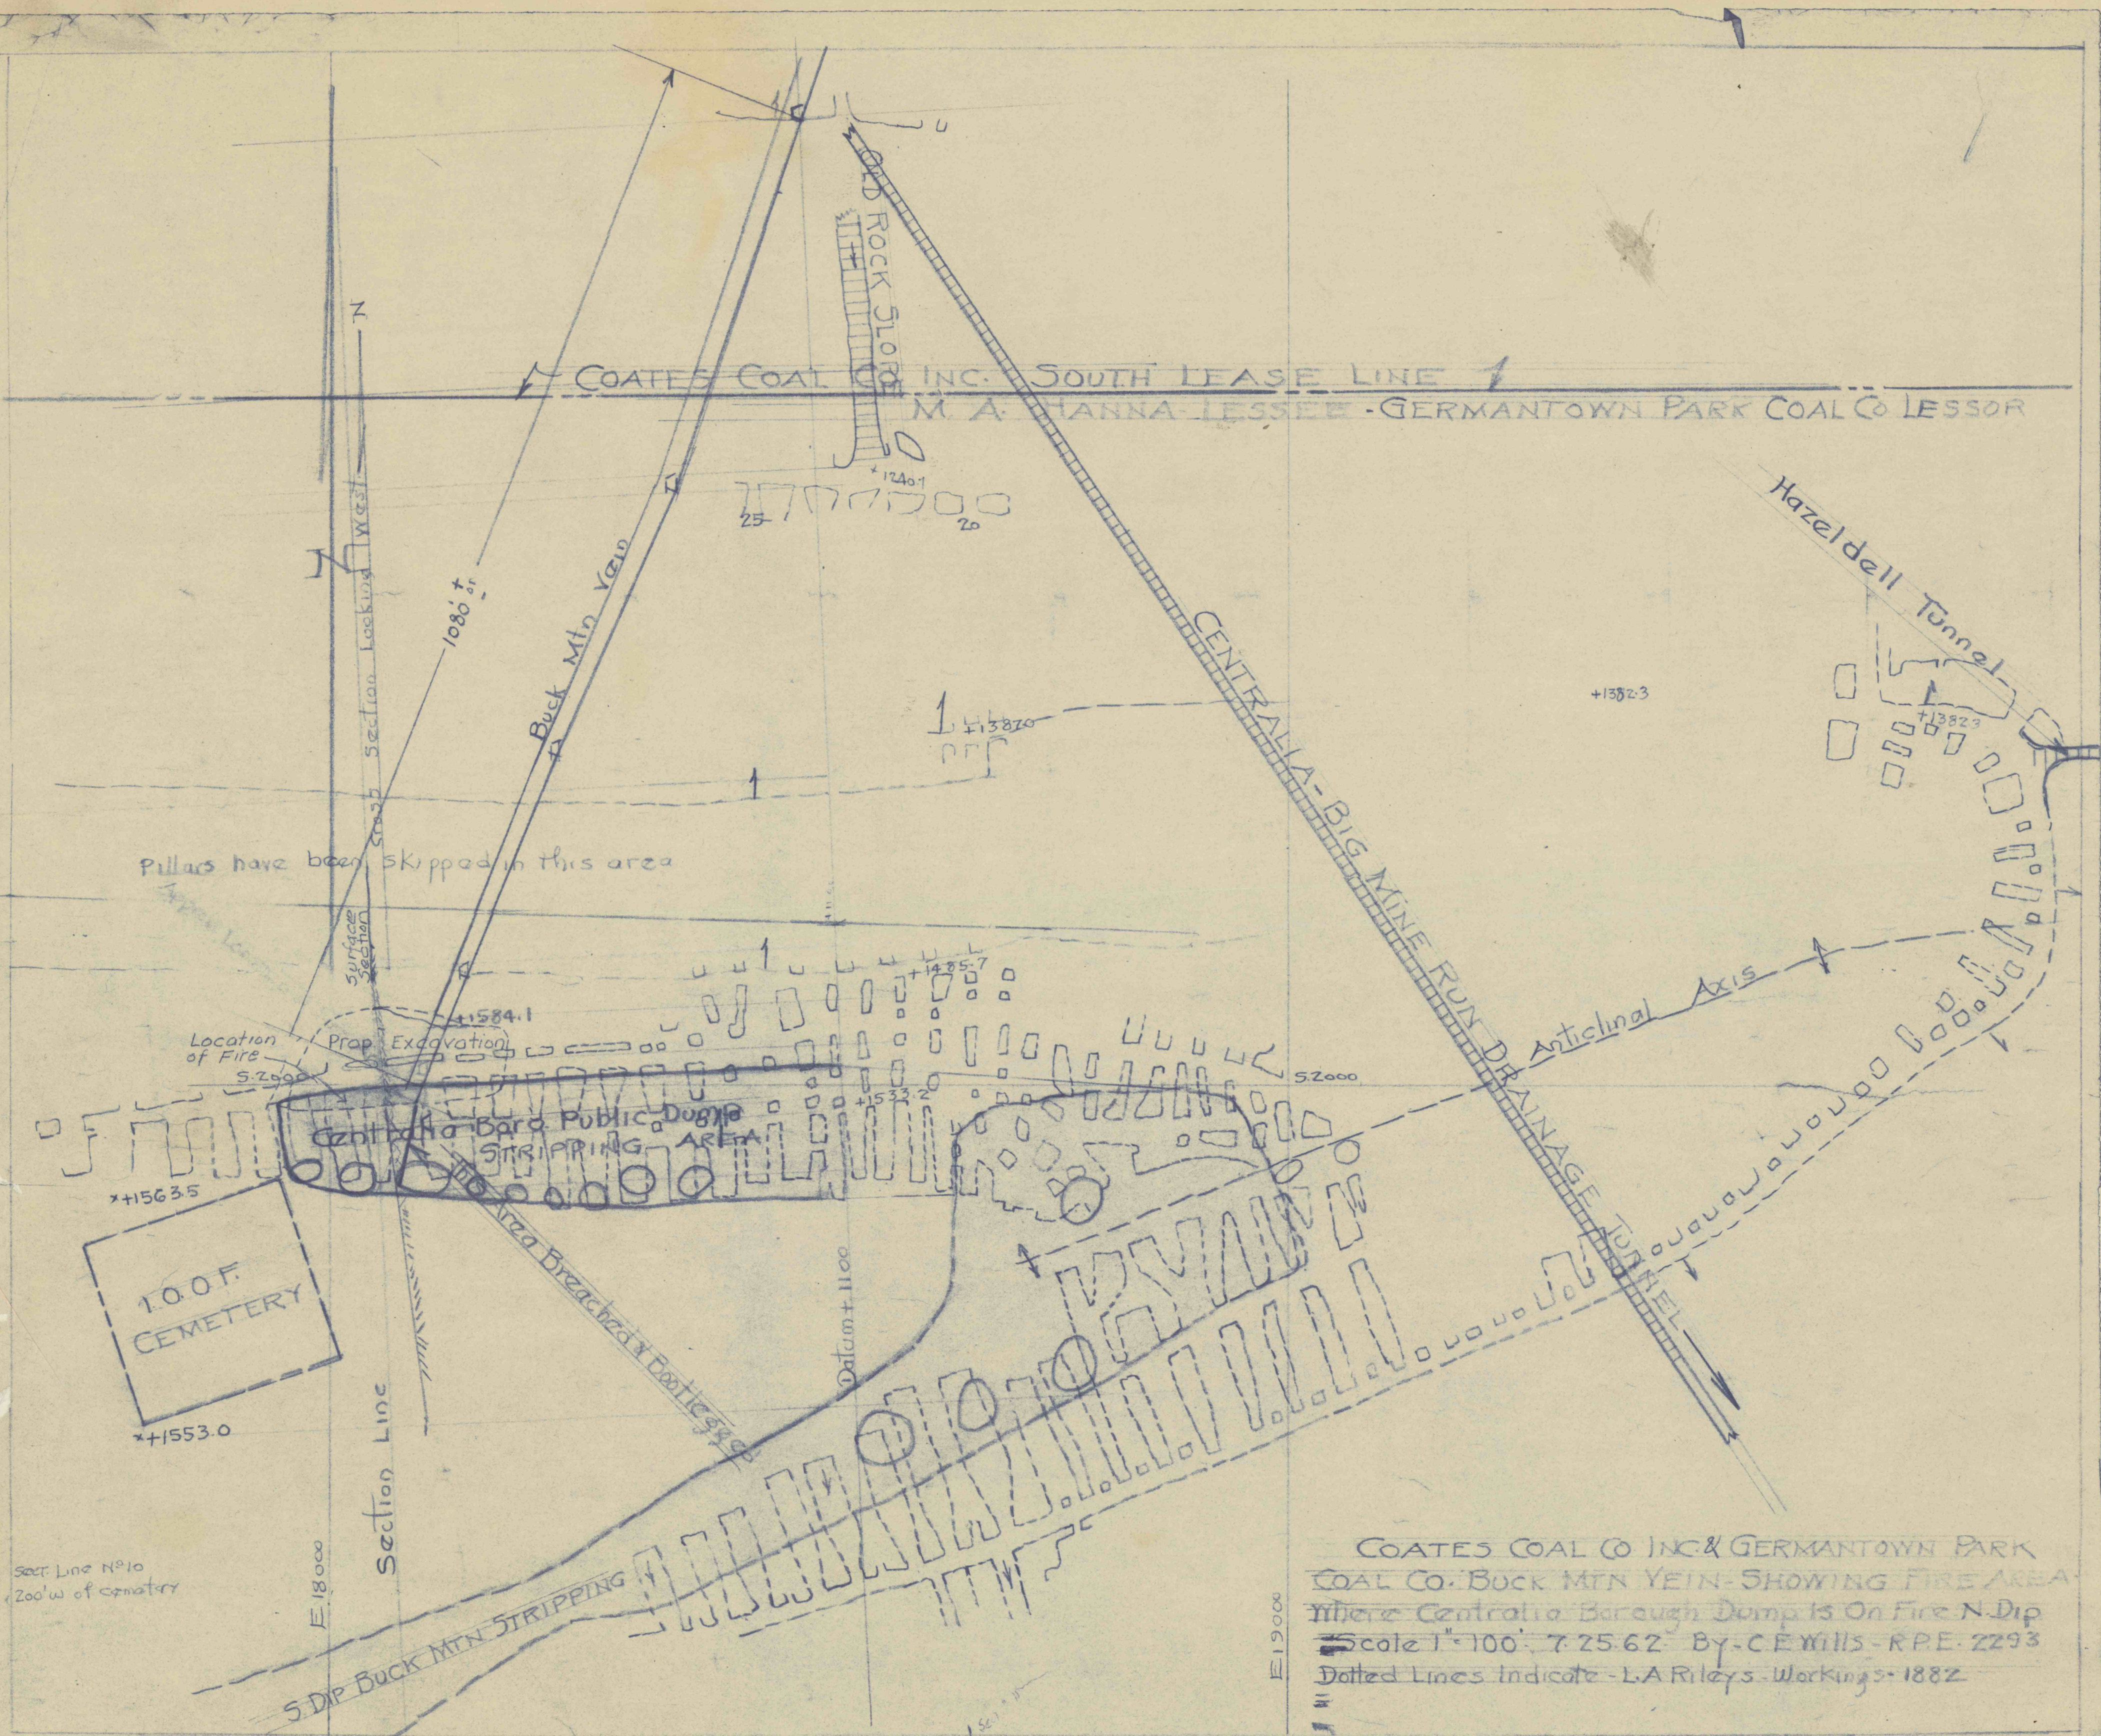

COATES COAL CO. INC. & GERMANTOWN PARK
COAL CO. - BUCK MTN VEIN - SHOWING FIRE AREA
Where Centralia Borough Dump is On Fire N. Dip
Scale 1" = 100' 7.25.62 BY C.E. WILLS - R.P.E. 2293
Dotted Lines Indicate - L.A. Riley's Workings - 1882

sect. line No 10
200' w of cemetery

244