


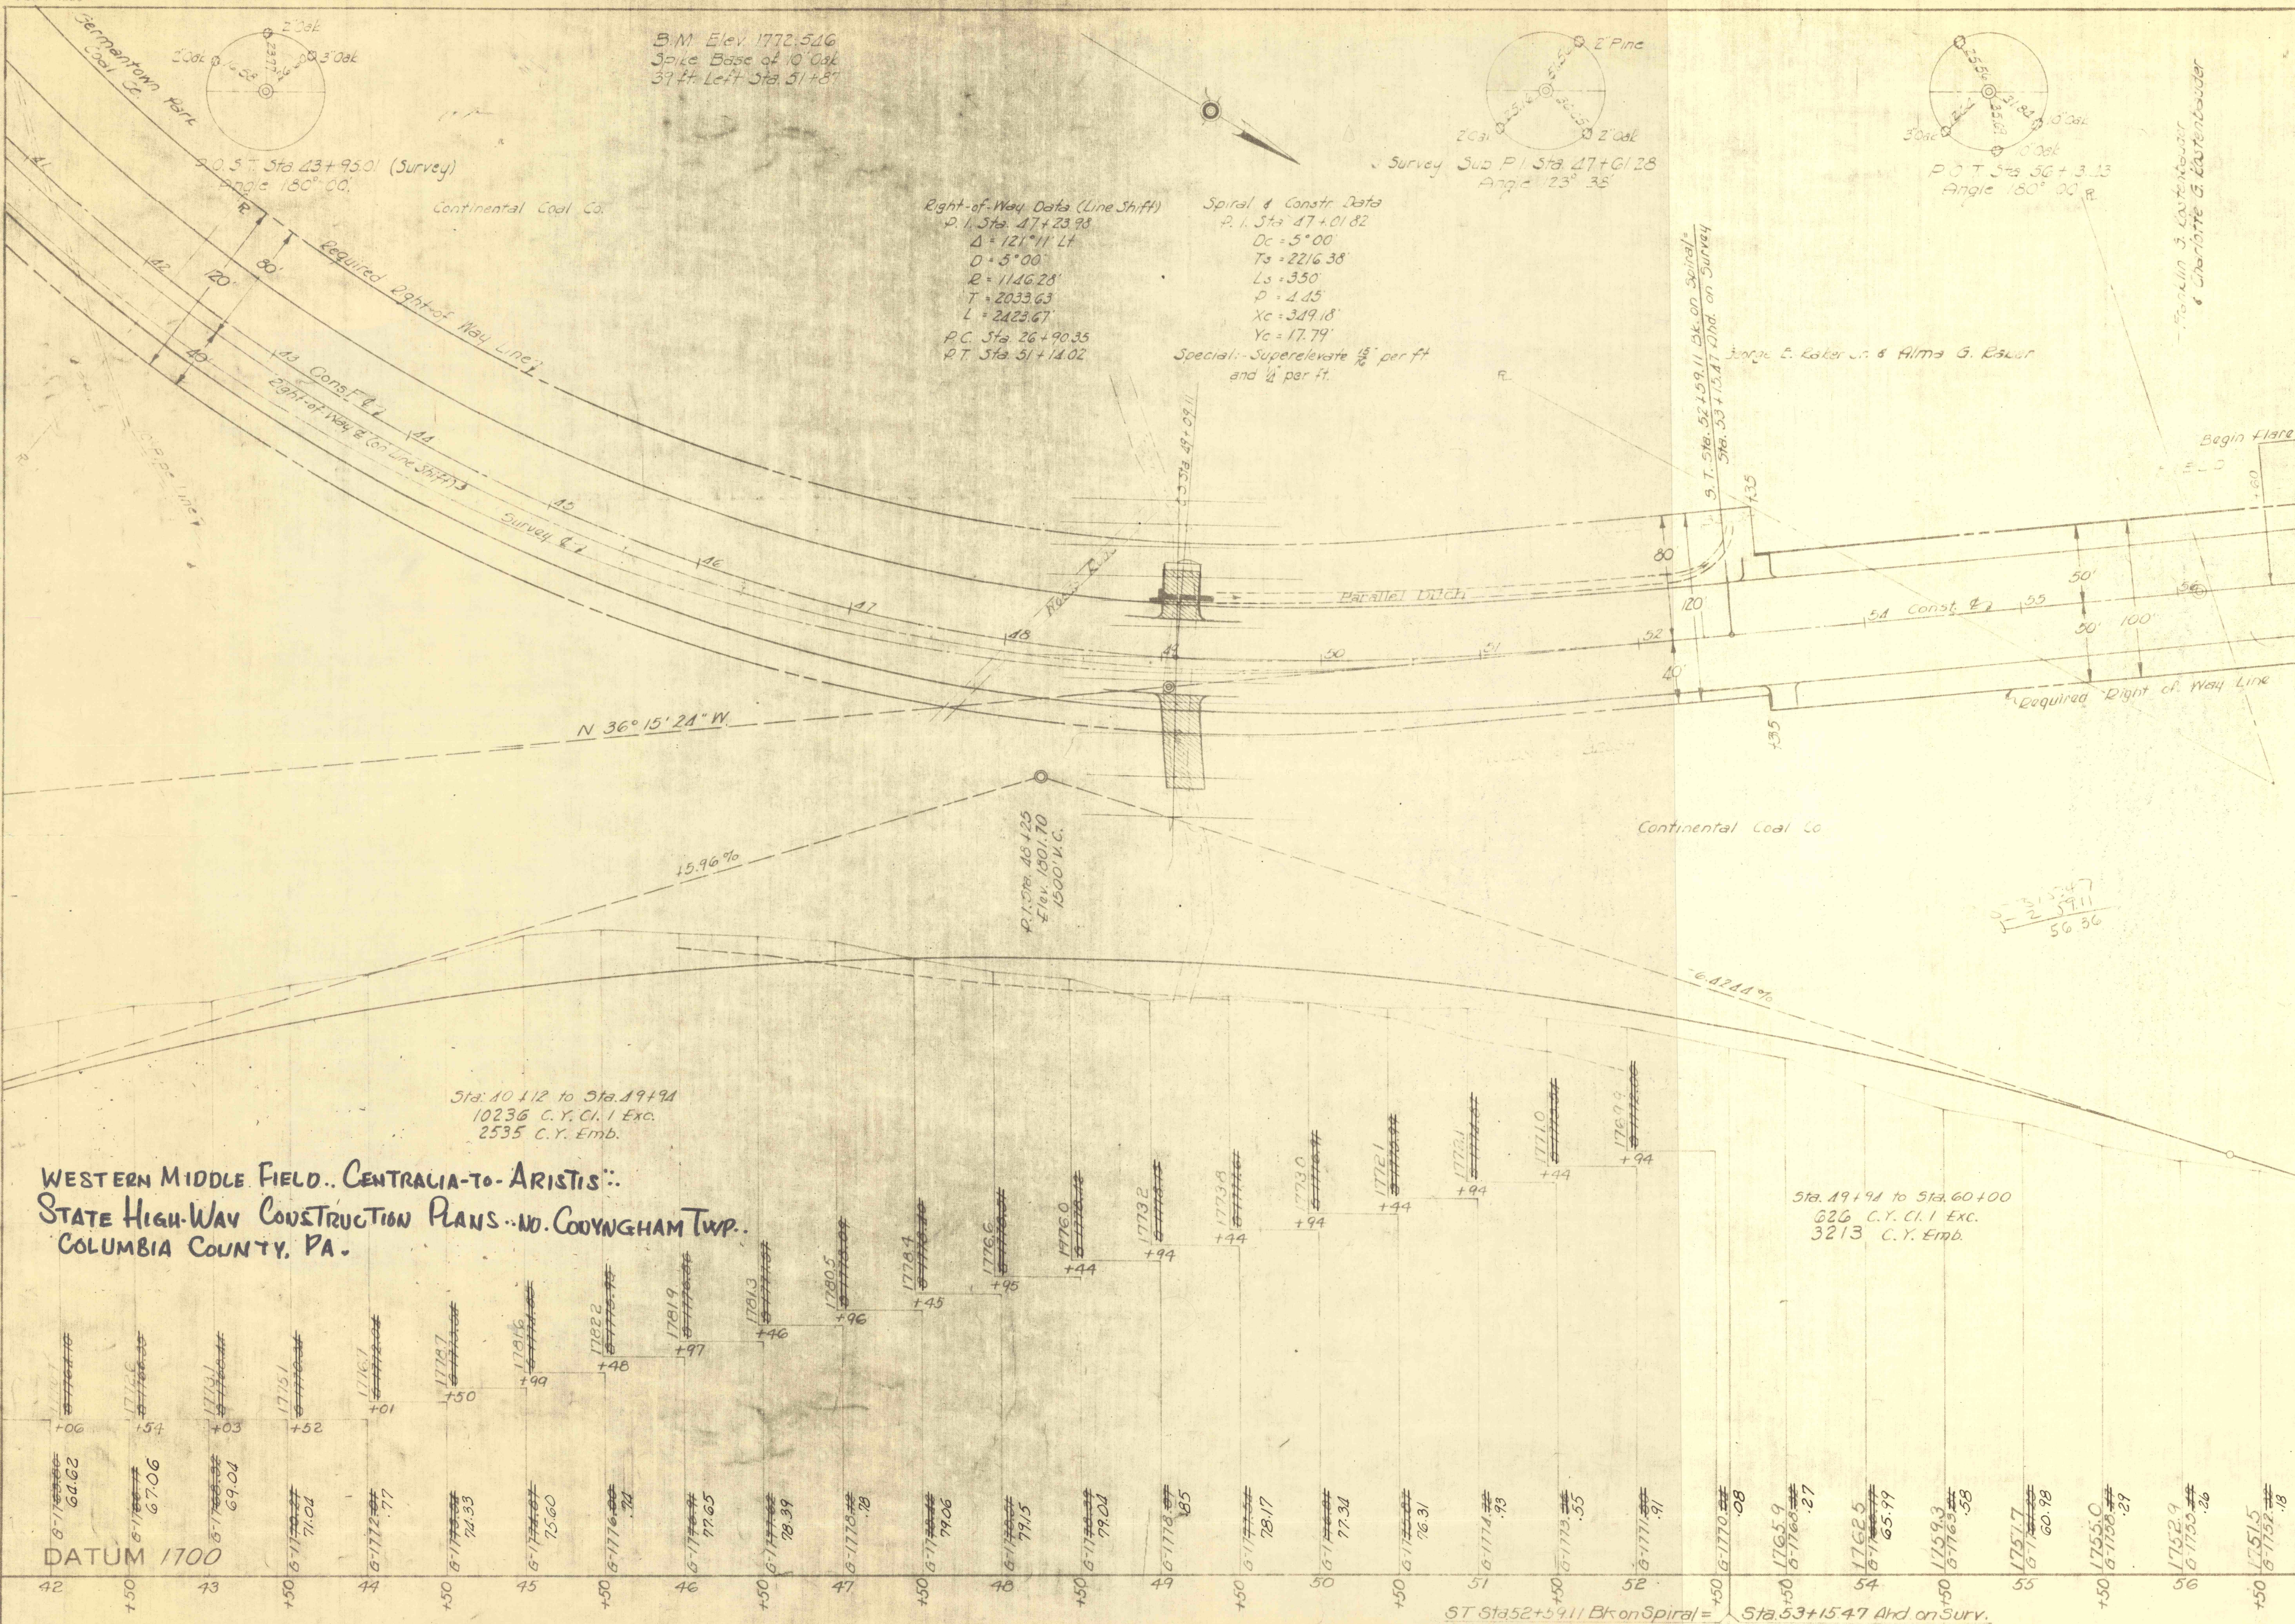

DISTRICT		COUNTY	ROUTE	SECTION	SHEET
3		COLUMBIA	183	3	8 of 10
COVINGHAM TOWNSHIP					
REQUIRED LIST					
60 14	Sta. 41+00 to Sta. 47+50 Lt. ~~12~~ L.F. 6" Pipe U/Drain Type II Bkt. ~~12~~ L.F. 6" Pipe U/Drain Outlets				
37 9.47	Sta. 49+10 Lt. Road (24' Wide) # C.Y. Emb. # C.Y. Sel. Matl. Surf. (4 Depth) # 32 L.F. 18" C.M. Pipe # C.Y. Cl. B Conc. (E5 Edw.) # C.Y. Cl. 2 Exc. (Pipe) # C.Y. Cl. 2 Exc. (Edw.) ~~5~~ C.Y. Cl. 1 Exc. (Road Lt.)				
171 18.43	Sta. 49+10 Rt. Road (24' Wide) # C.Y. Emb. # C.Y. Sel. Matl. Surf. (4 Depth)				
779	Sta. 49+25 to Sta. 51+94 Lt. Parallel Ditch # C.Y. Cl. 2 Exc.				
	Sta. 53+35 Lt. Drive (16' Wide) # C.Y. Emb.				
	Sta. 53+45 Rt. Drive (16' Wide) # C.Y. Emb.				