


Western Middle Field
North Conyngham Township,
Columbia County, Penna.,
Lehigh Valley Collieries.
Holmes Top Split Vein
Centralia Colliery

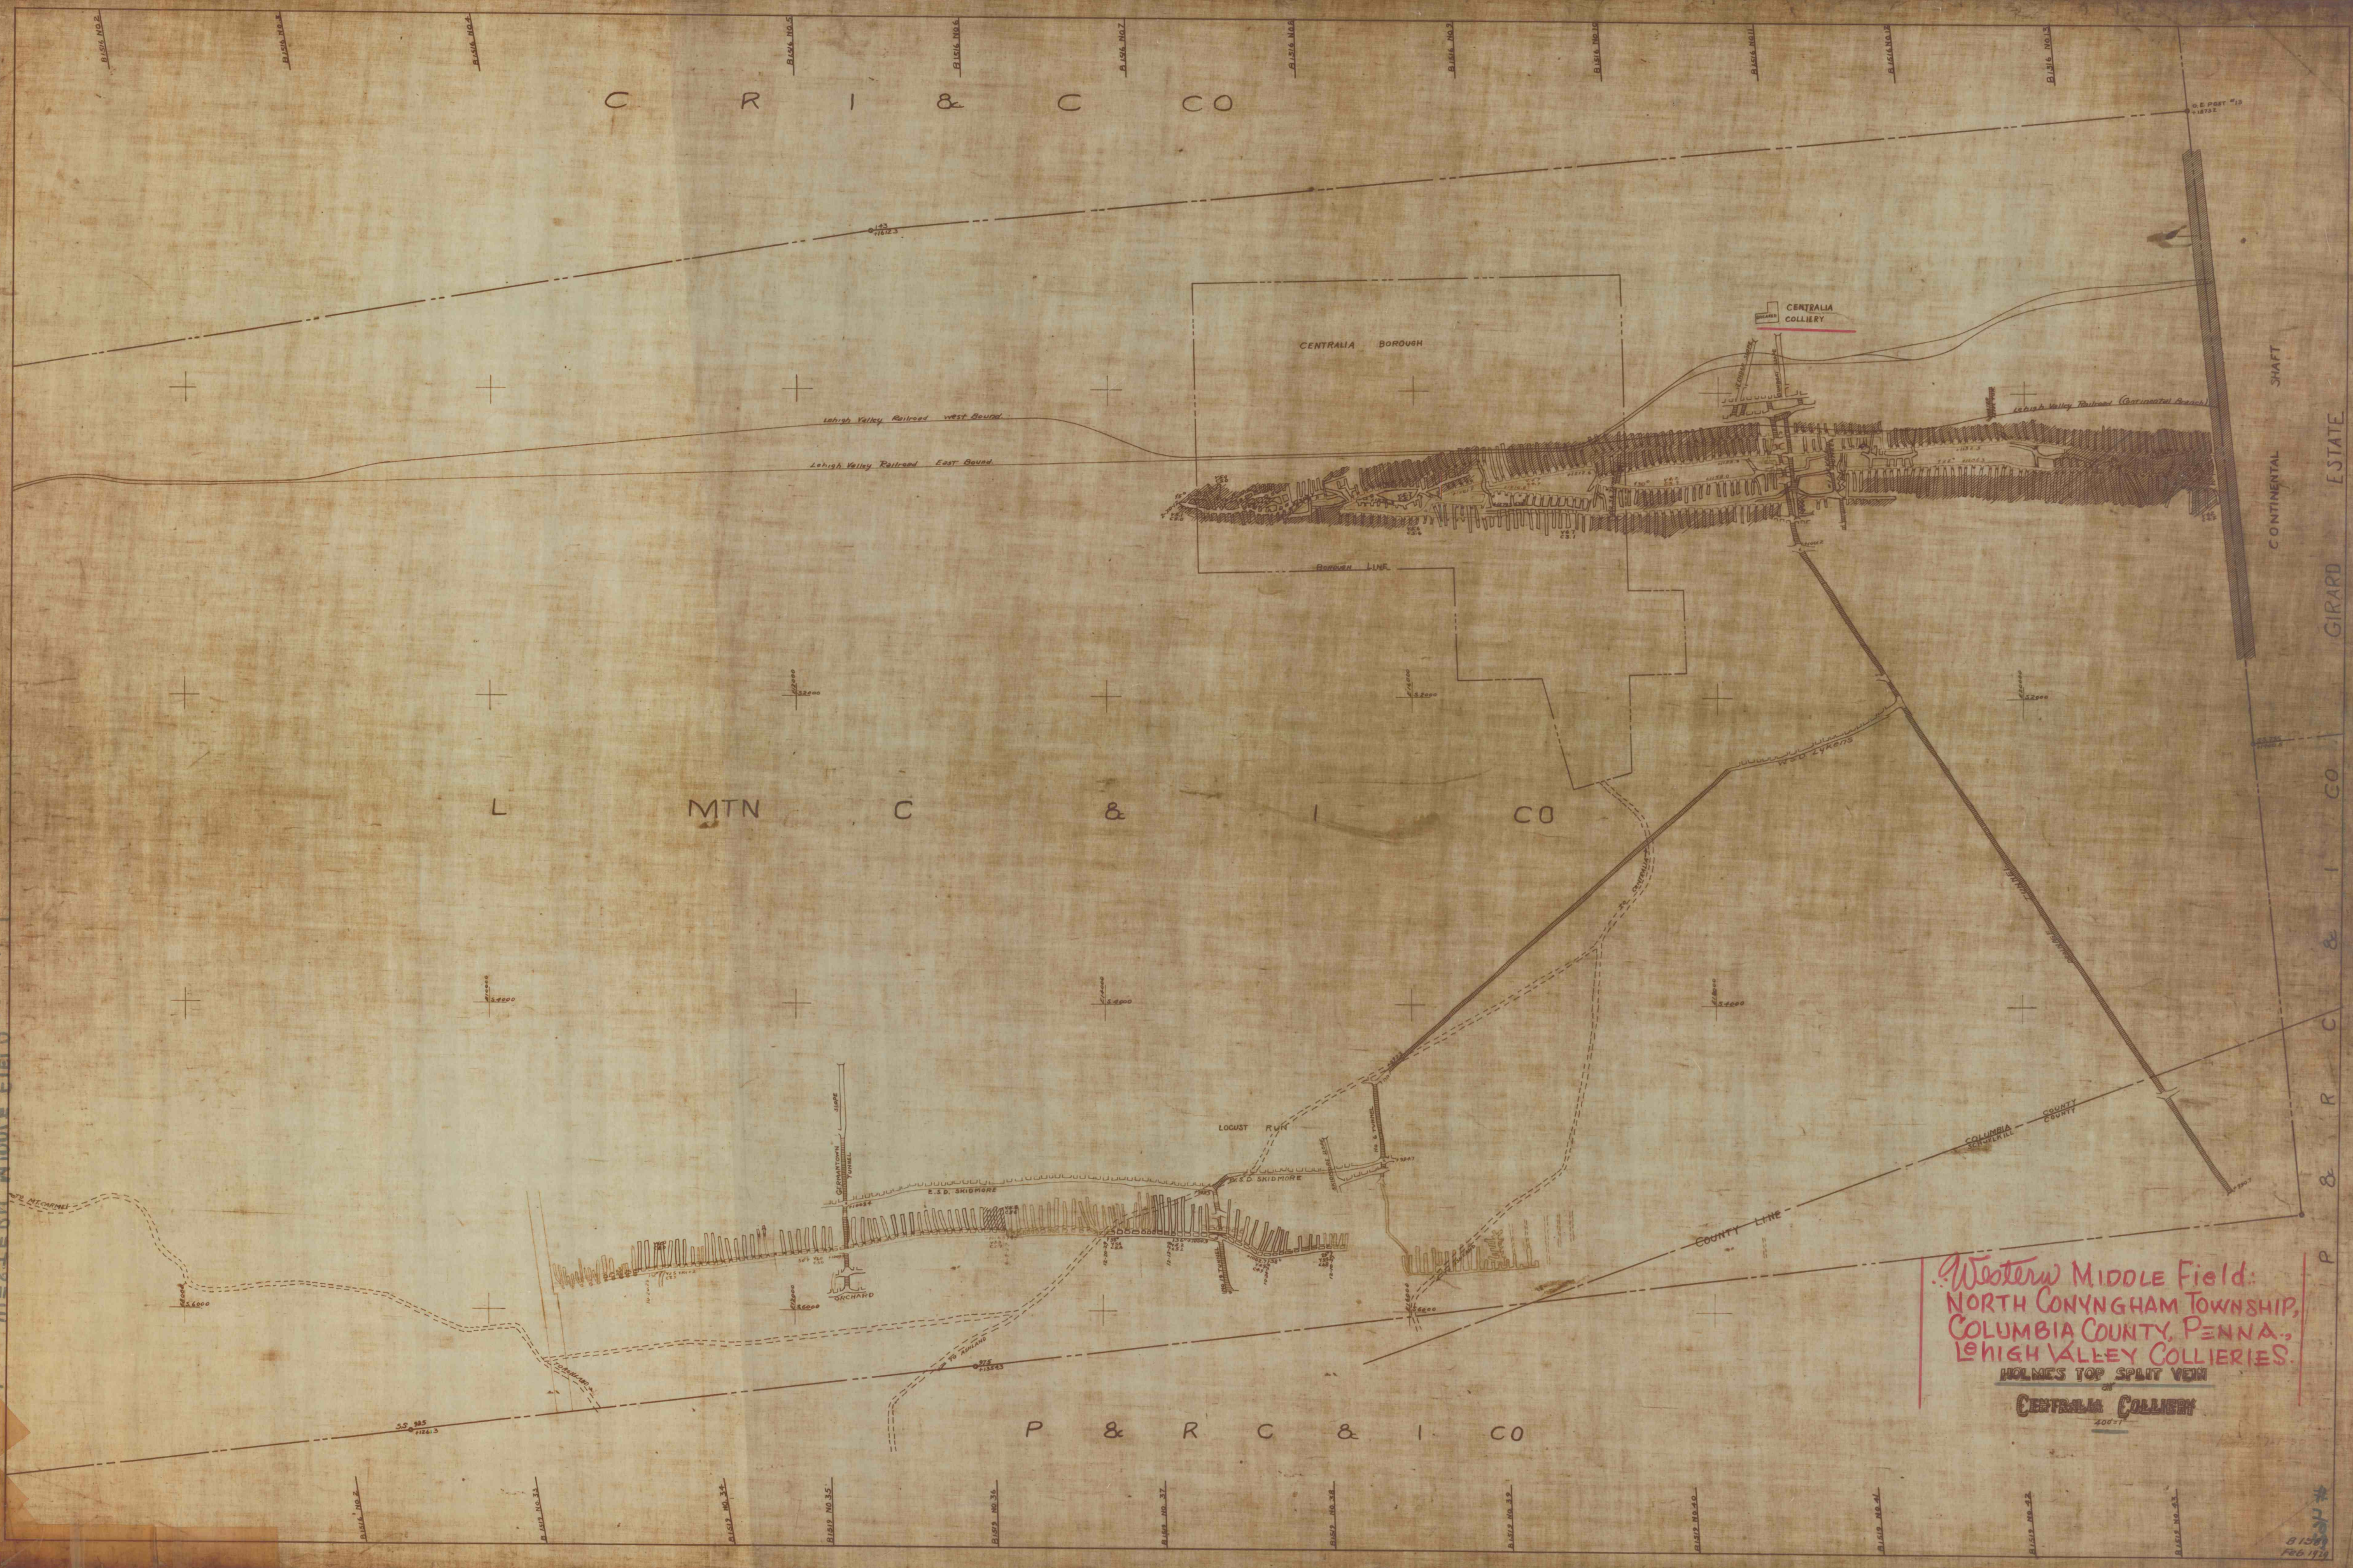

Western Middle Field:
NORTH CONYNHAM TOWNSHIP,
COLUMBIA COUNTY, PENNA.,
LEHIGH VALLEY COLLIERIES.
HOLMES TOP SPLIT VEIN
CENTRALIA COLLIERY

81504
Feb 1919