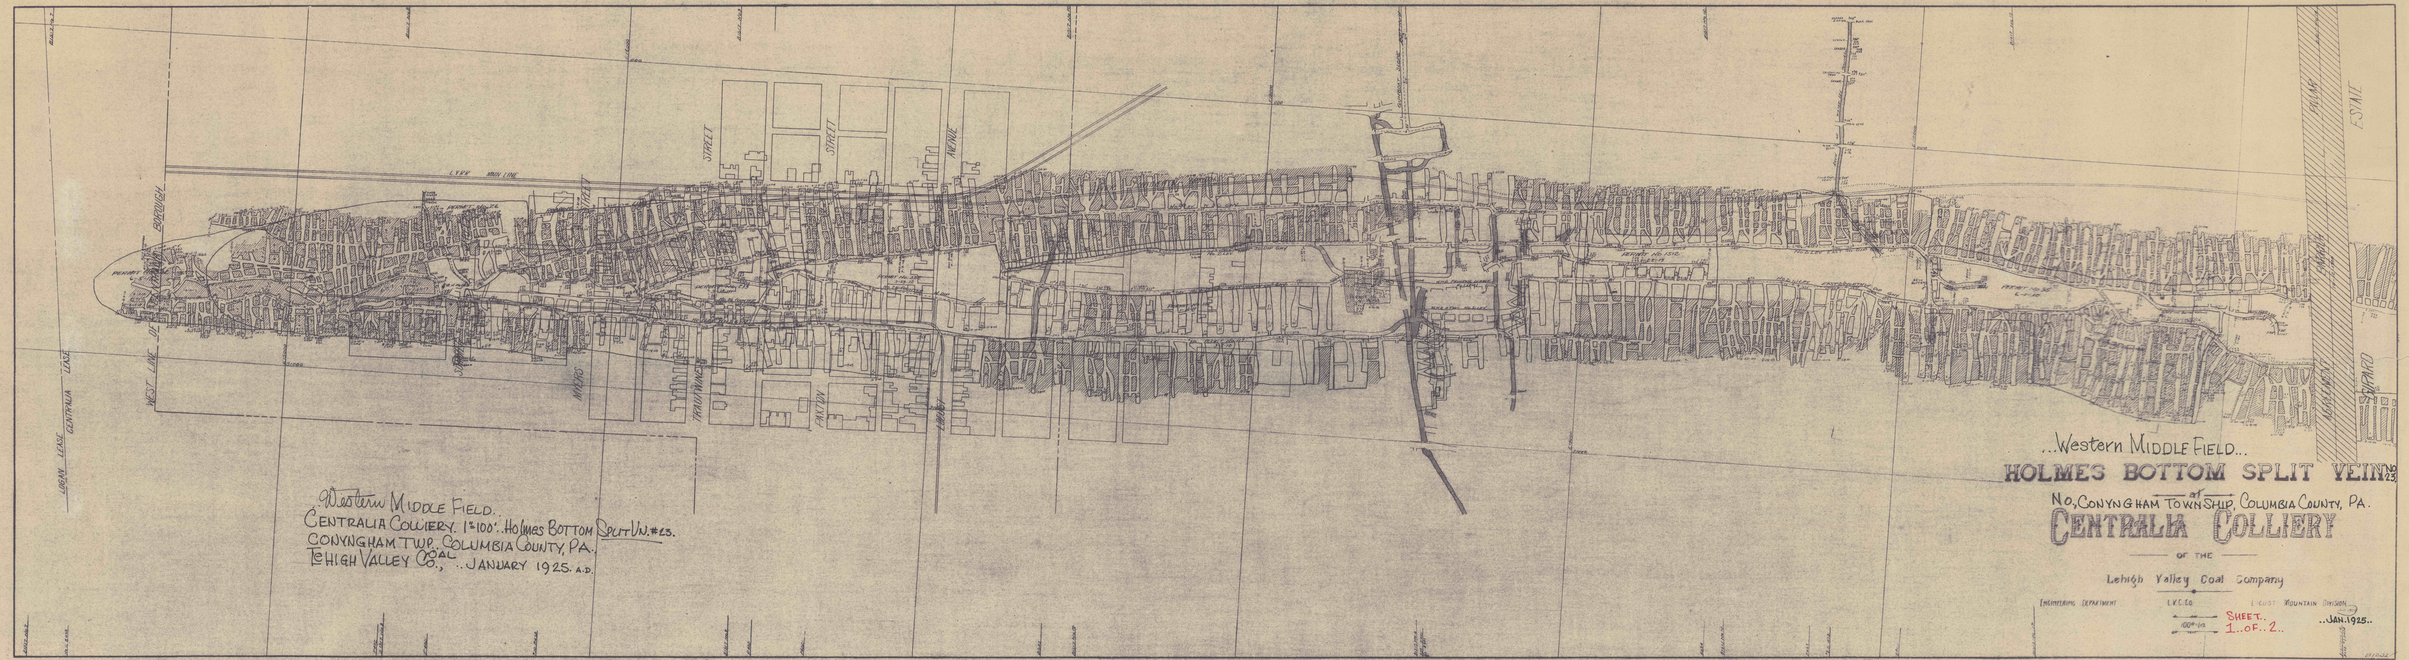

...Western Middle Field...
HOLMES BOTTOM SPLIT VEIN No. 23
No. Conyngham Township, Columbia County, Pa.
CENTRALIA COLLIERY
OF THE
Lehigh Valley Coal Company
Engineering Department
L.V.C.Co.
East Mountain Division
Coal Co.
SHEET.
1..OF..2..
..JAN. 1925..
...Western Middle Field...
CENTRALIA COLLIERY. 1"=100'. HOLMES BOTTOM SPLIT VN. #23.
CONYNGHAM TWP. COLUMBIA COUNTY, PA.
LEHIGH VALLEY COAL CO., ..JANUARY 1925. A.D.
LEHIGH VALLEY
STREET
AVENUE
WEST LINE OF BOROUGH
LEASE
CENTRALIA
LEASE
LINE
MINERS
TRANSMINES
FACTION
LINE
ST. NAT.
RIVER
CANAL
CENTRALIA - HOLMES-BOTTOM SPLIT NO 23