


Coates Coal Co. Inc.
 Centralia Colliery
 Plan & Cross Section Showing Mining In & To Houses
 In Vicinity Of East Borough Line
 Scale 1" = 100' - 312-60-By C.E. Wills, R.P.E. 2293
 5-20-61

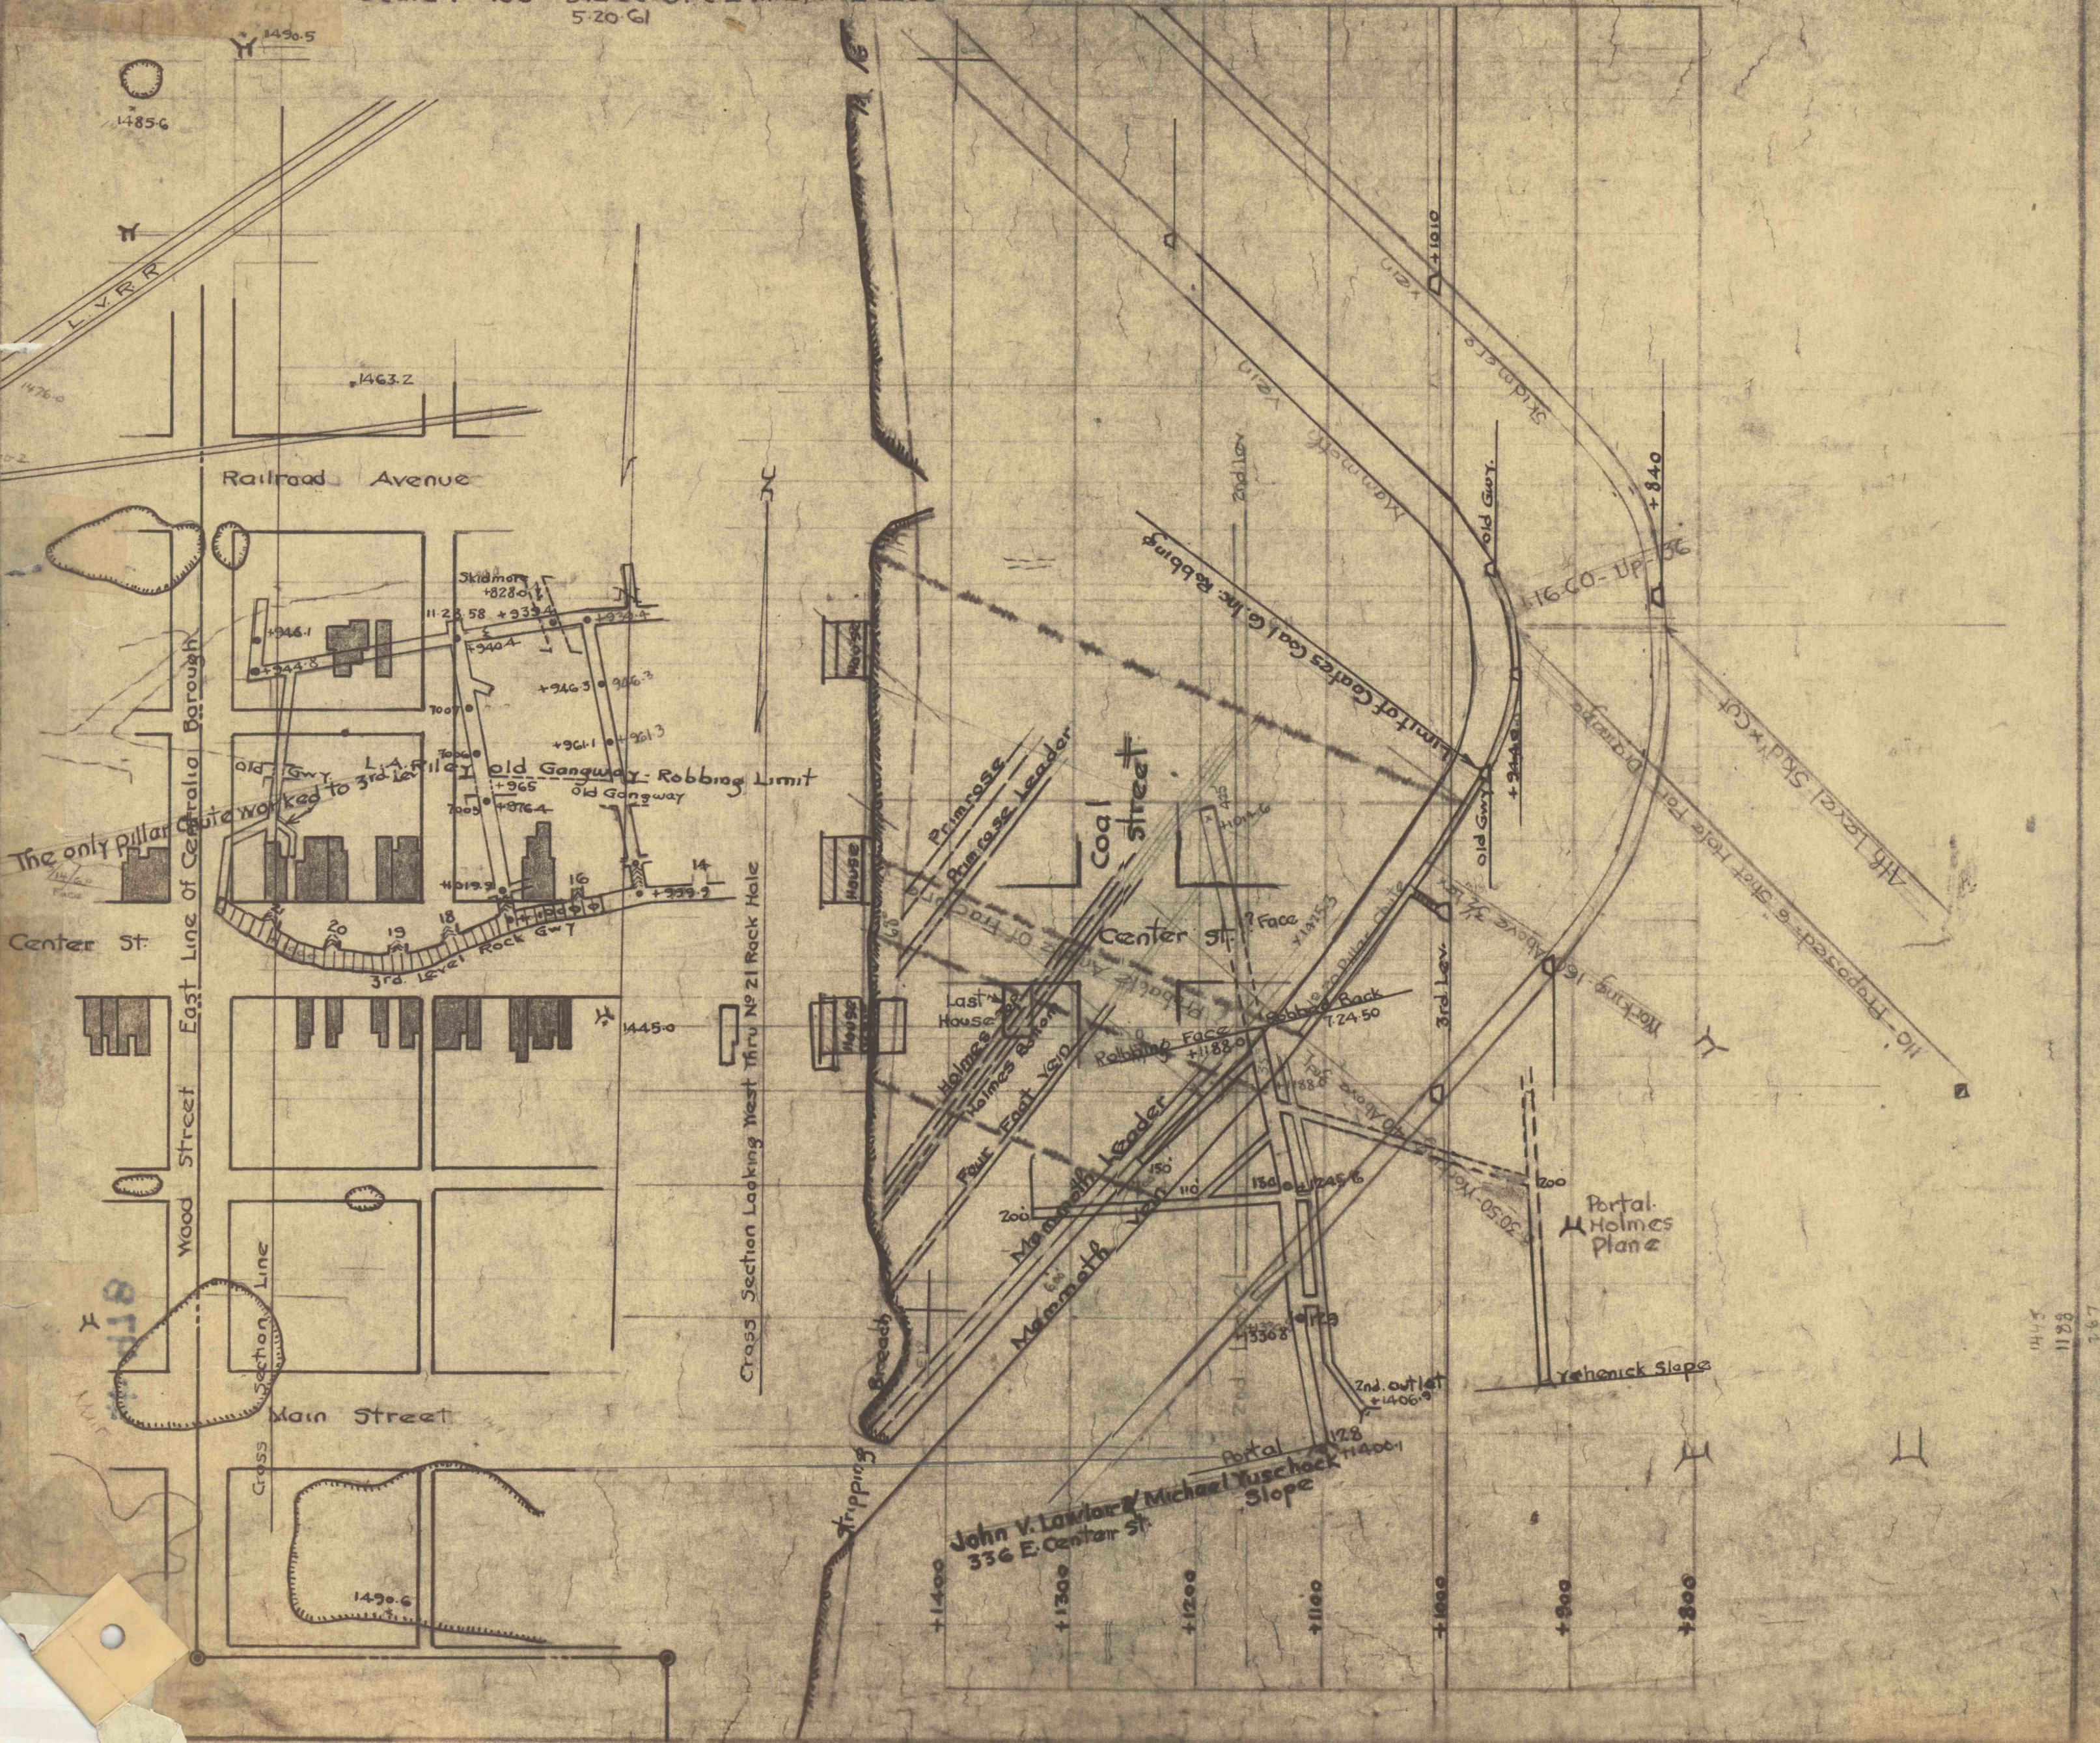

1183
 267