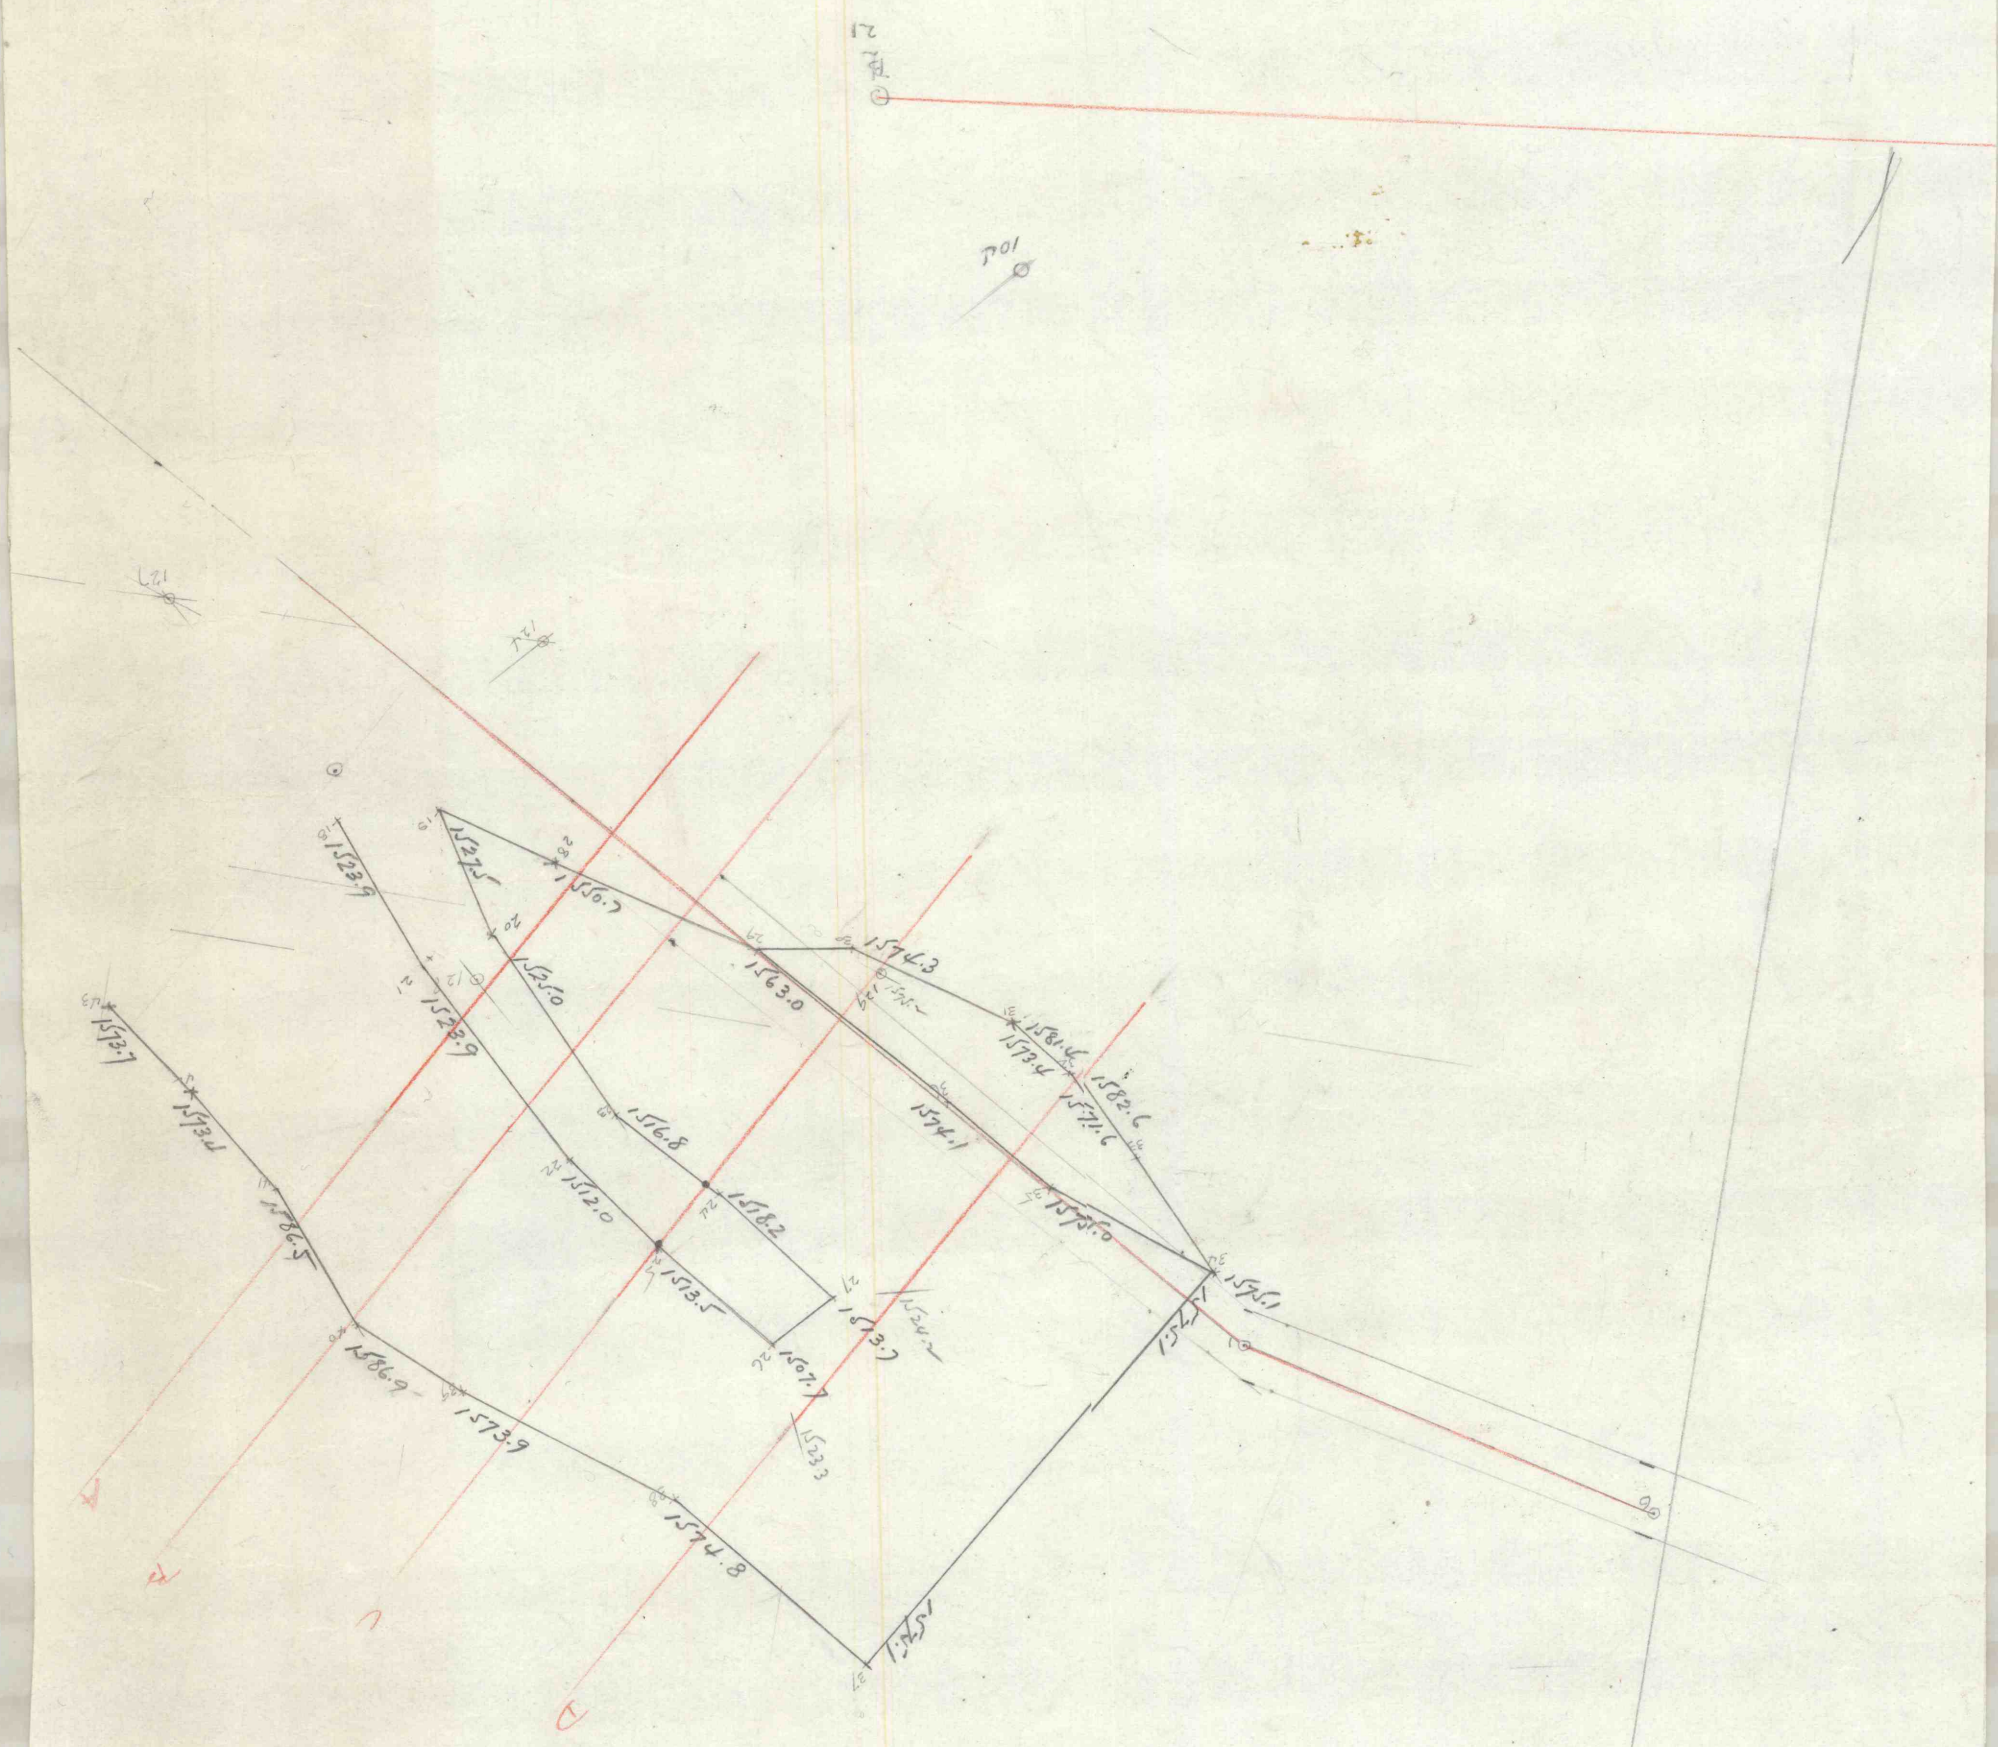

Centralia Mine Fire
Project No AS-32
Surveyed Sept 3. 1963.
Estimate No 2 2nd half of Aug 1963