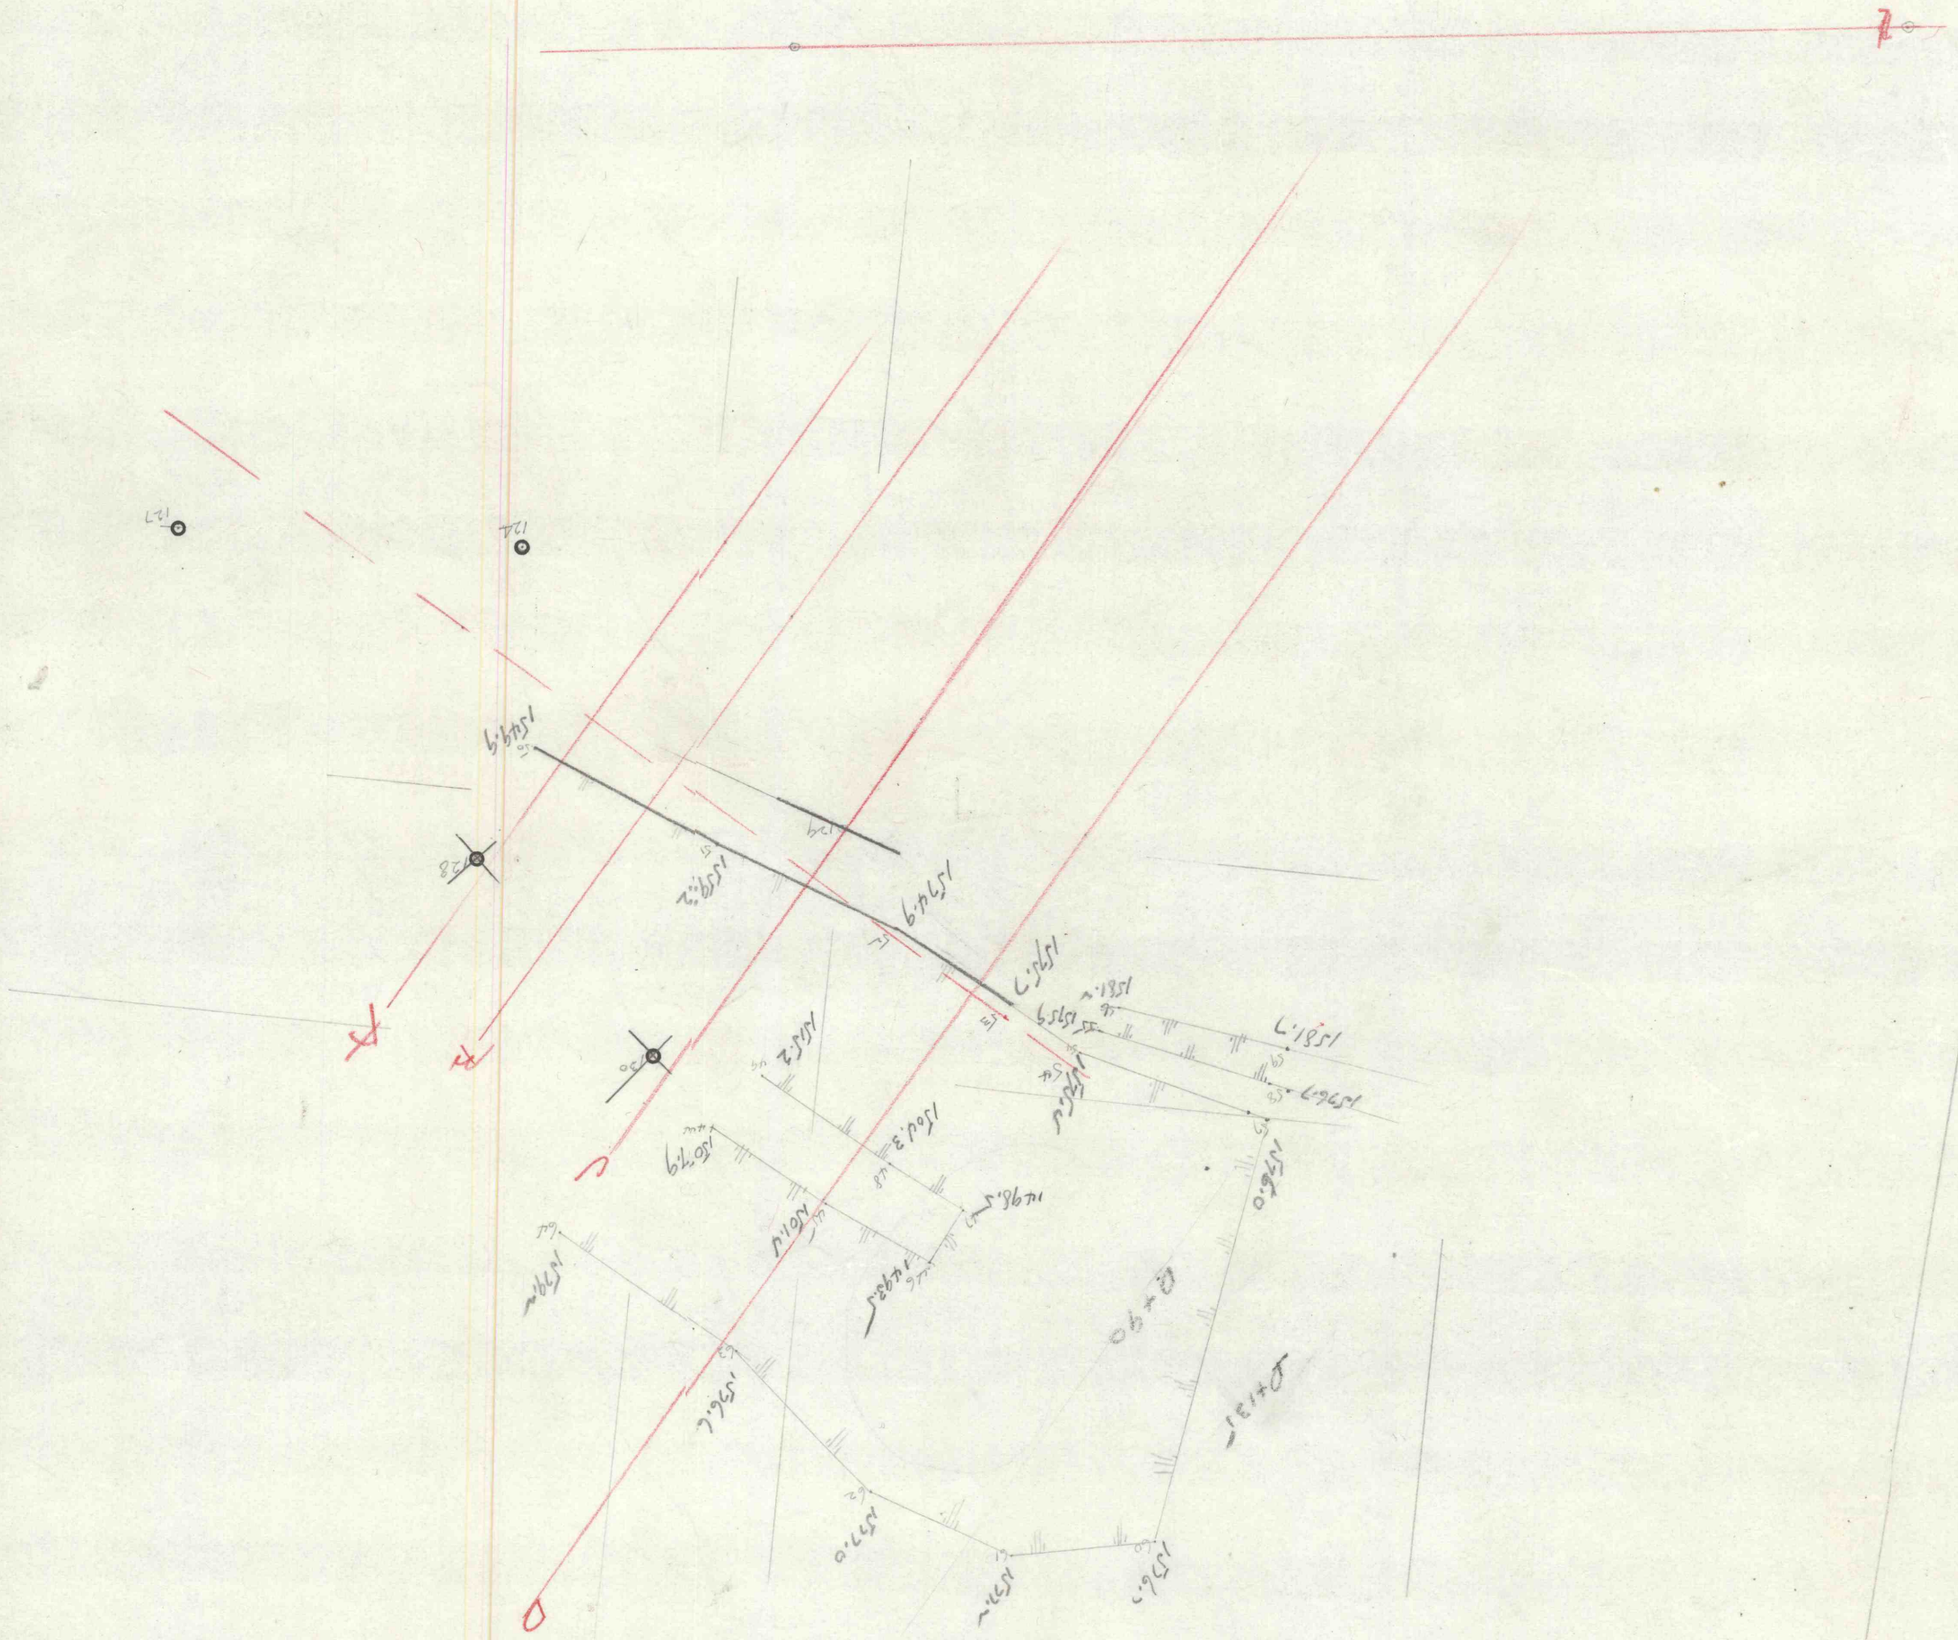

Centralia Mine Fire
Project No AS-32
Surveyed Sept 16.1963
Estimate No 3 1st Half of Sept

Pg-