


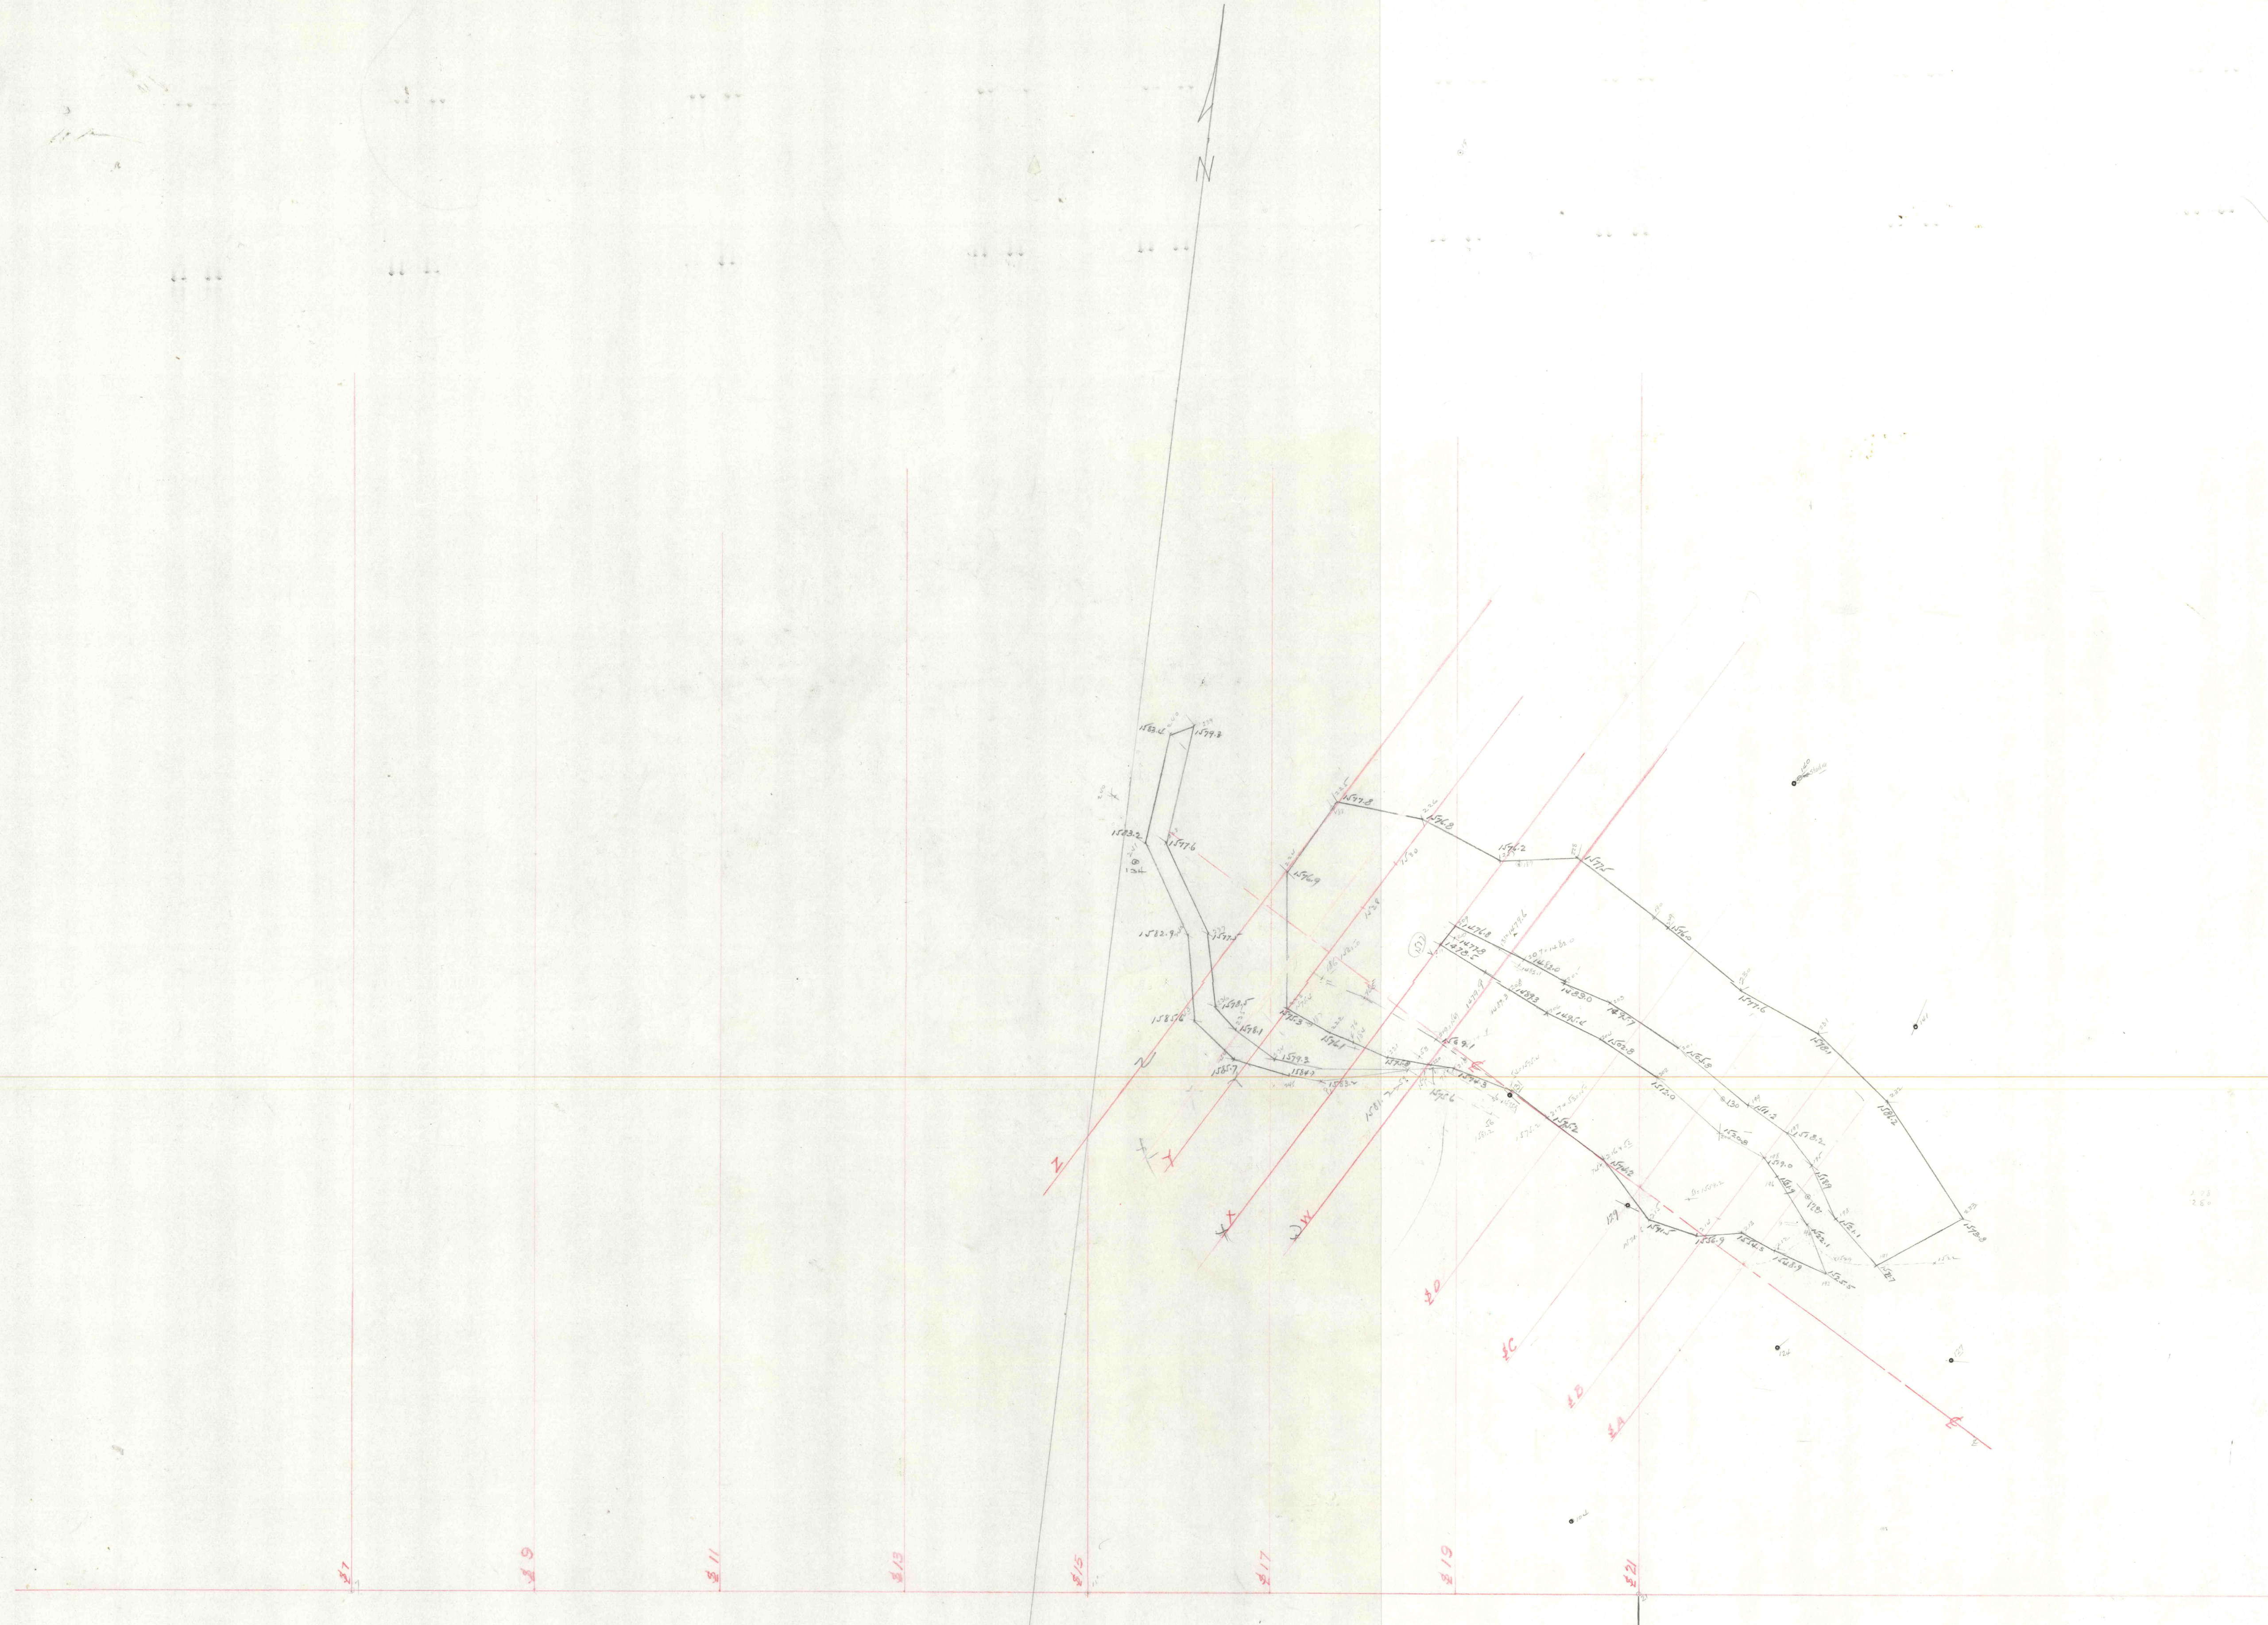

Centralia Mine Fire
Project N° AS-32
Surveyed Thru. Oct 10, 1963
Final Estimate N° 5