


Storrs A.V.M.

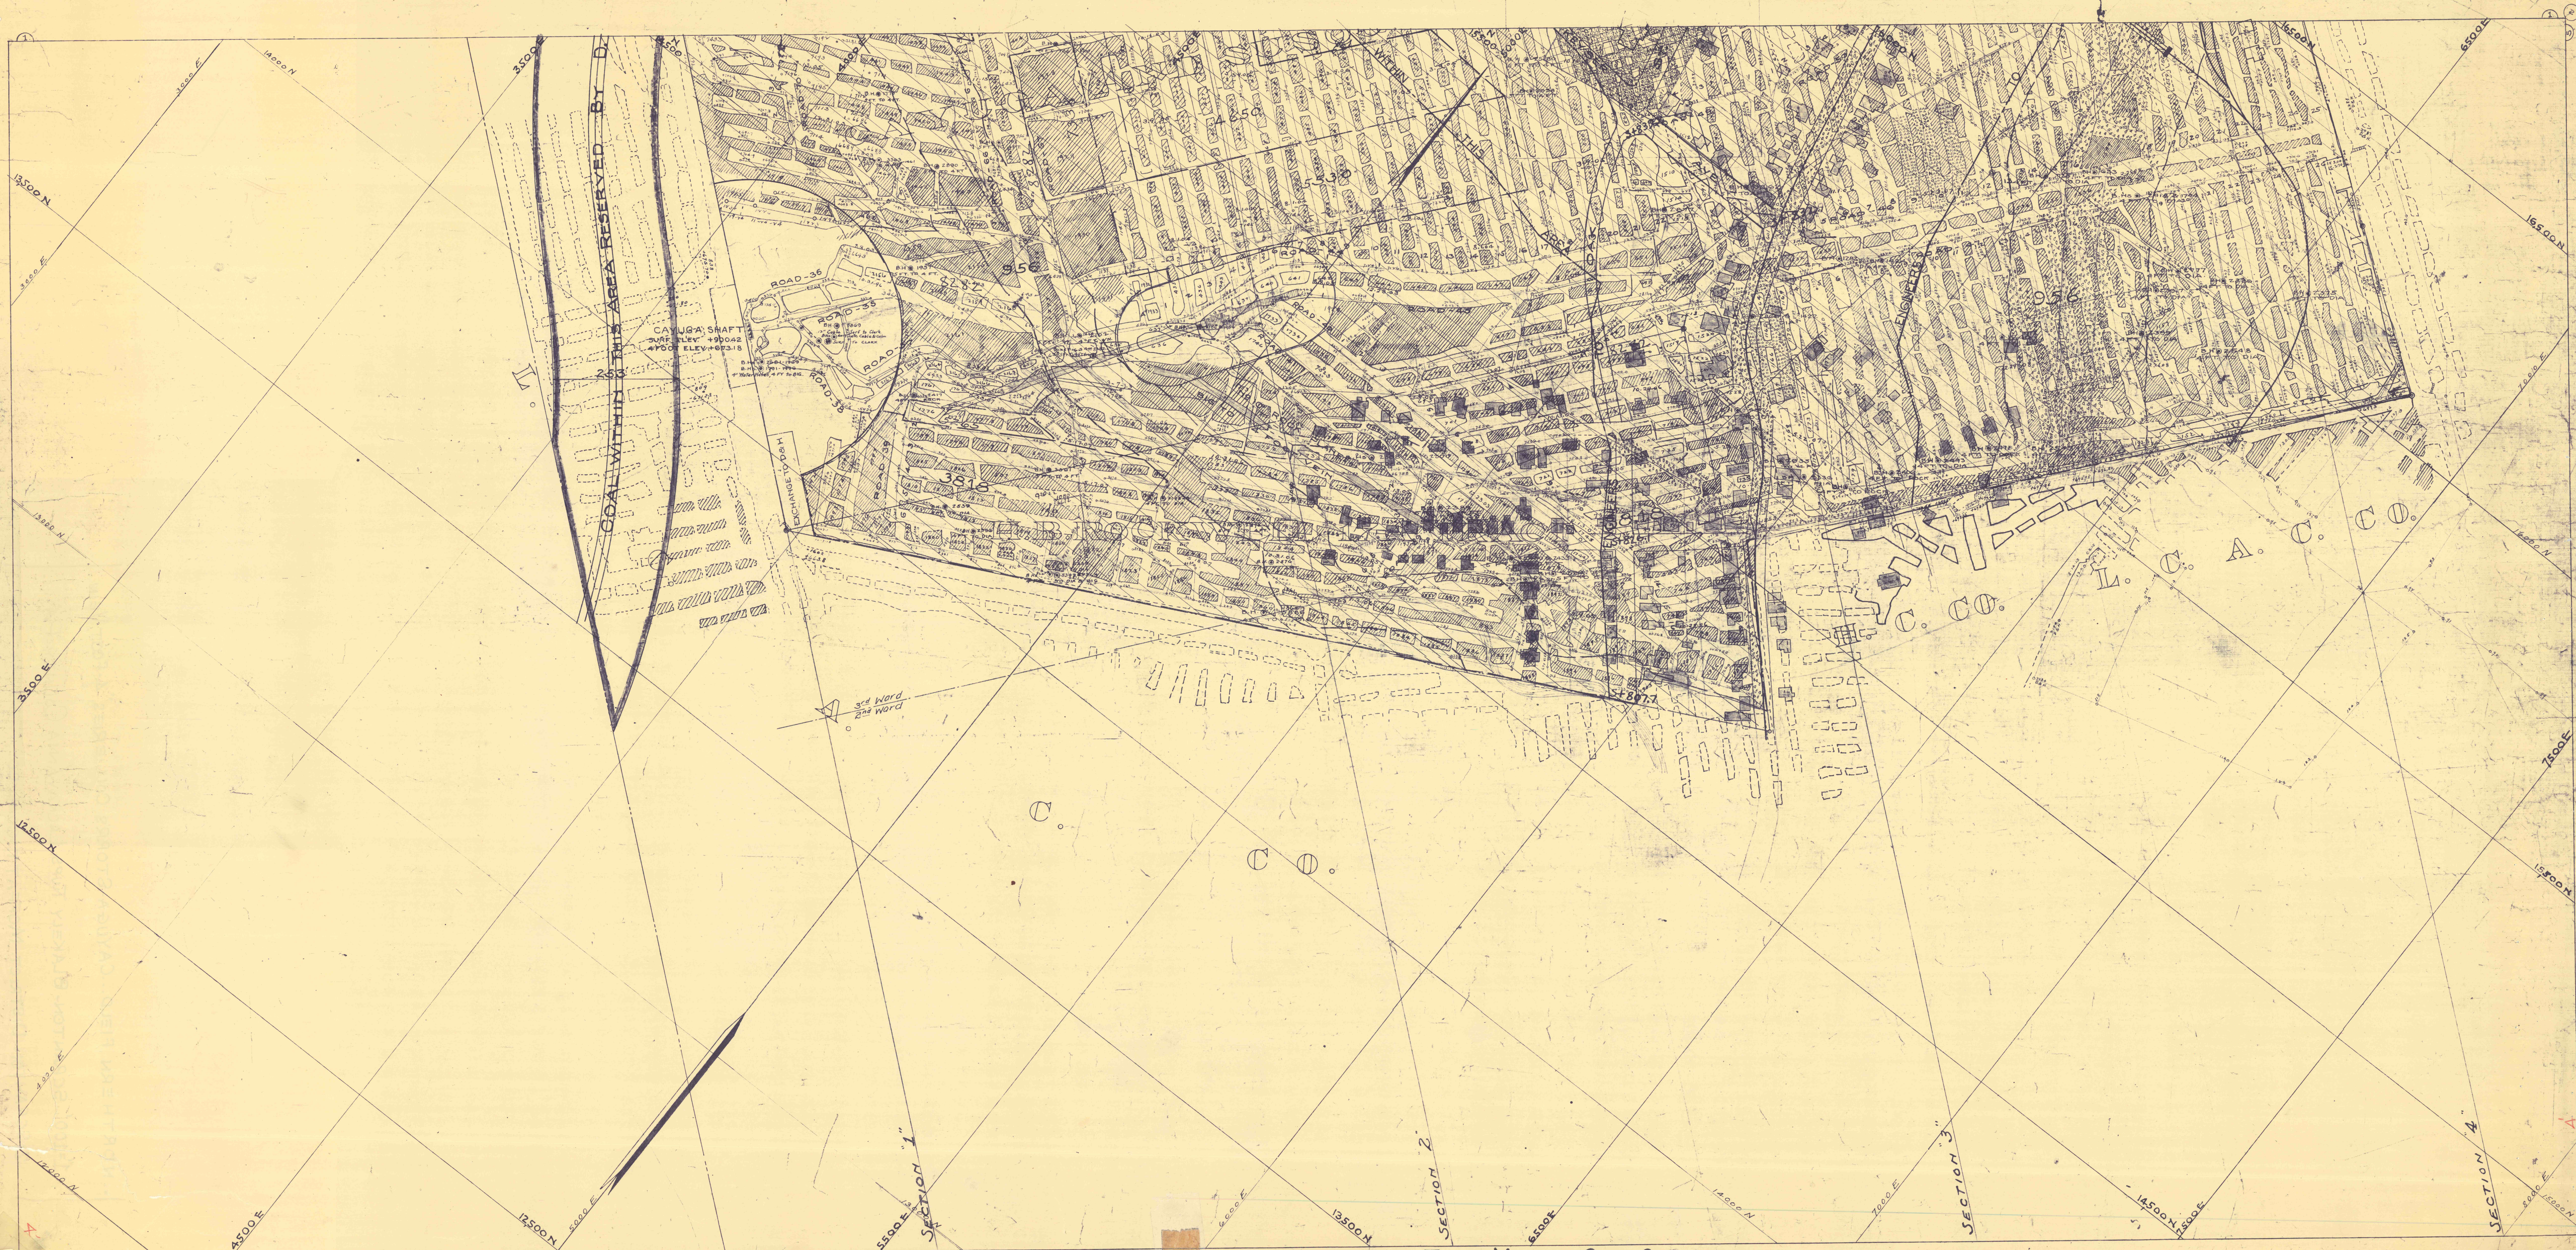

NORTHERN FIELD..1"=100'... SCRANTON-BLAKELY TWPS..MOFFATT COAL CO..
LACKAWANNA CO., PA. SCRANTON..
CAYUGA-STORRS-FOUR FOOT VEIN-INACTIVE JULY 1959..