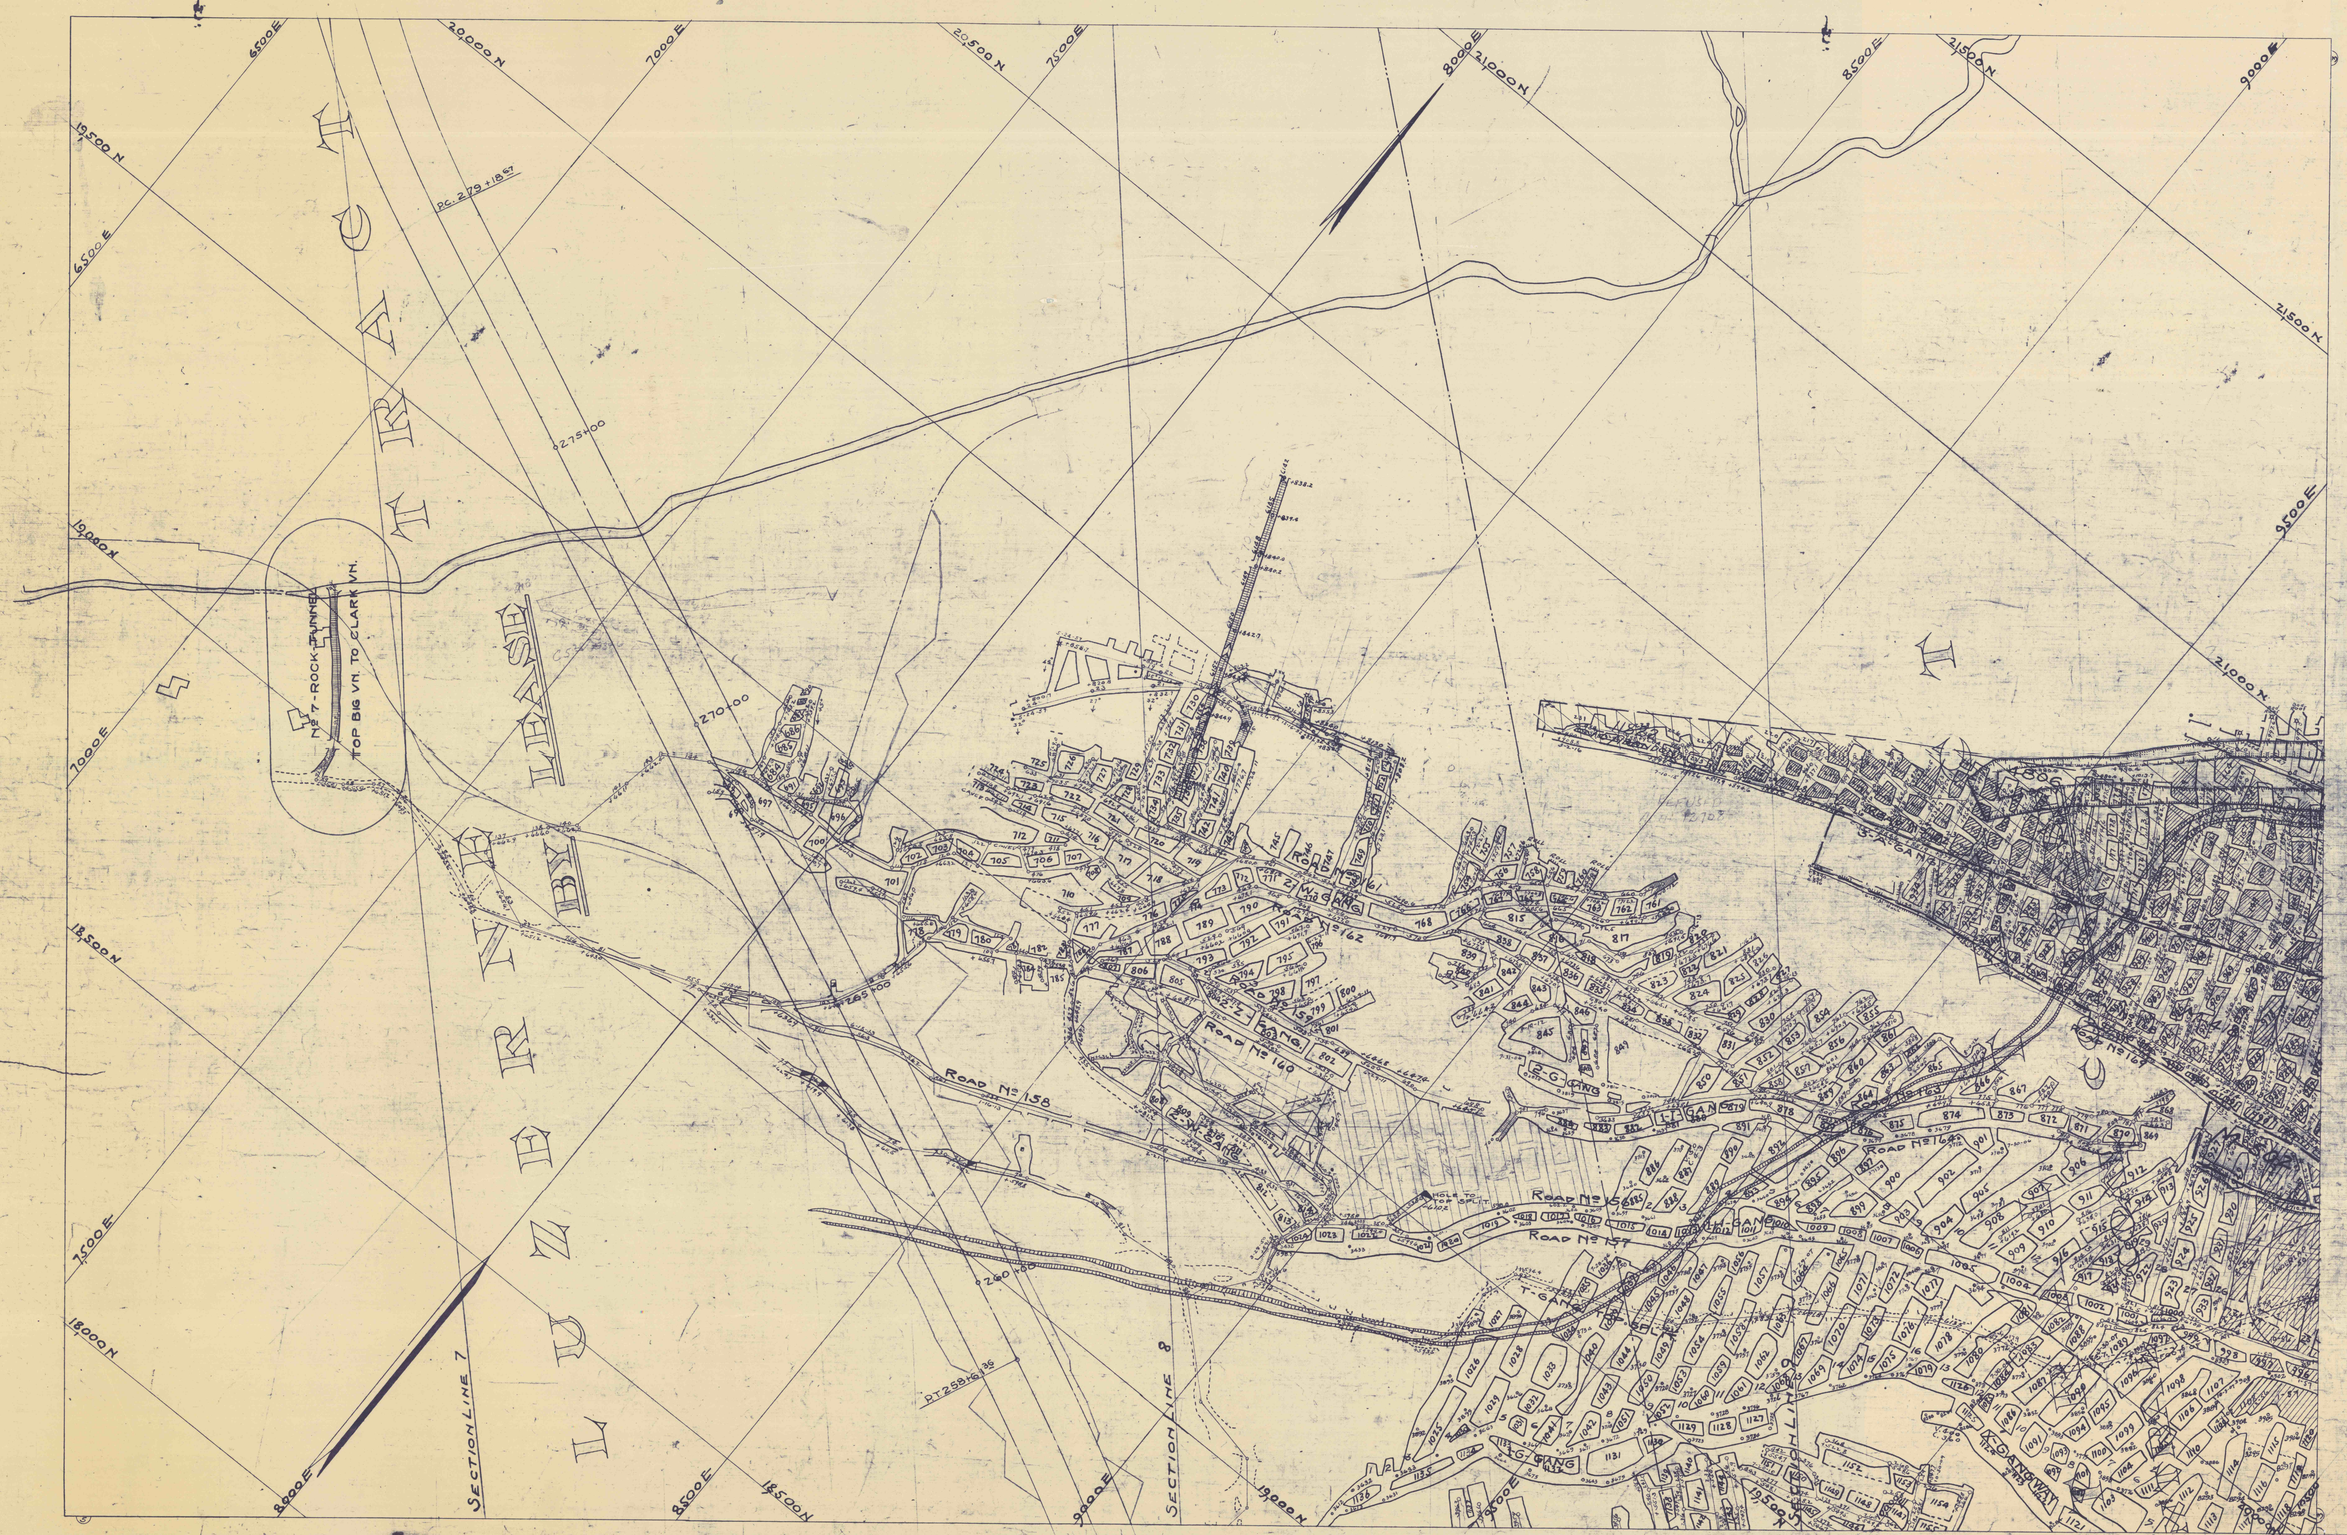
NORTHERN FIELD 1"=100'
CAYUGA-STORRS-BIG BOT. VEIN
COLLIERIES...MOFFATT COAL CO, SCRANTON-BLAKELY TWPS. LACKA. CO, PA.
SECTION LINE 7
SECTION LINE 8
ROAD No 158
ROAD No 160
ROAD No 161
ROAD No 162
ROAD No 163
ROAD No 164
ROAD No 165
ROAD No 166
TOP BIG VN. TO CLARK VN.
PC. 279+18.57
PT 280+16.36
Storrs Big Bottom