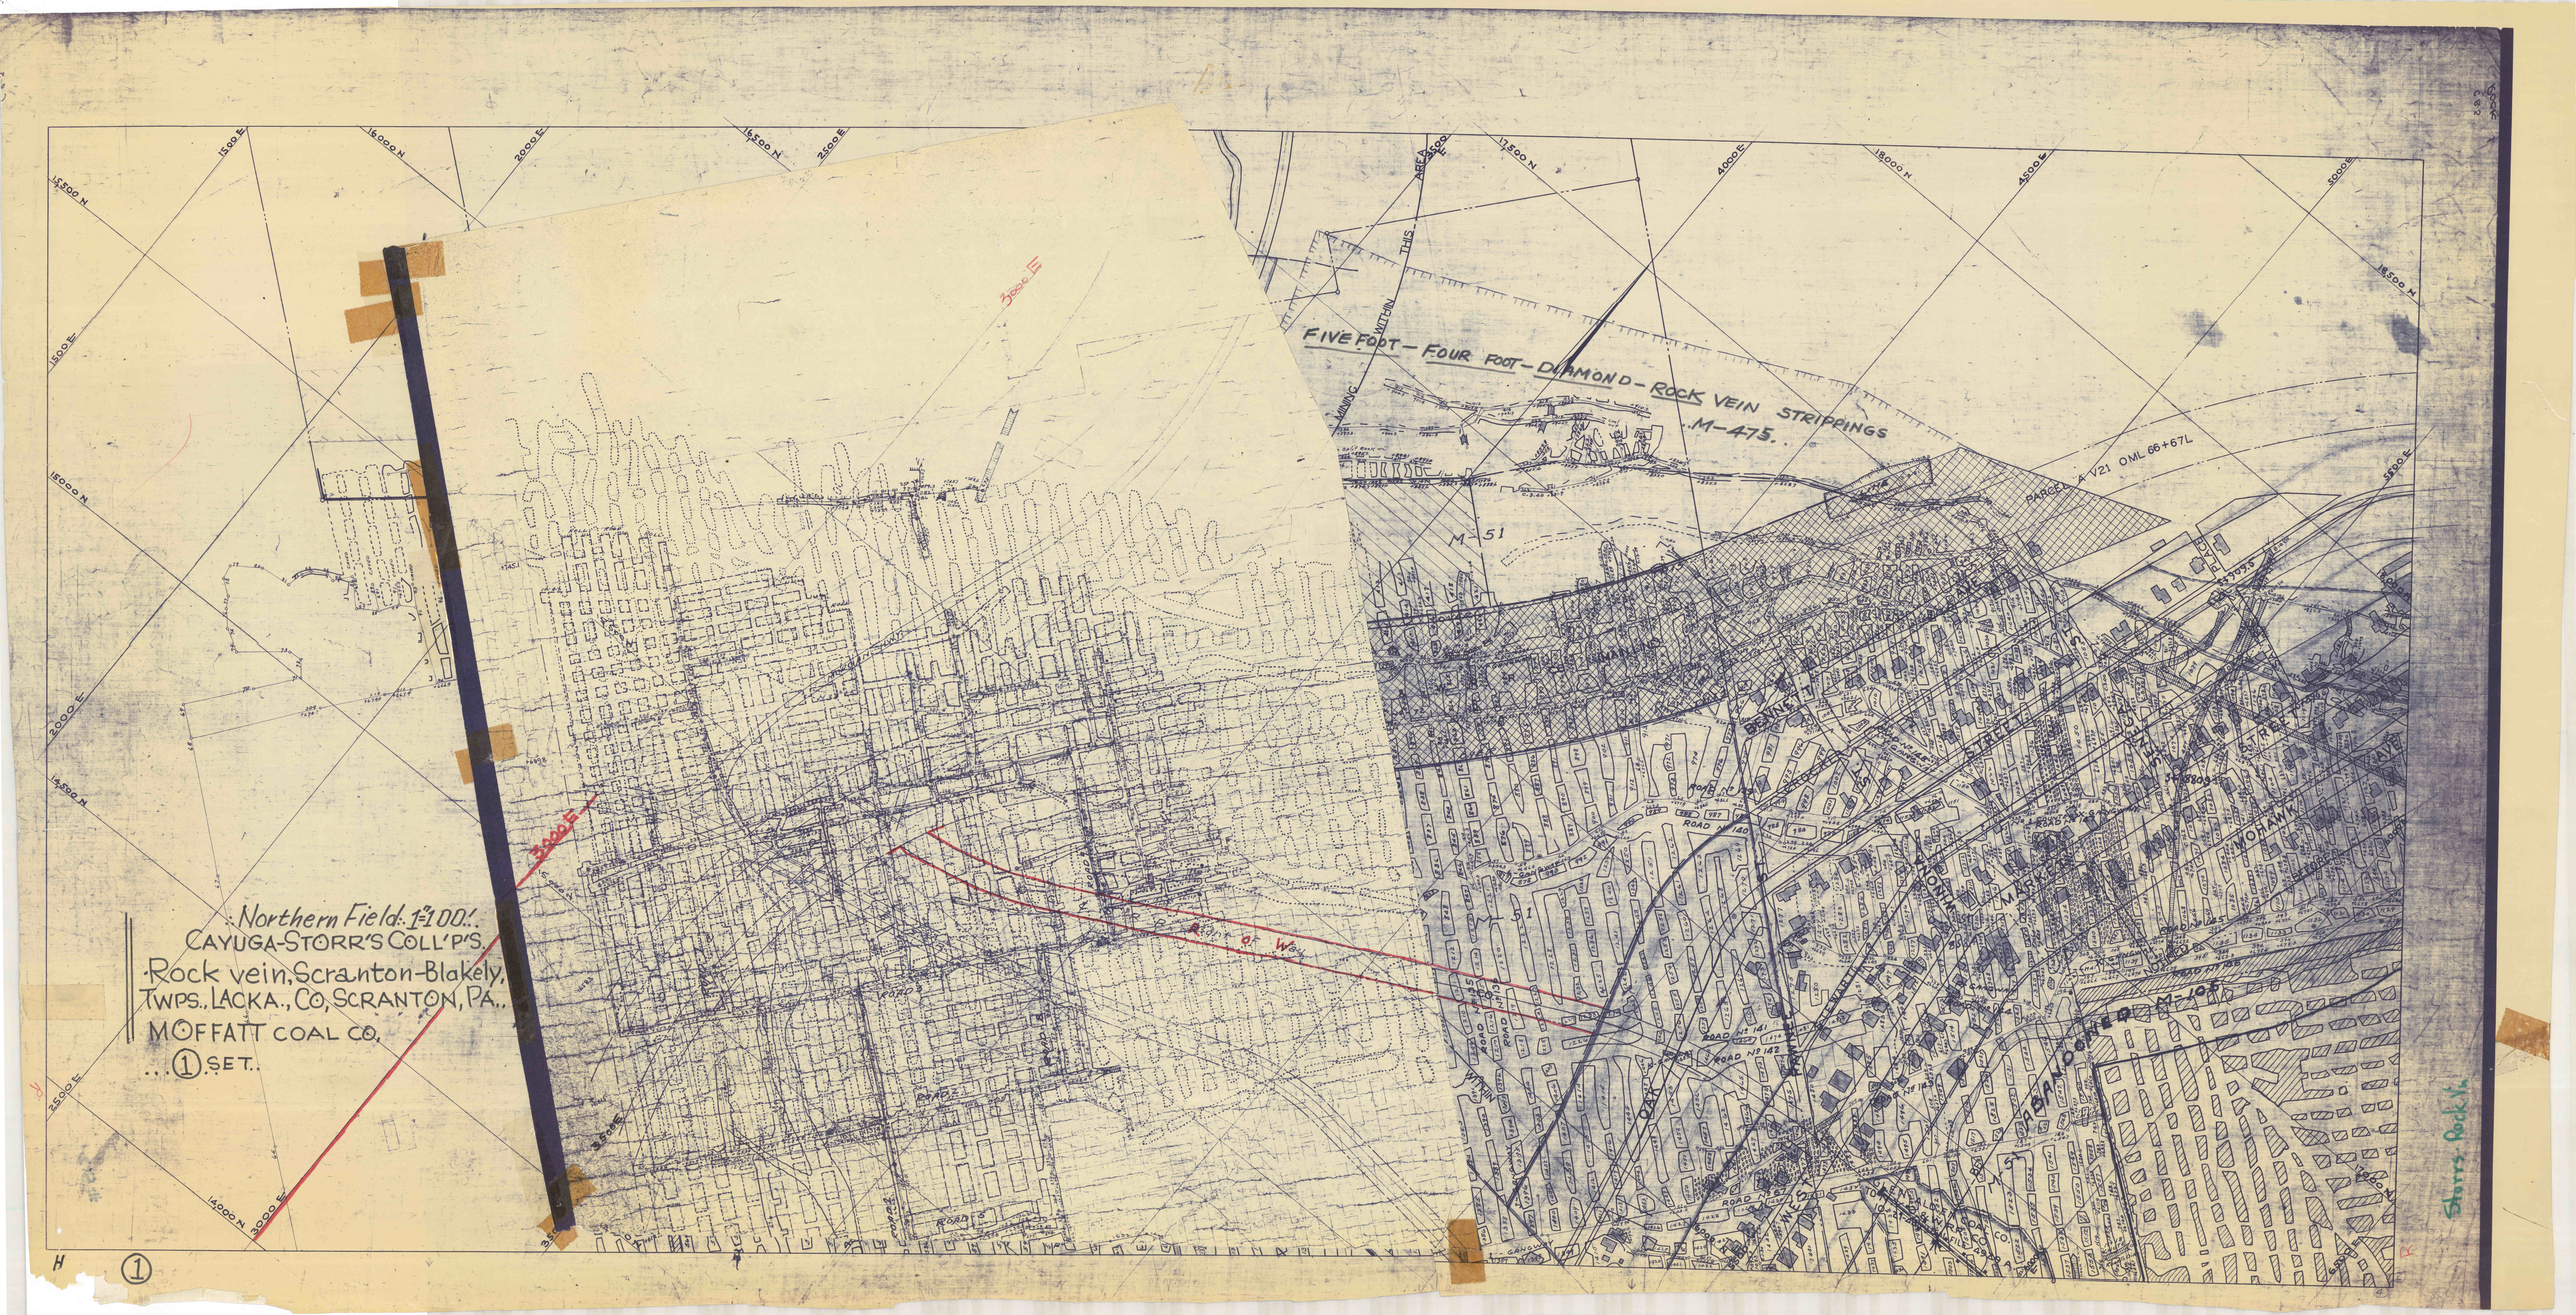

Northern Field: 1"=100'.
CAYUGA-STORR'S COLL'P'S.
Rock vein, Scranton-Blakely,
Twps., LACKA., Co, SCRANTON, PA.,
MOFFATT COAL CO.,
...(1) SET..
FIVE FOOT - FOUR FOOT - DIAMOND - ROCK VEIN STRIPPINGS
M-475.
PARCEL A V21 OML 66+67L
M-51
M-105
ABANDONED
Storrs Rock V.
3500 E
3000 E
2500 E
2000 E
1500 E
16000 N
16500 N
17000 N
17500 N
18000 N
18500 N
4000 E
4500 E
5000 E
5500 E
H
1