


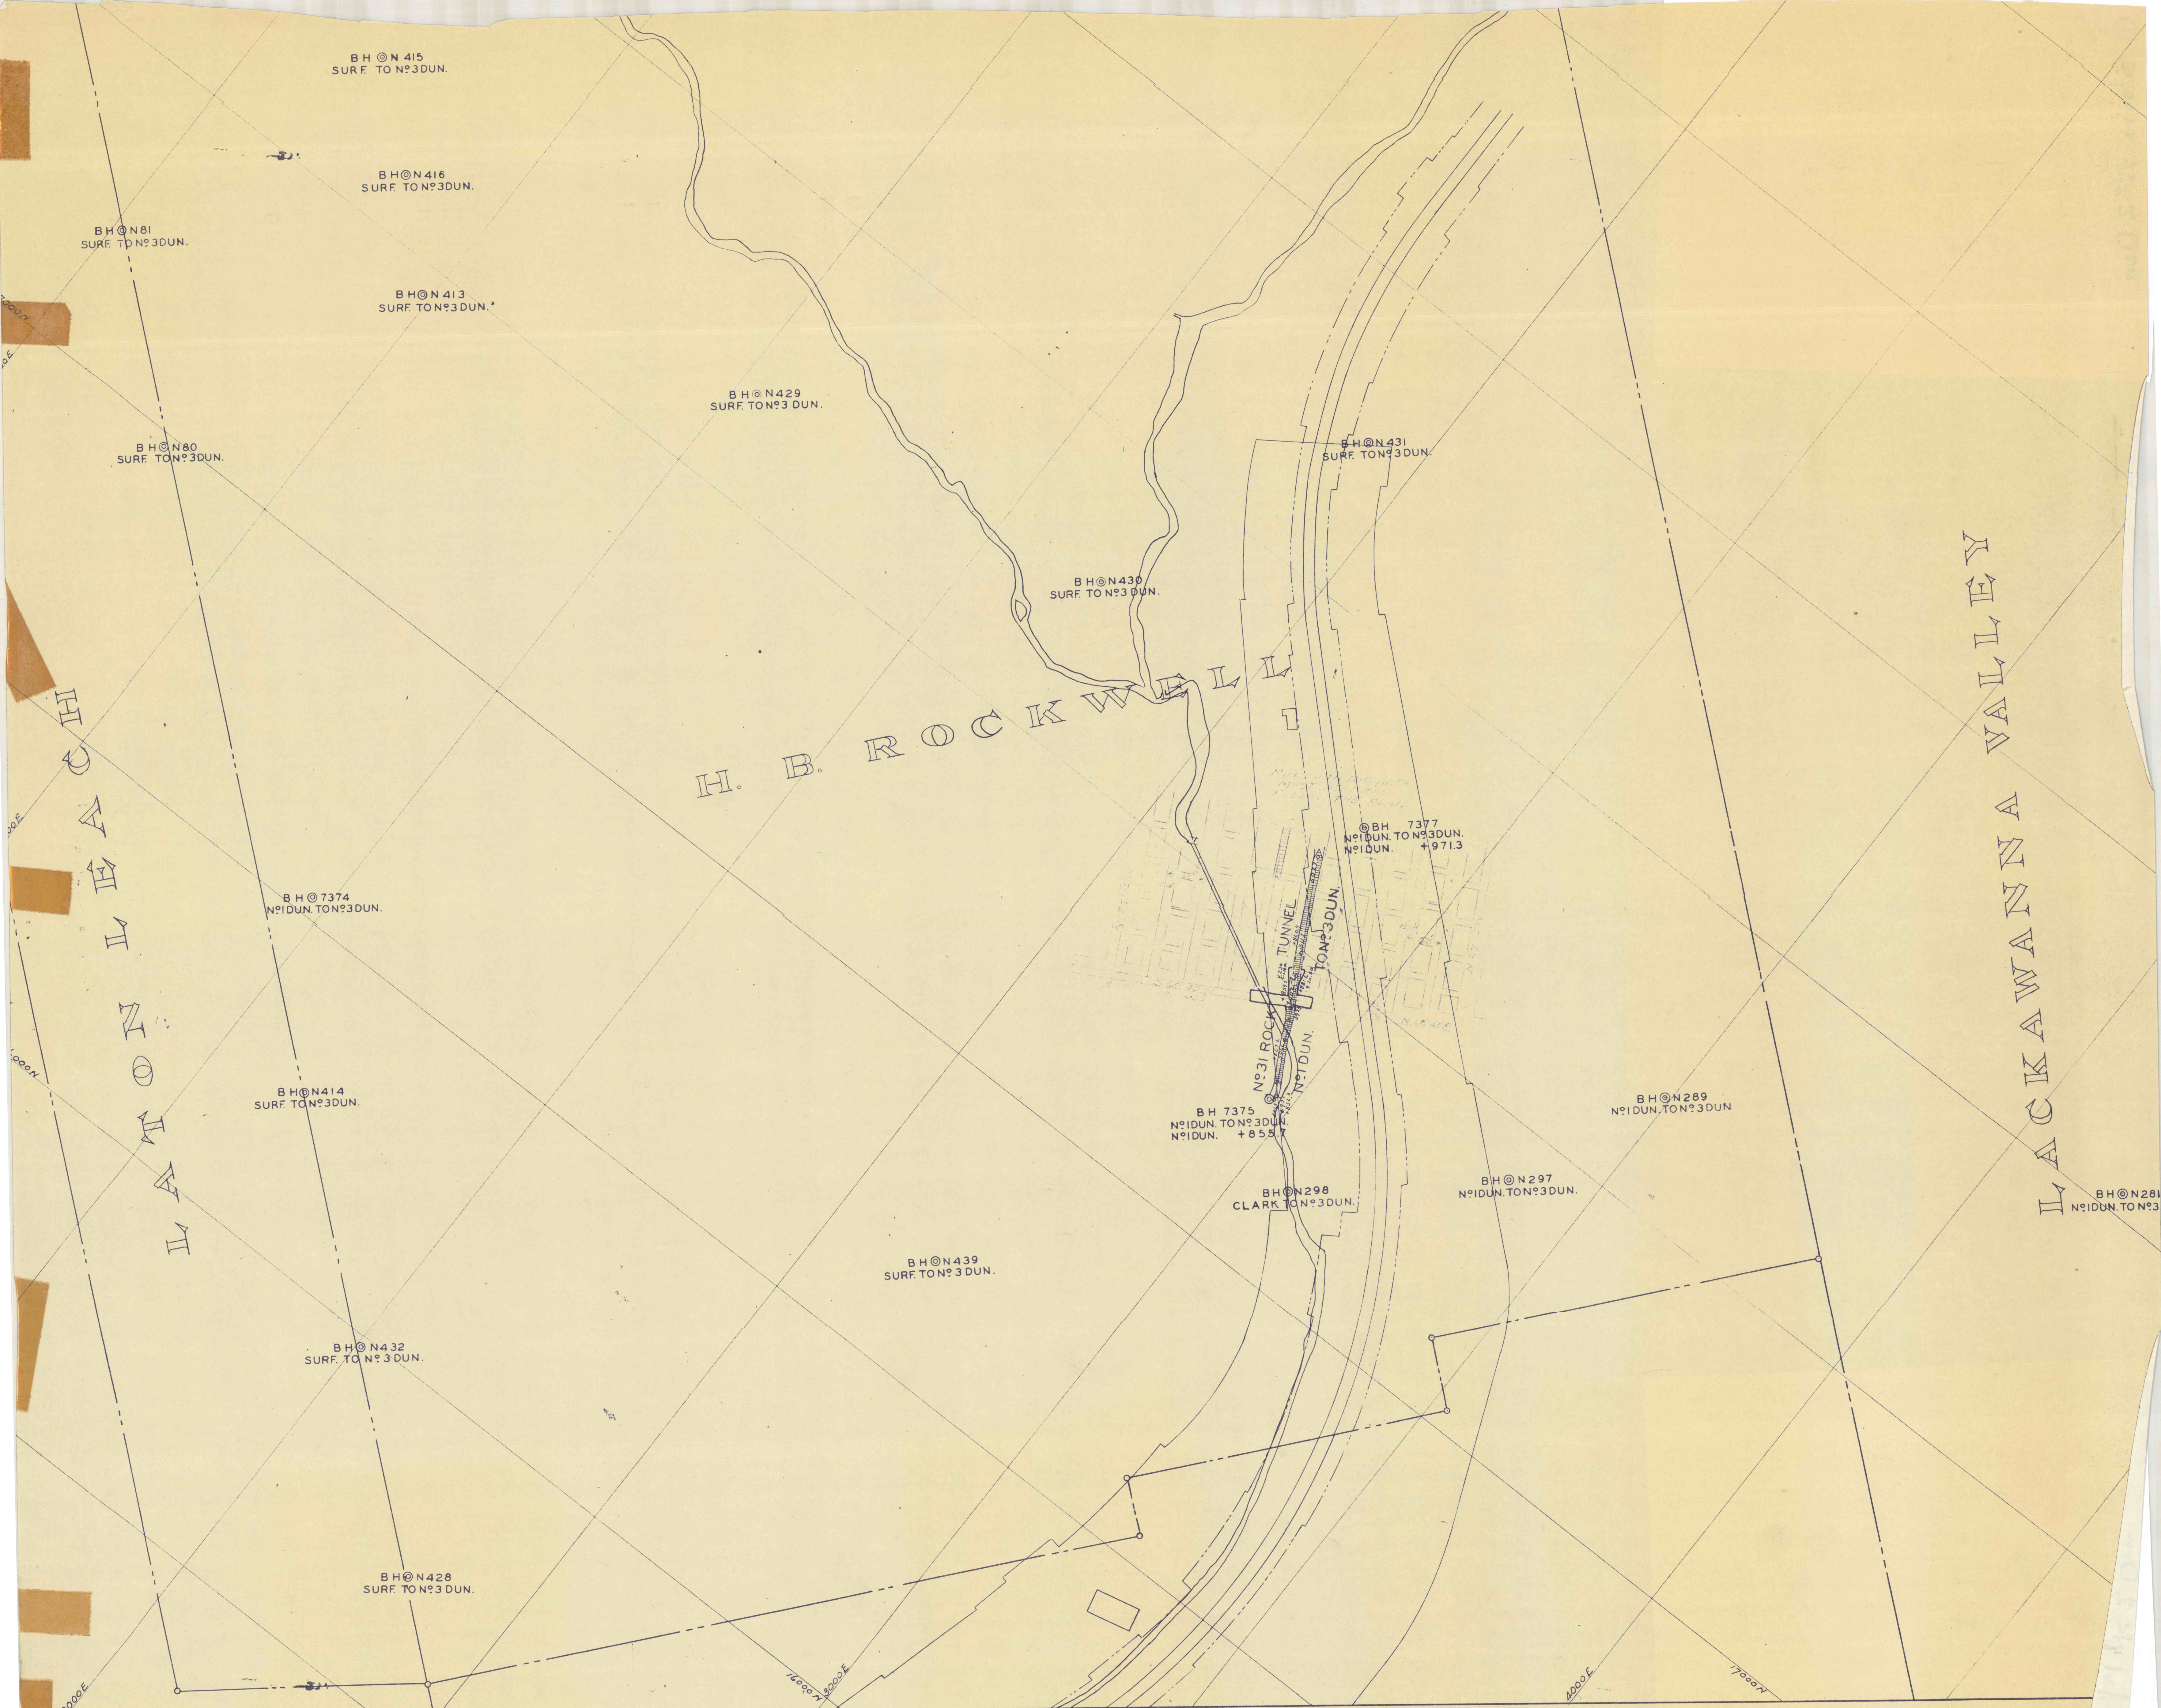

NORTHERN COAL FIELD
CAYUGA STORRS COLLIERIES.
..Nº 2 DUNMORE... VEIN... 1100' LACKA, CO, PA.,
SCRANTON-BLAKELY Twps, Moffatt COAL CO.,