


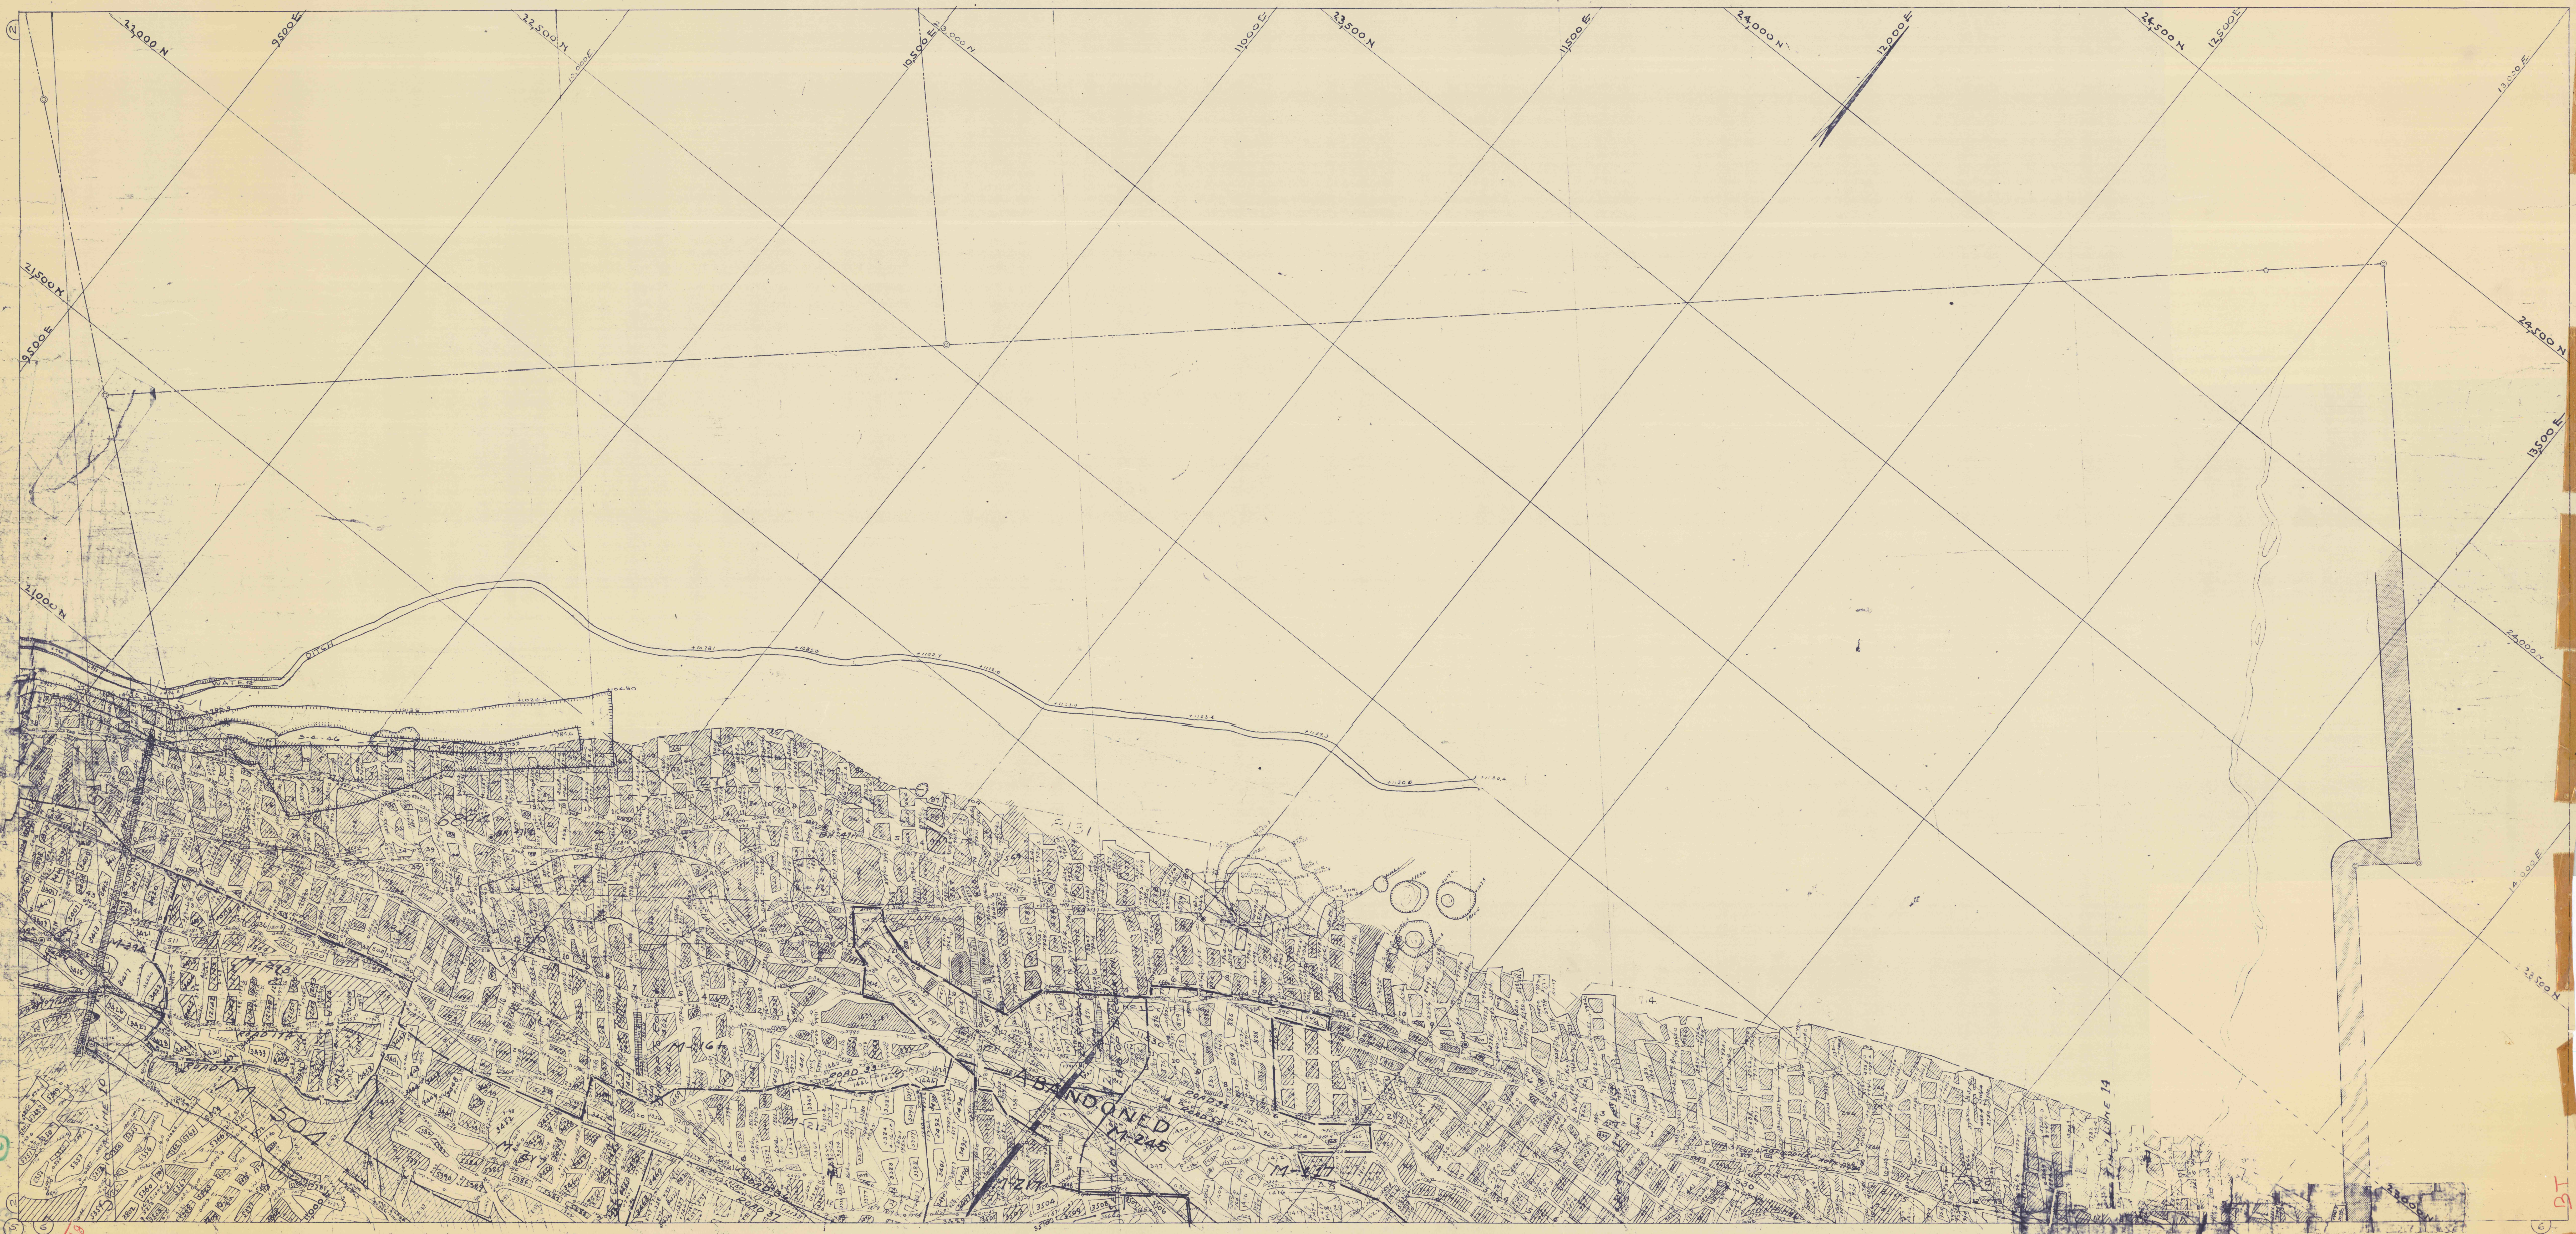

Northern Field.: SCRANTON-BLAKELY Twps. MOFFATT COAL Co..
CAYUGA-STORRS-BIG TOP...VEIN..1"500'
COLLIERIES...LACKAWANNA CO, PA. SCRANTON.

Stores Big Top
③
with lines 10000

BT
F3