


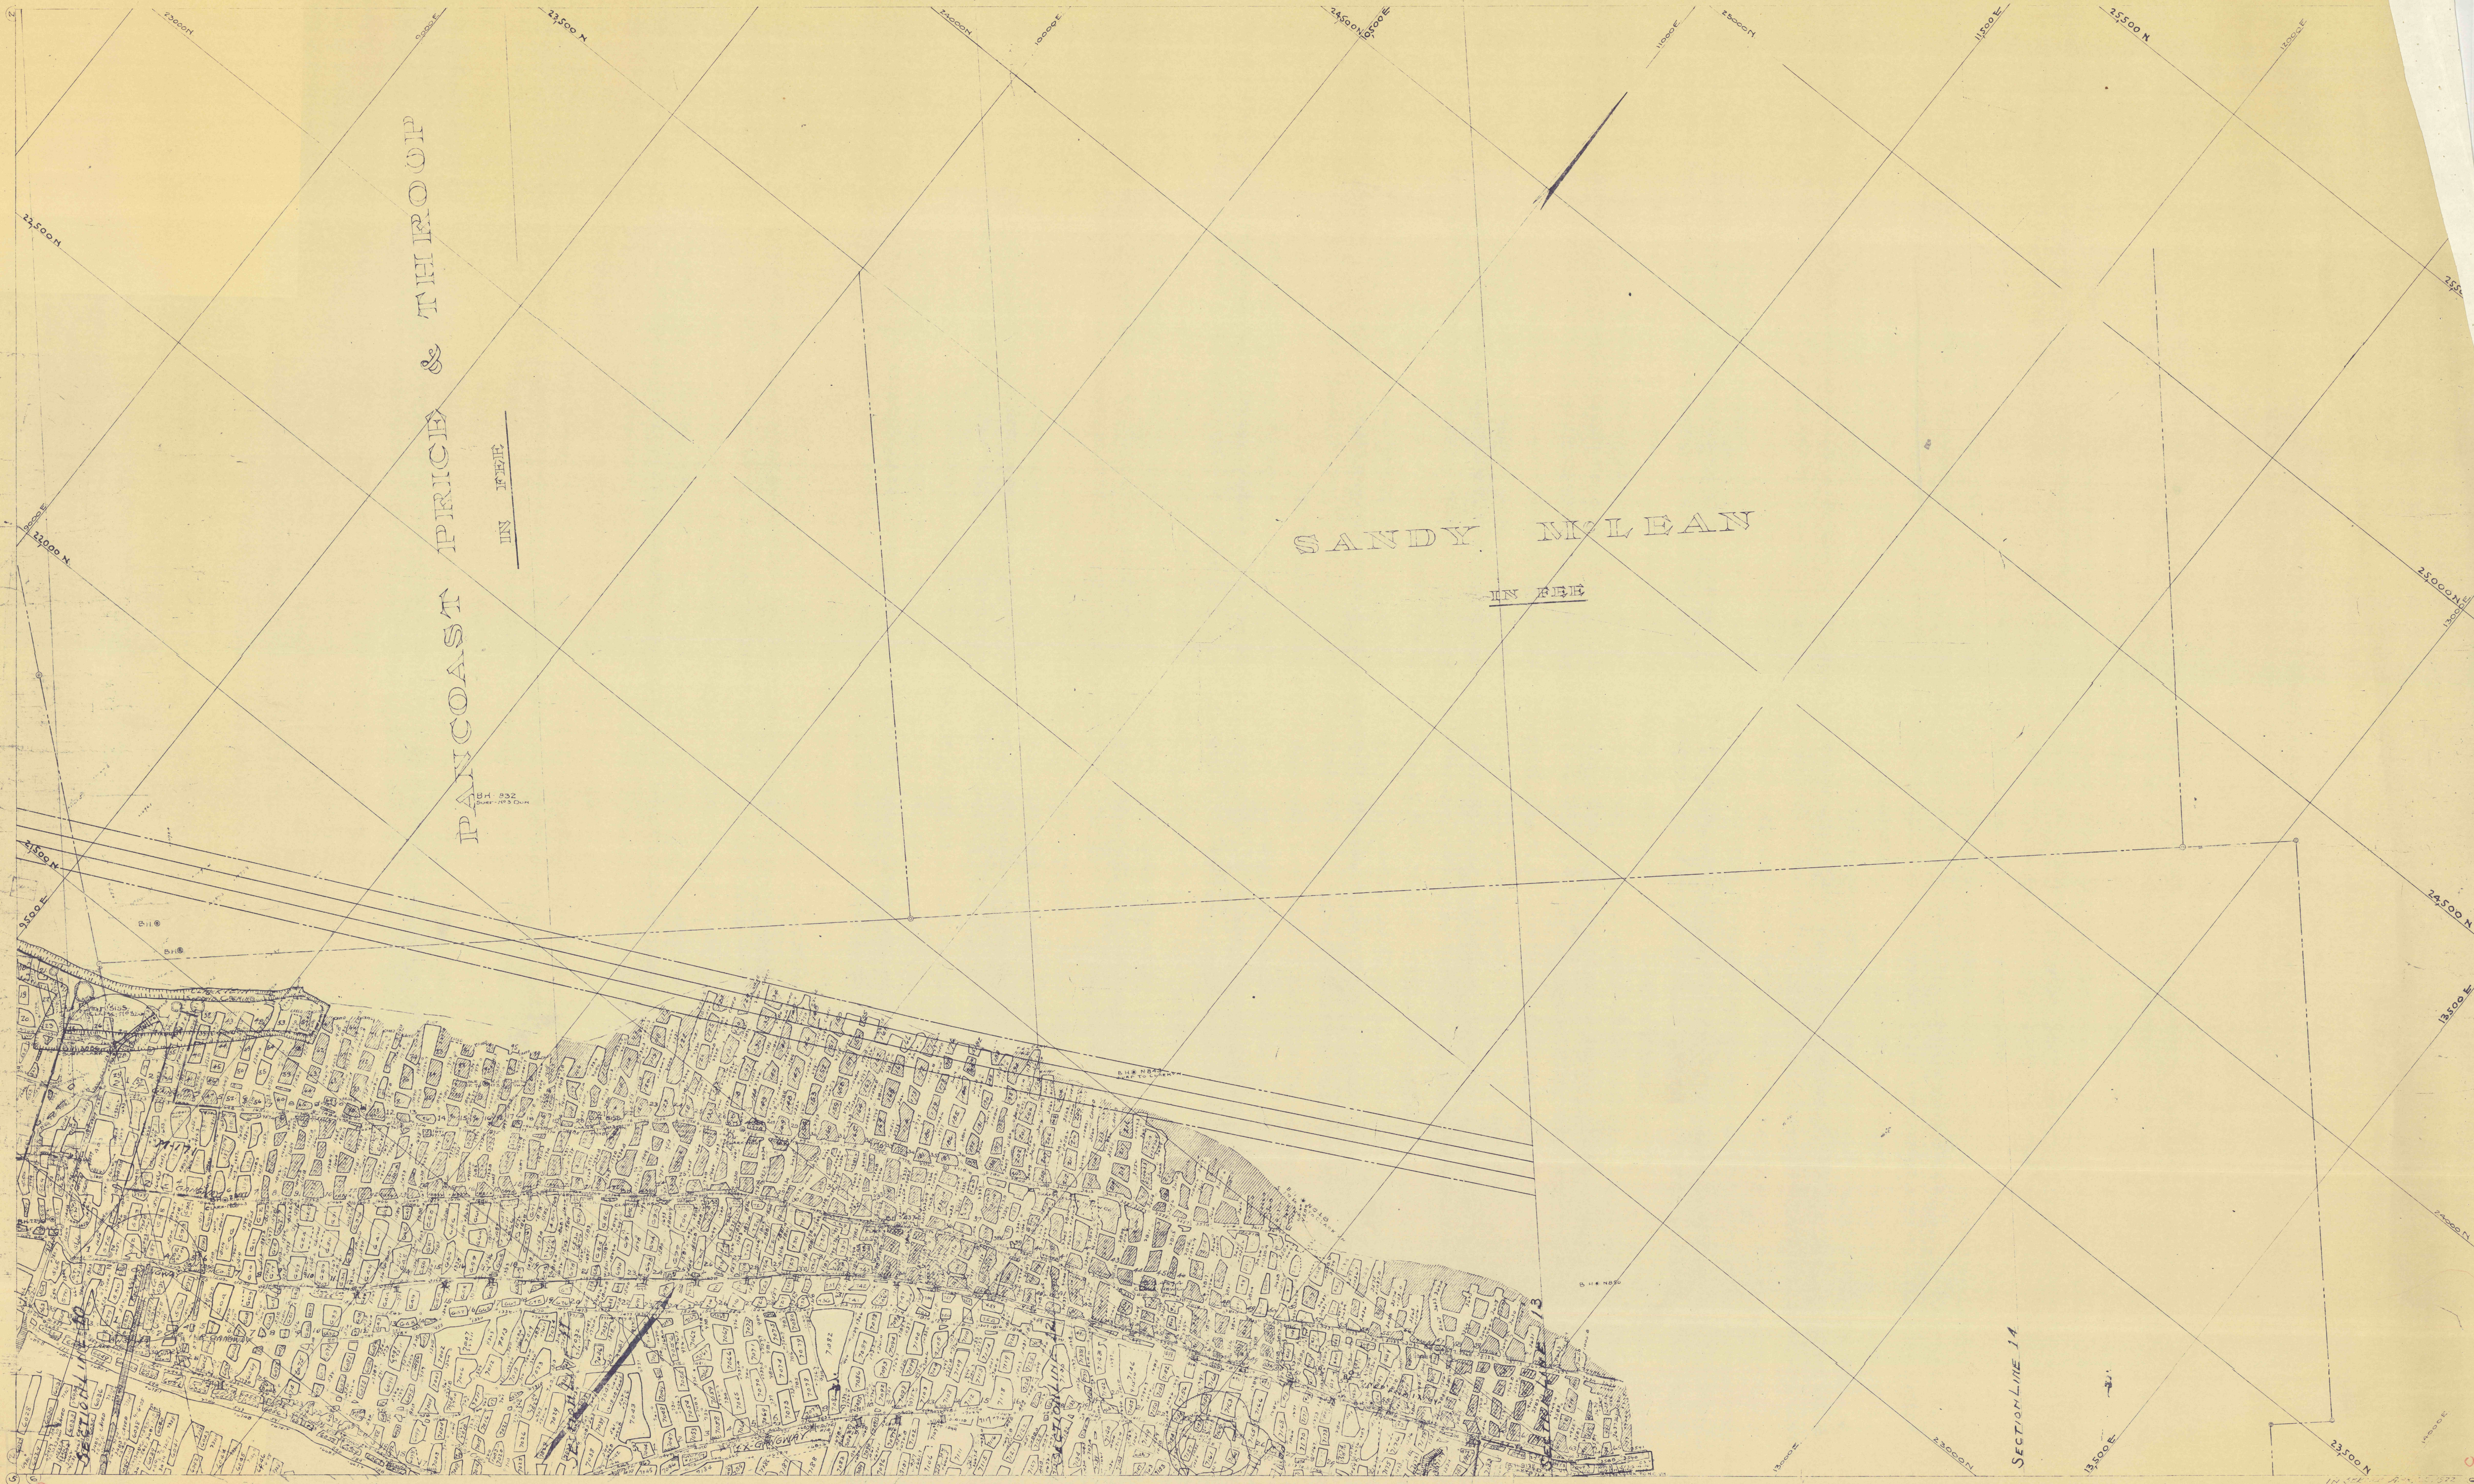

3
NORTHERN COAL FIELD: SCRANTON-BLAKELY Twp.,
CAYUGA-STORRS-CLARK VEIN.
COLLIERIES- 500: LACKAWANNA CO, PA. SCRANTON MORFATT COAL CO.,

SEE SHEET NO 4 FOR LAST PILLAR NO