


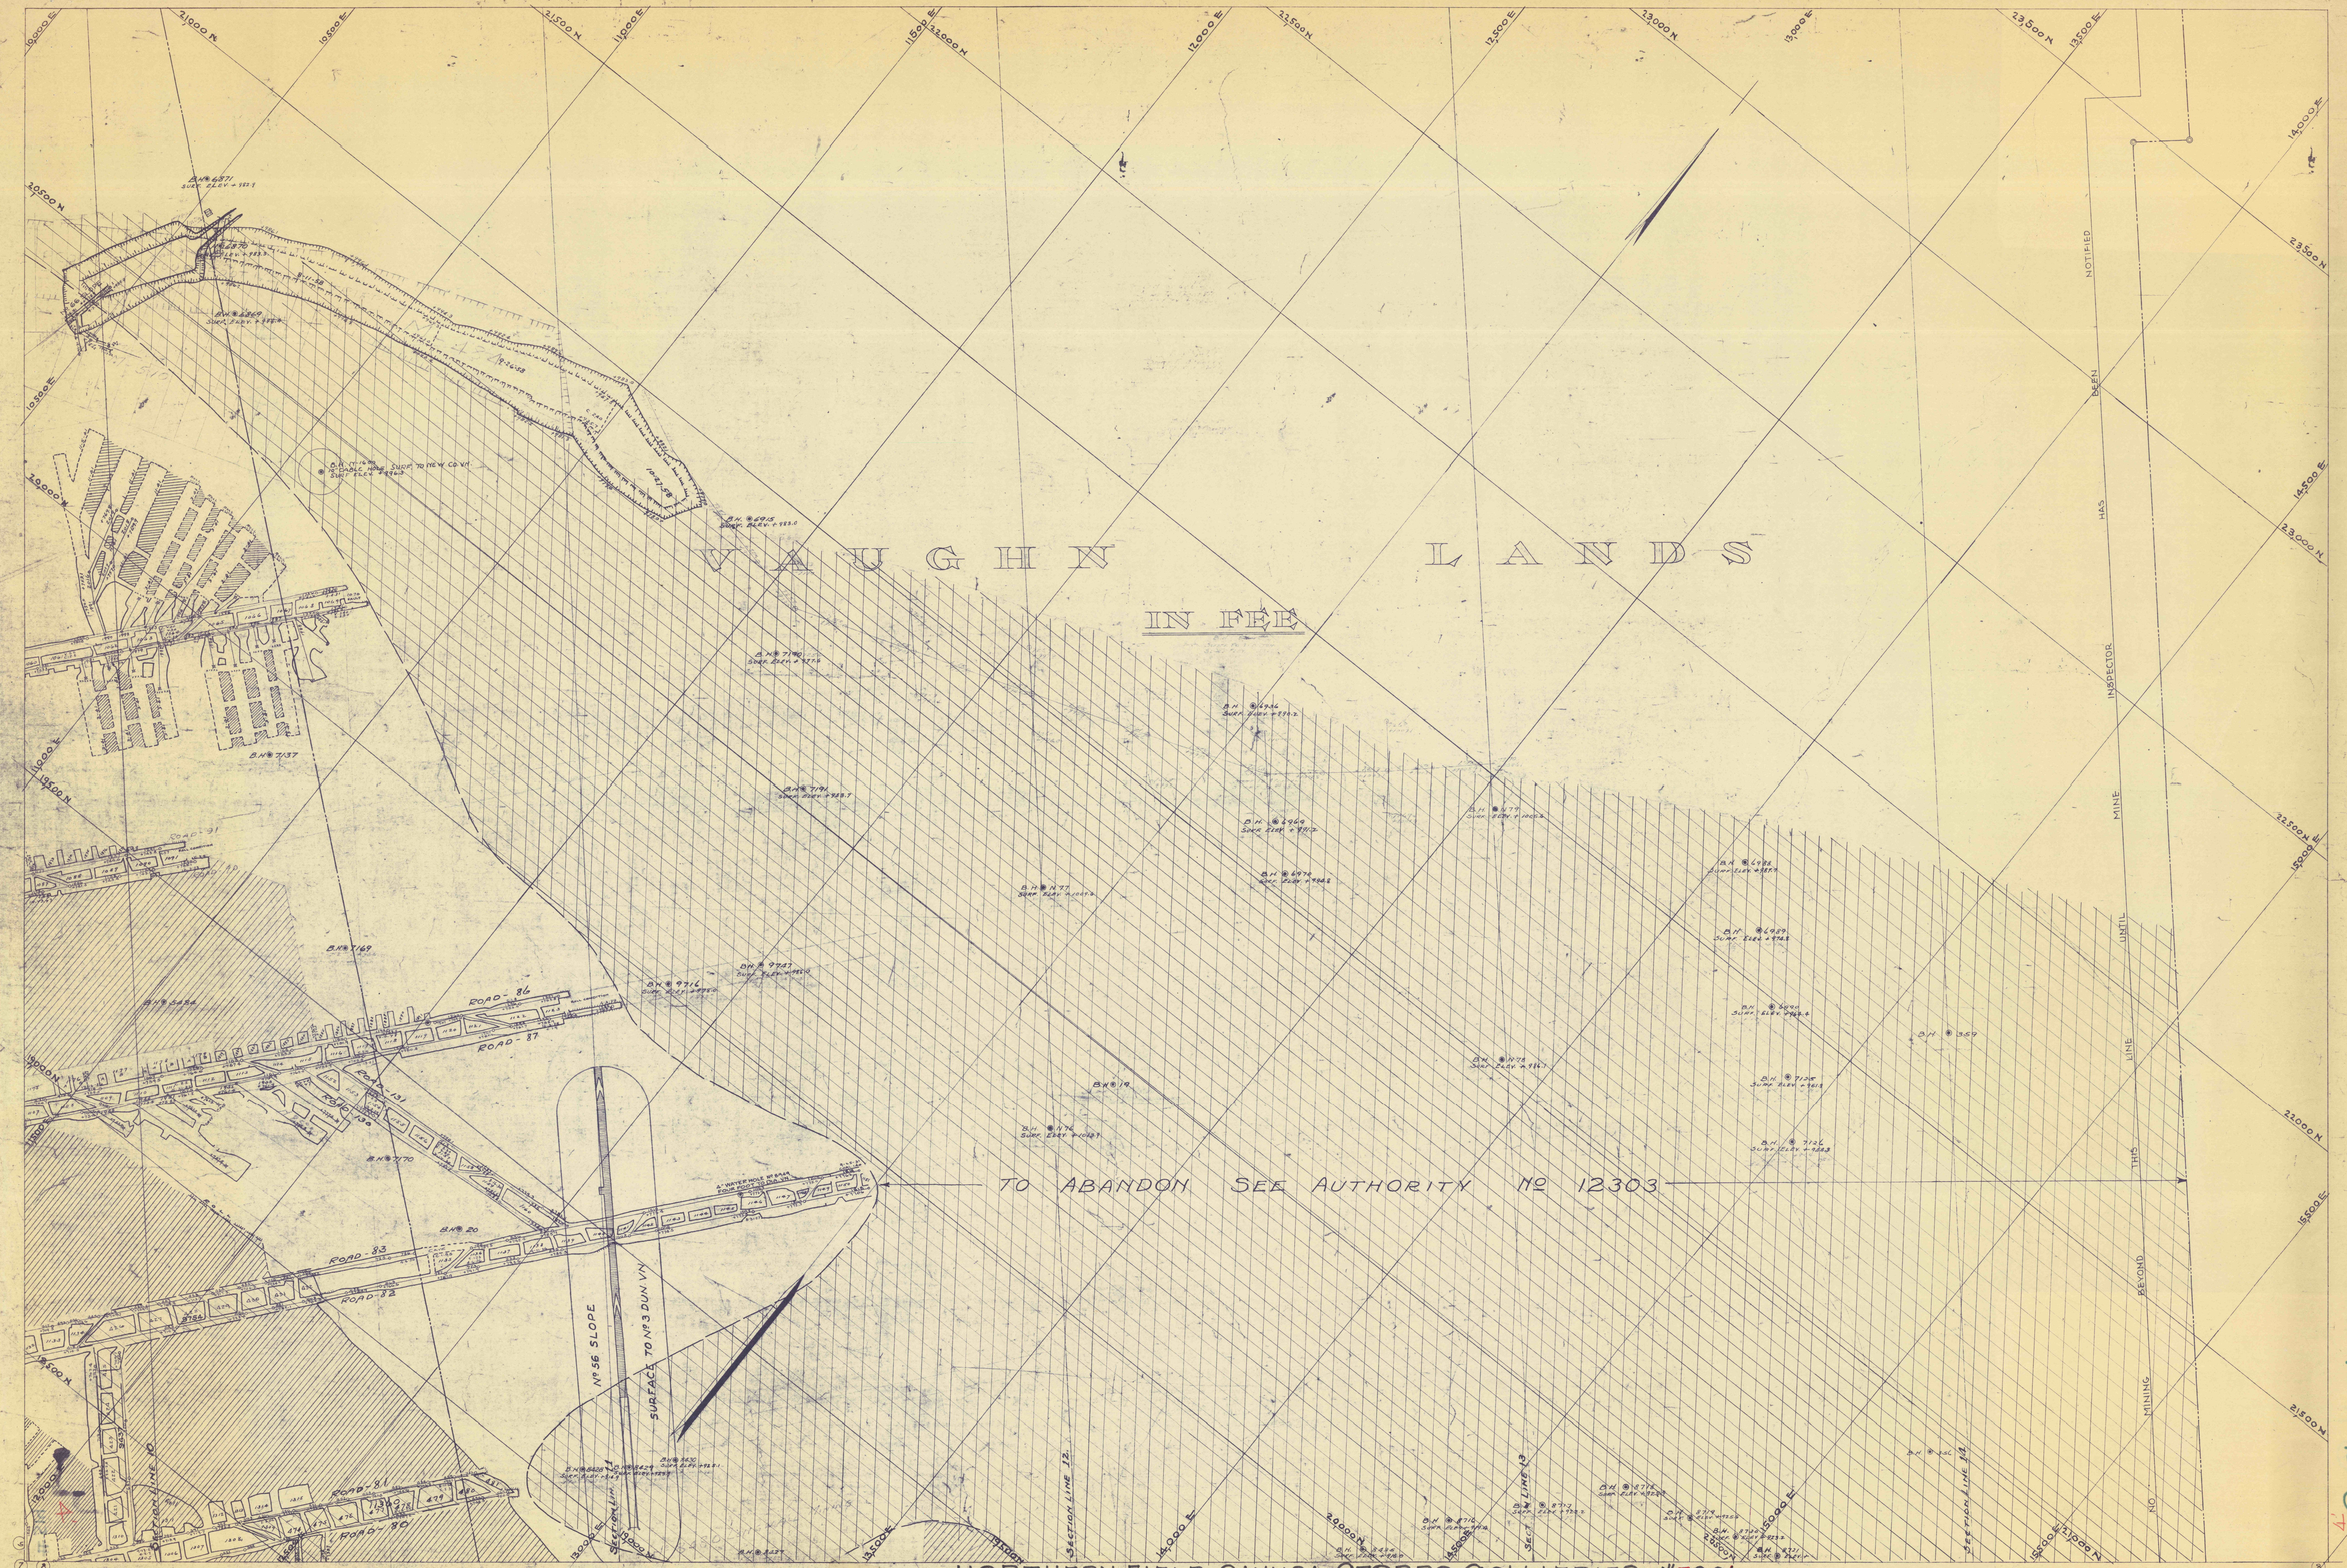

NORTHERN FIELD: CAYUGA-STORRS COLLIERIES: 1"=500'
SCRANTON-BLAKELY TOWNSHIP, LACKAWANNA CO., PA. MOFFAT COAL CO.
CAYUGA-STORRS - FOUR FOOT VN

Storrs