


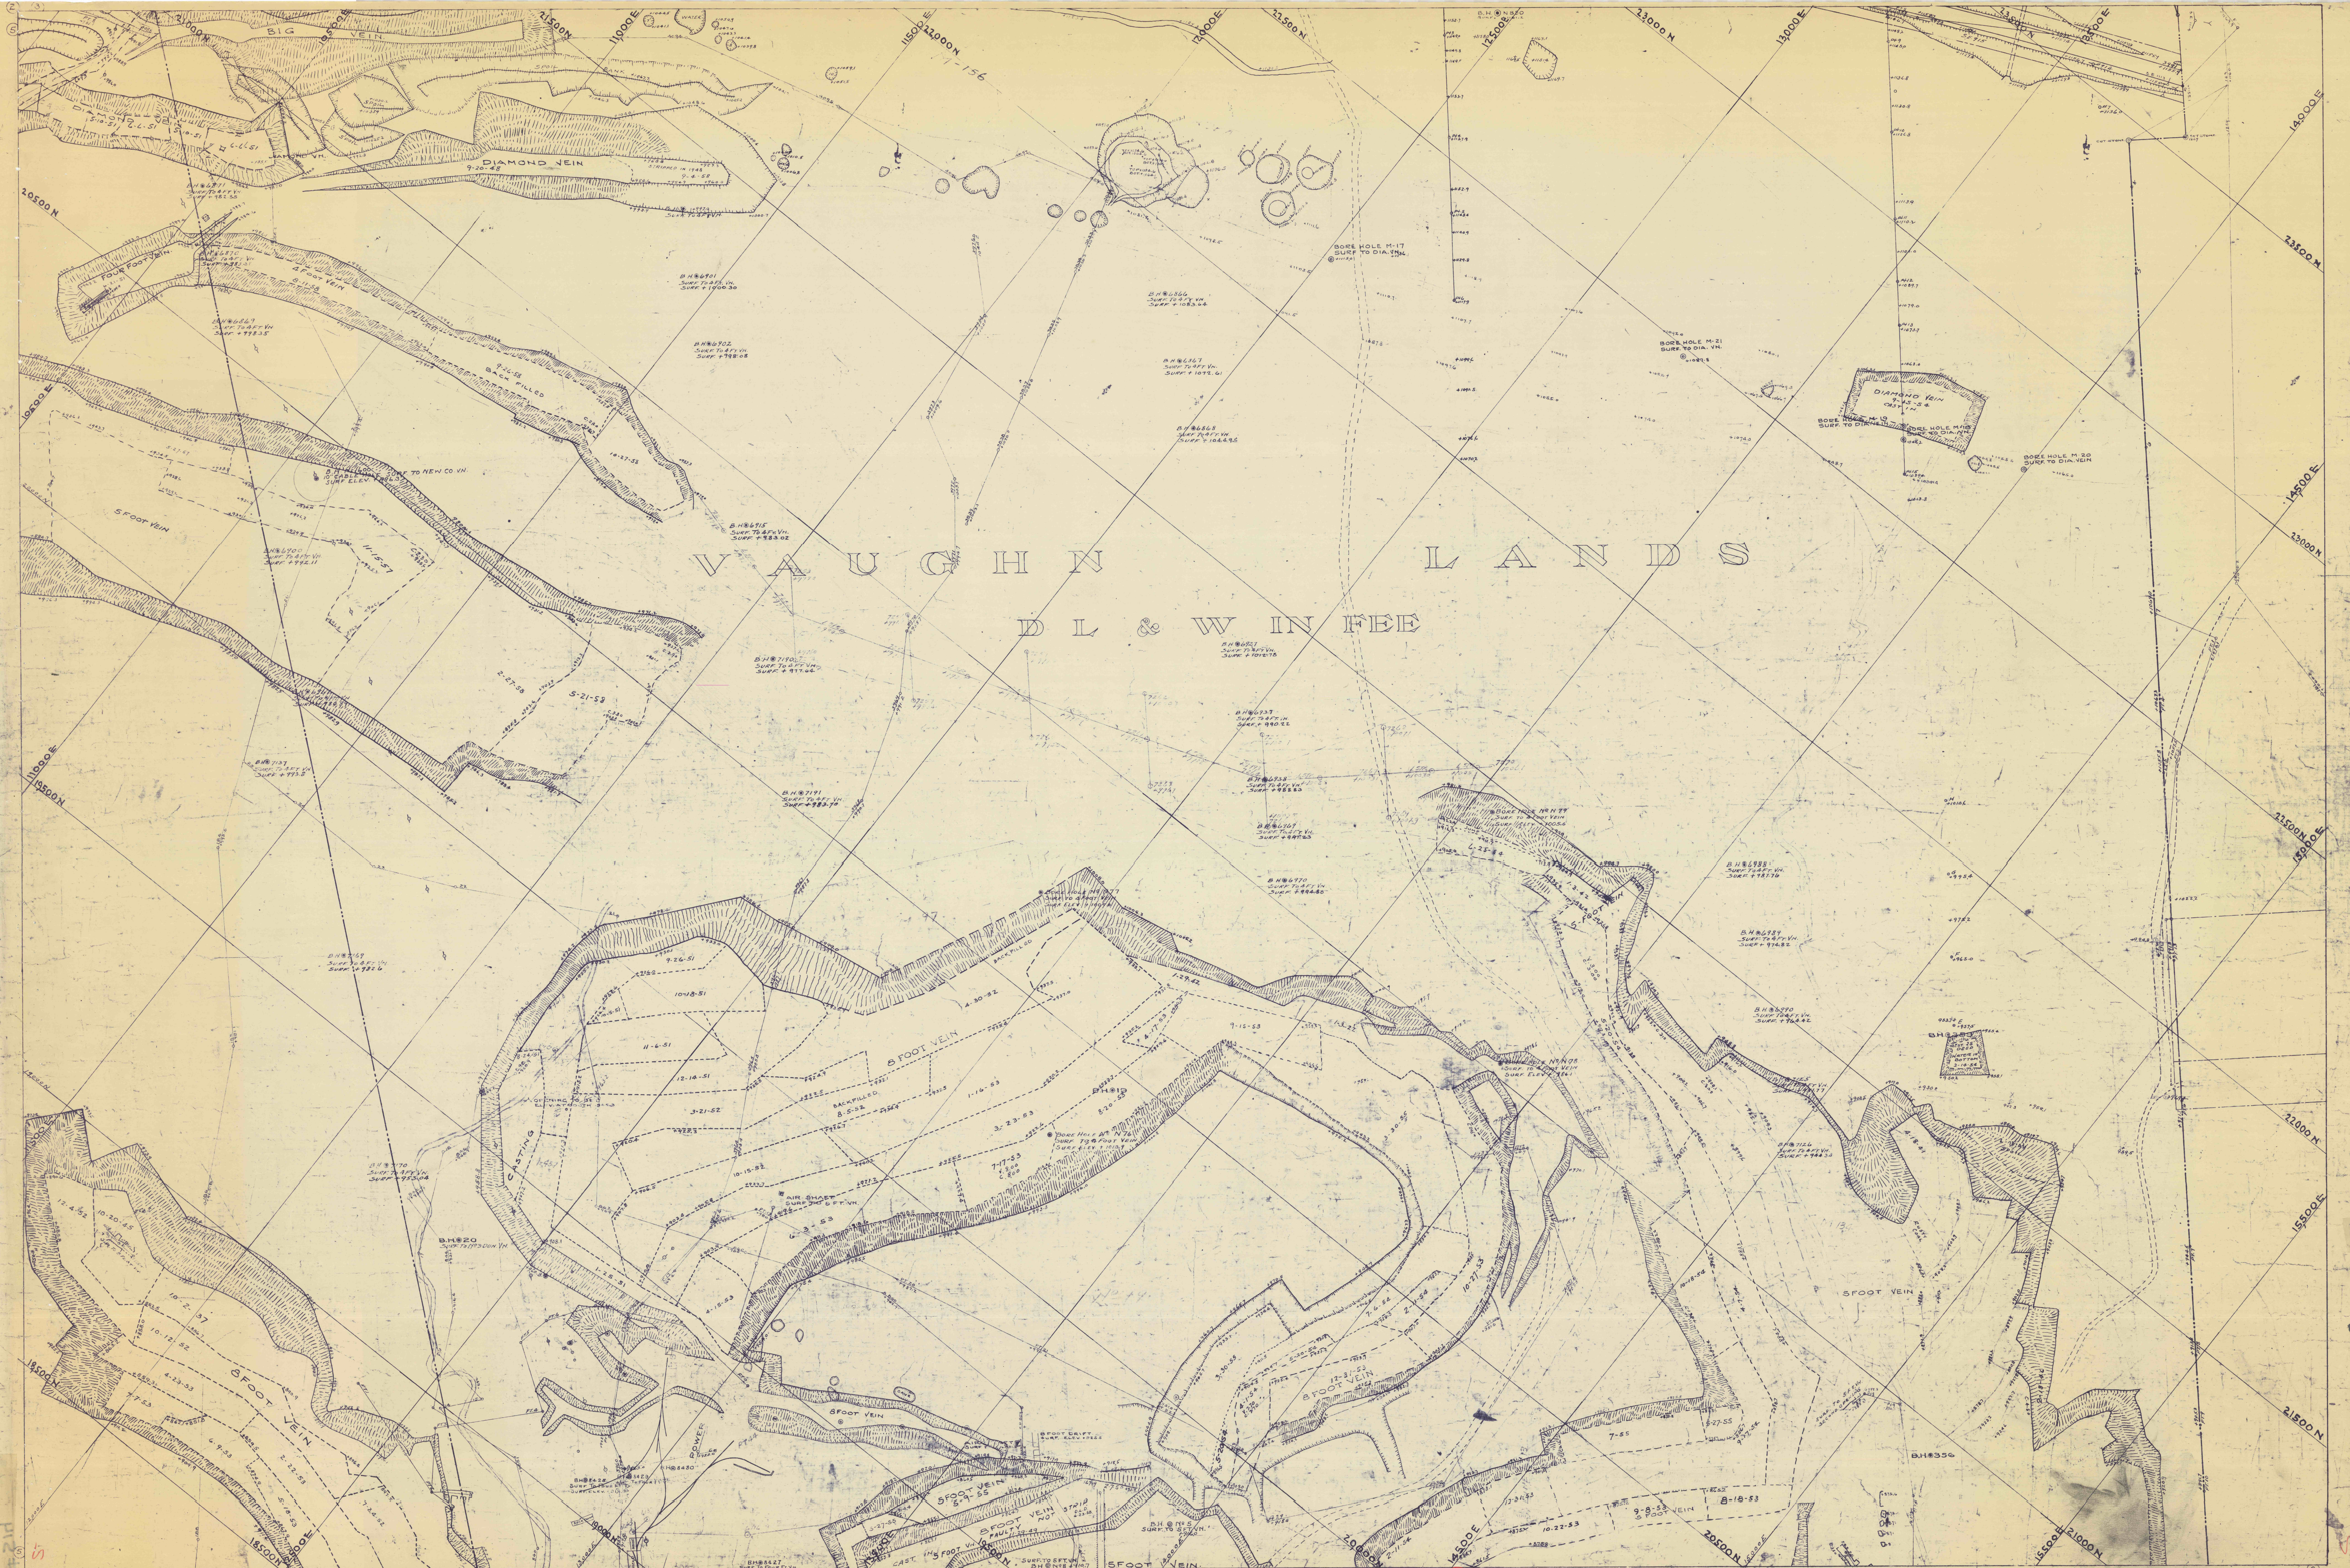

© SET... NORTHERN FIELD, SCRANTON-BLAKELY TWPS., 1"=500'..
LACKAWANNA COUNTY, PA.
CAYUGA-STORRS-SURFACE MOFFAT COAL CO.,

DIST
Storrs Surface