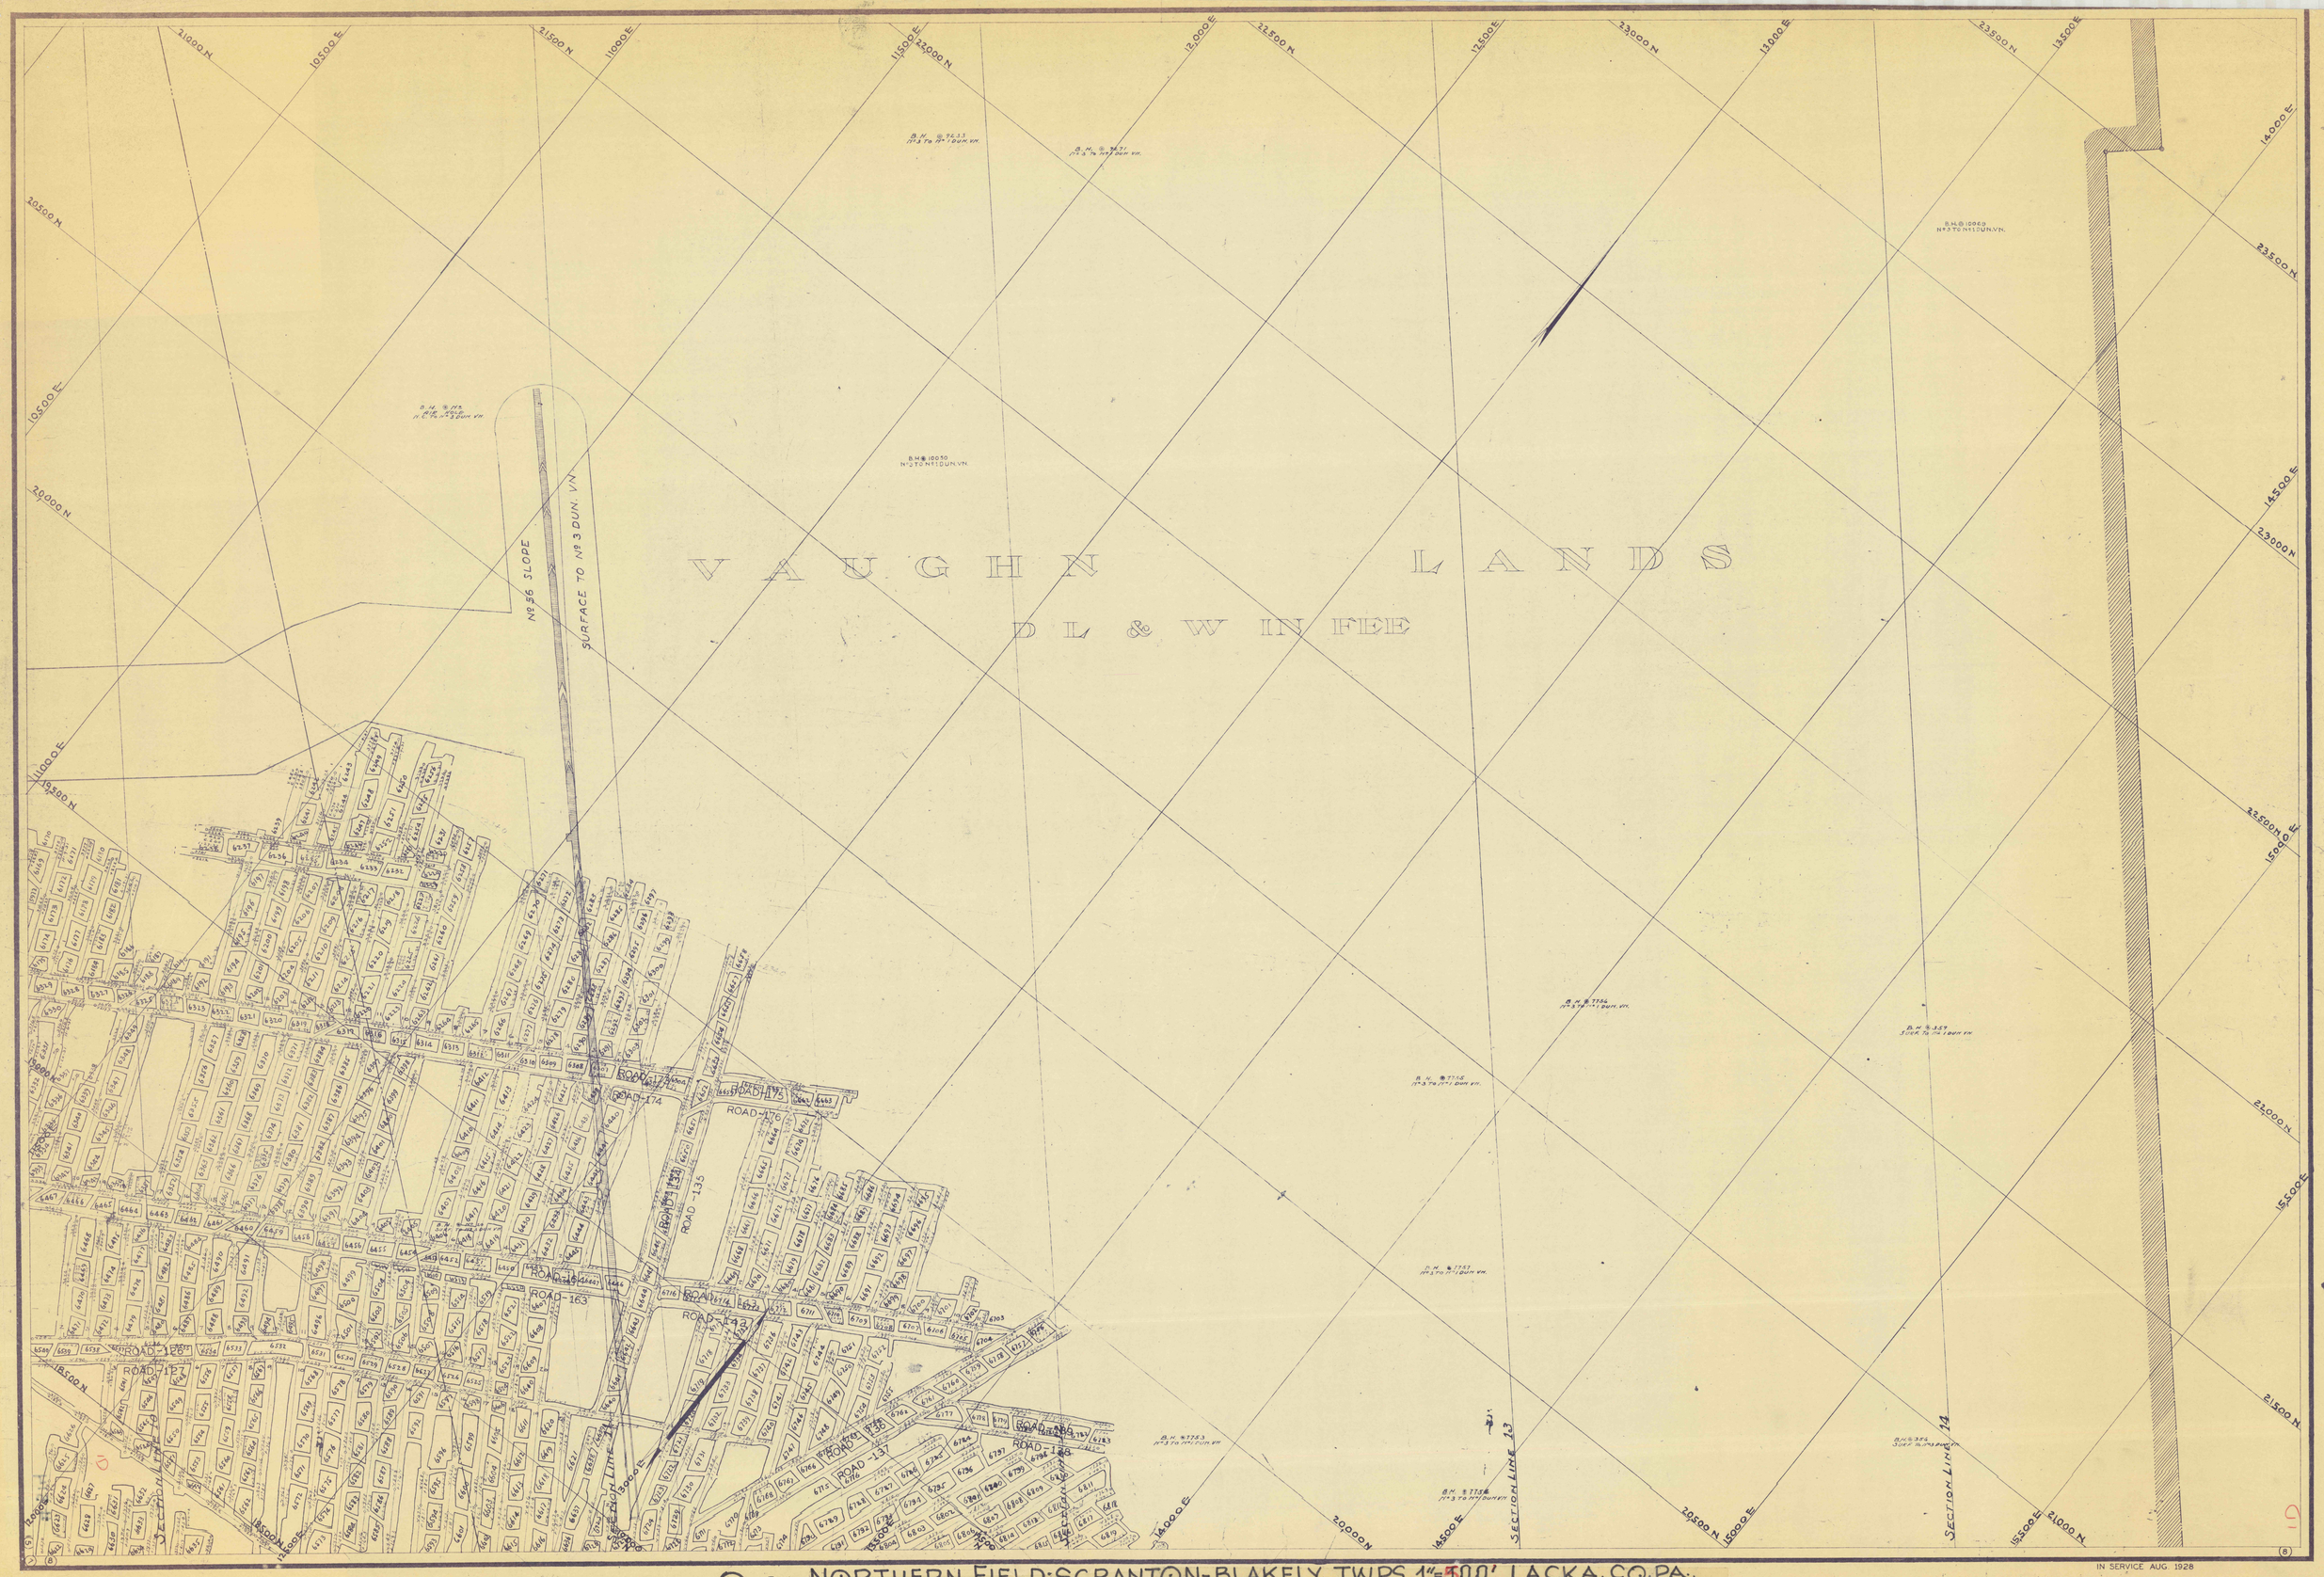

...(6)...Set NORTHERN FIELD: SCRANTON-BLAKELY TWPS., 1"=100'...LACKA., CO., PA.,
CAYUGA—STORRS—DUN No 1 VEIN...

IN SERVICE AUG. 1928

6