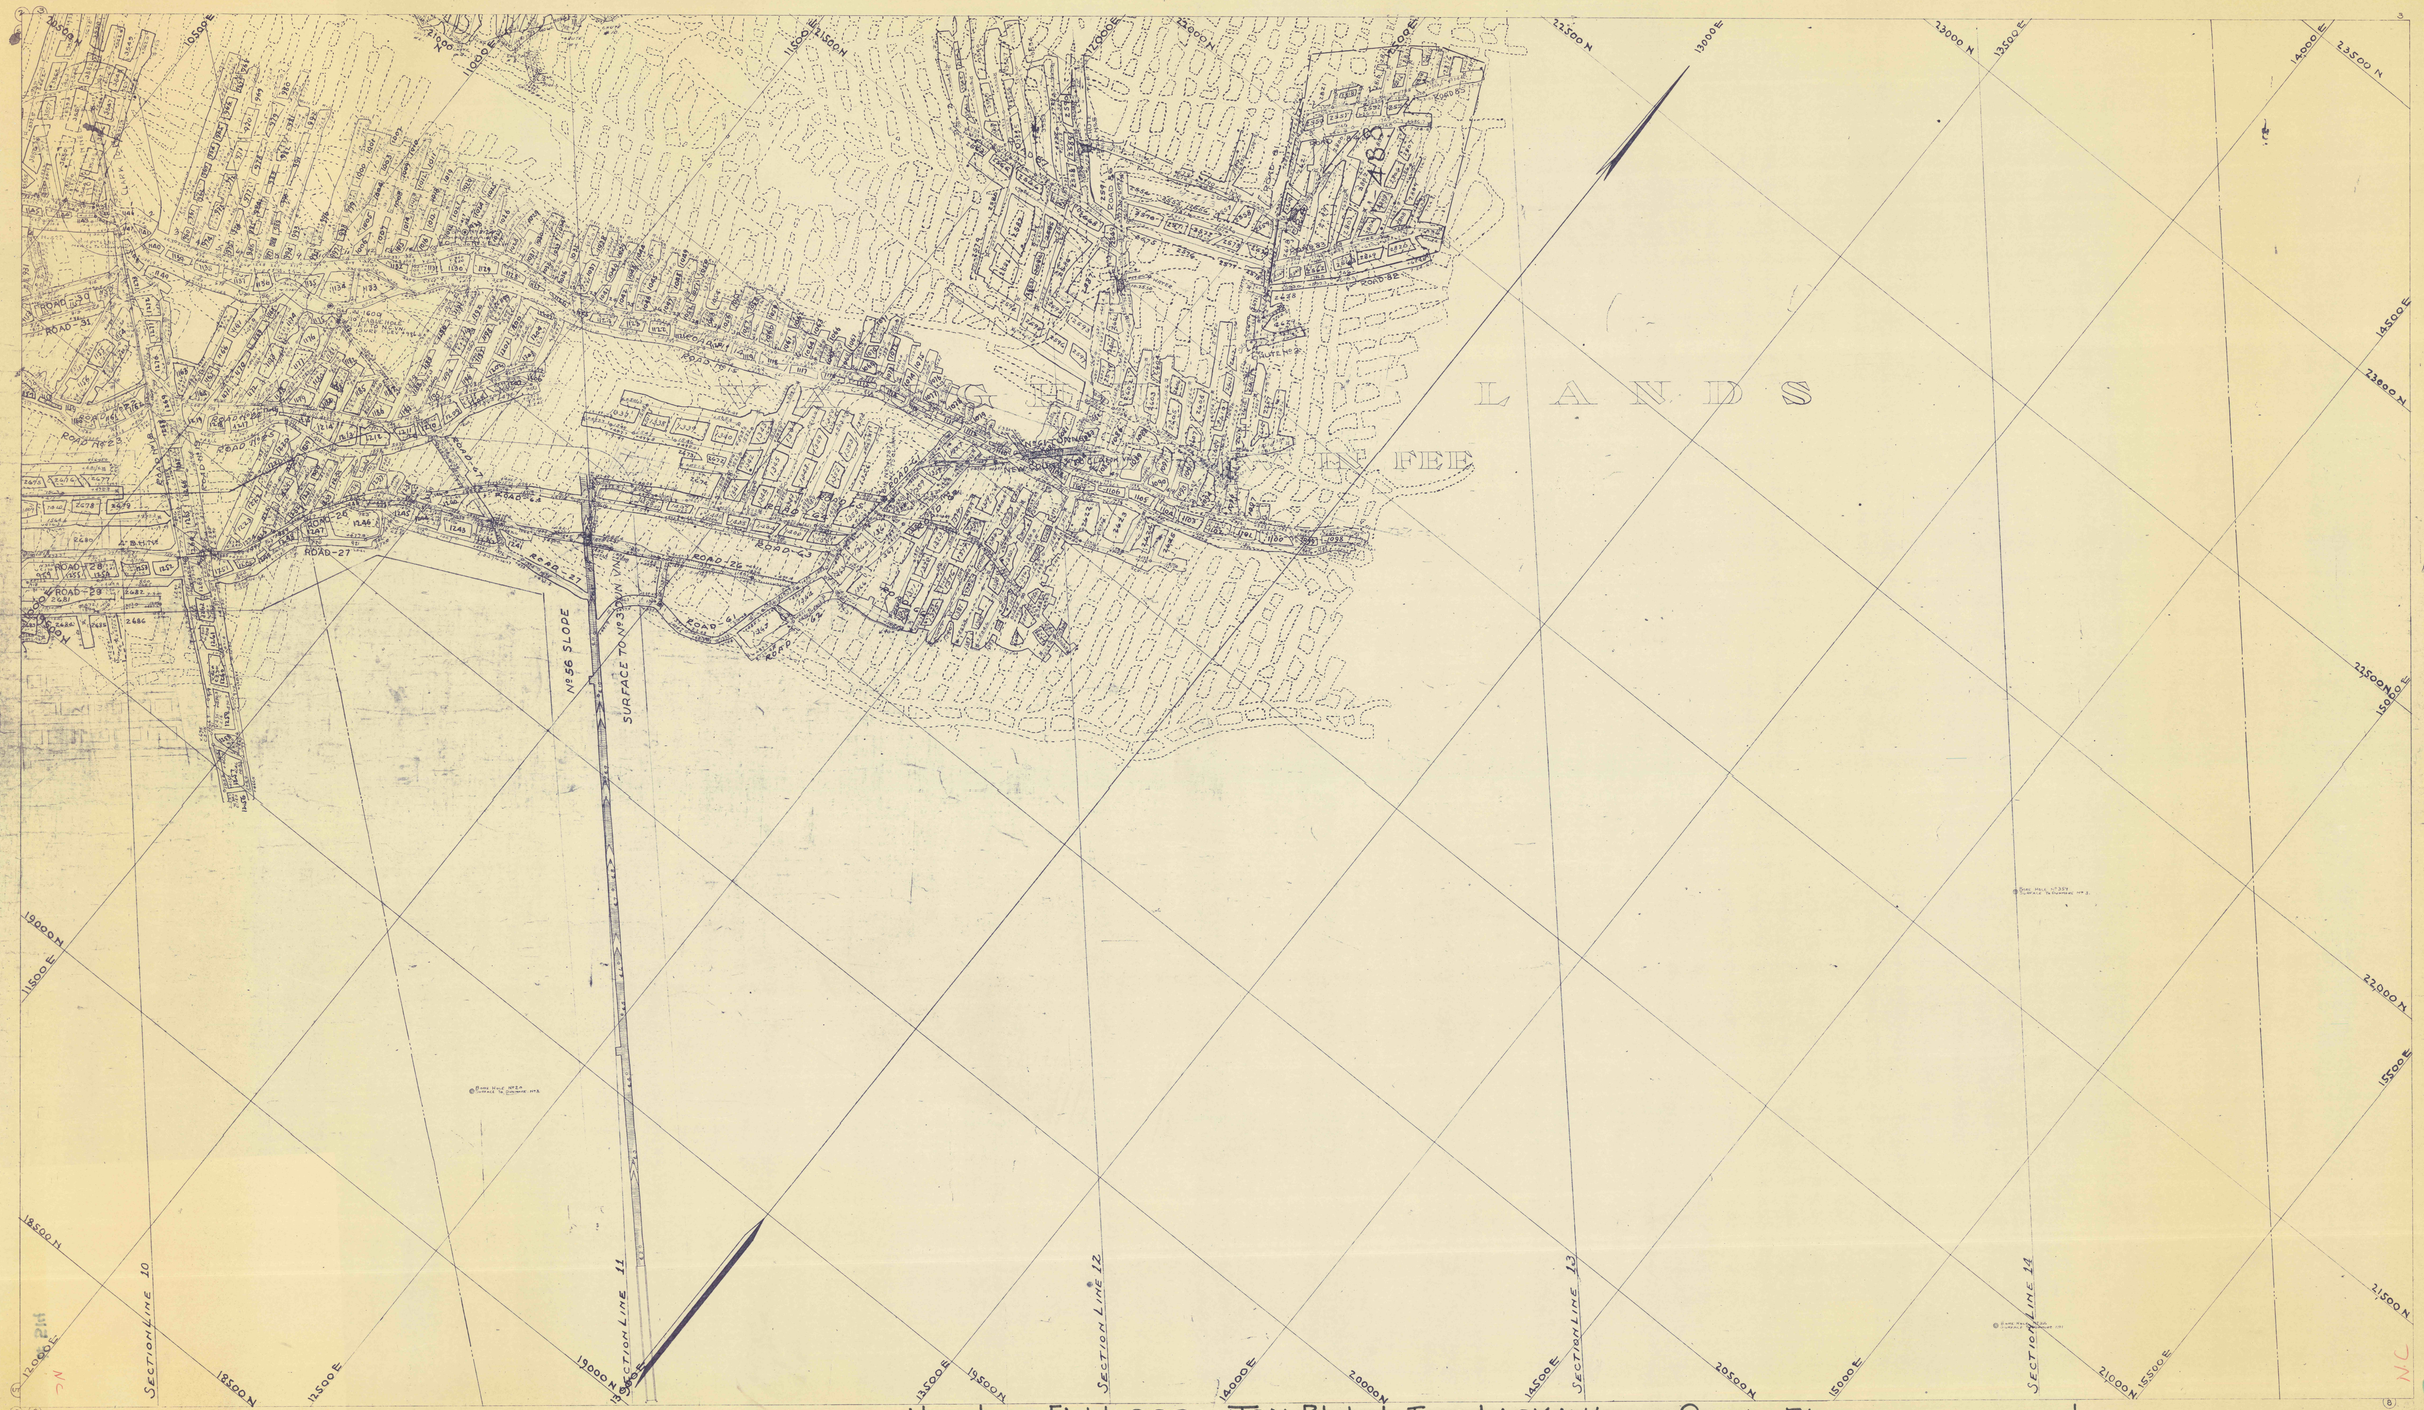
LANDS
IN FEE
No 56 SLOPE
SURFACE TO No 56 SLOPE
SECTION LINE 10
SECTION LINE 11
SECTION LINE 12
SECTION LINE 13
SECTION LINE 14
ROAD-31
ROAD-27
ROAD-26
ROAD-25
ROAD-24
ROAD-23
ROAD-21
ROAD-28
ROAD-29
ROAD-30
ROAD-32
ROAD-33
