


NORTHERN FIELD..1"=100'..CAYUGA-STORR'S COLL'R'S...
CLARK VN; SCRANTON-BLAKELY TWPS., LACRA, CO, PA.
MOFFAT COAL COMPANY... ⑦...SET.

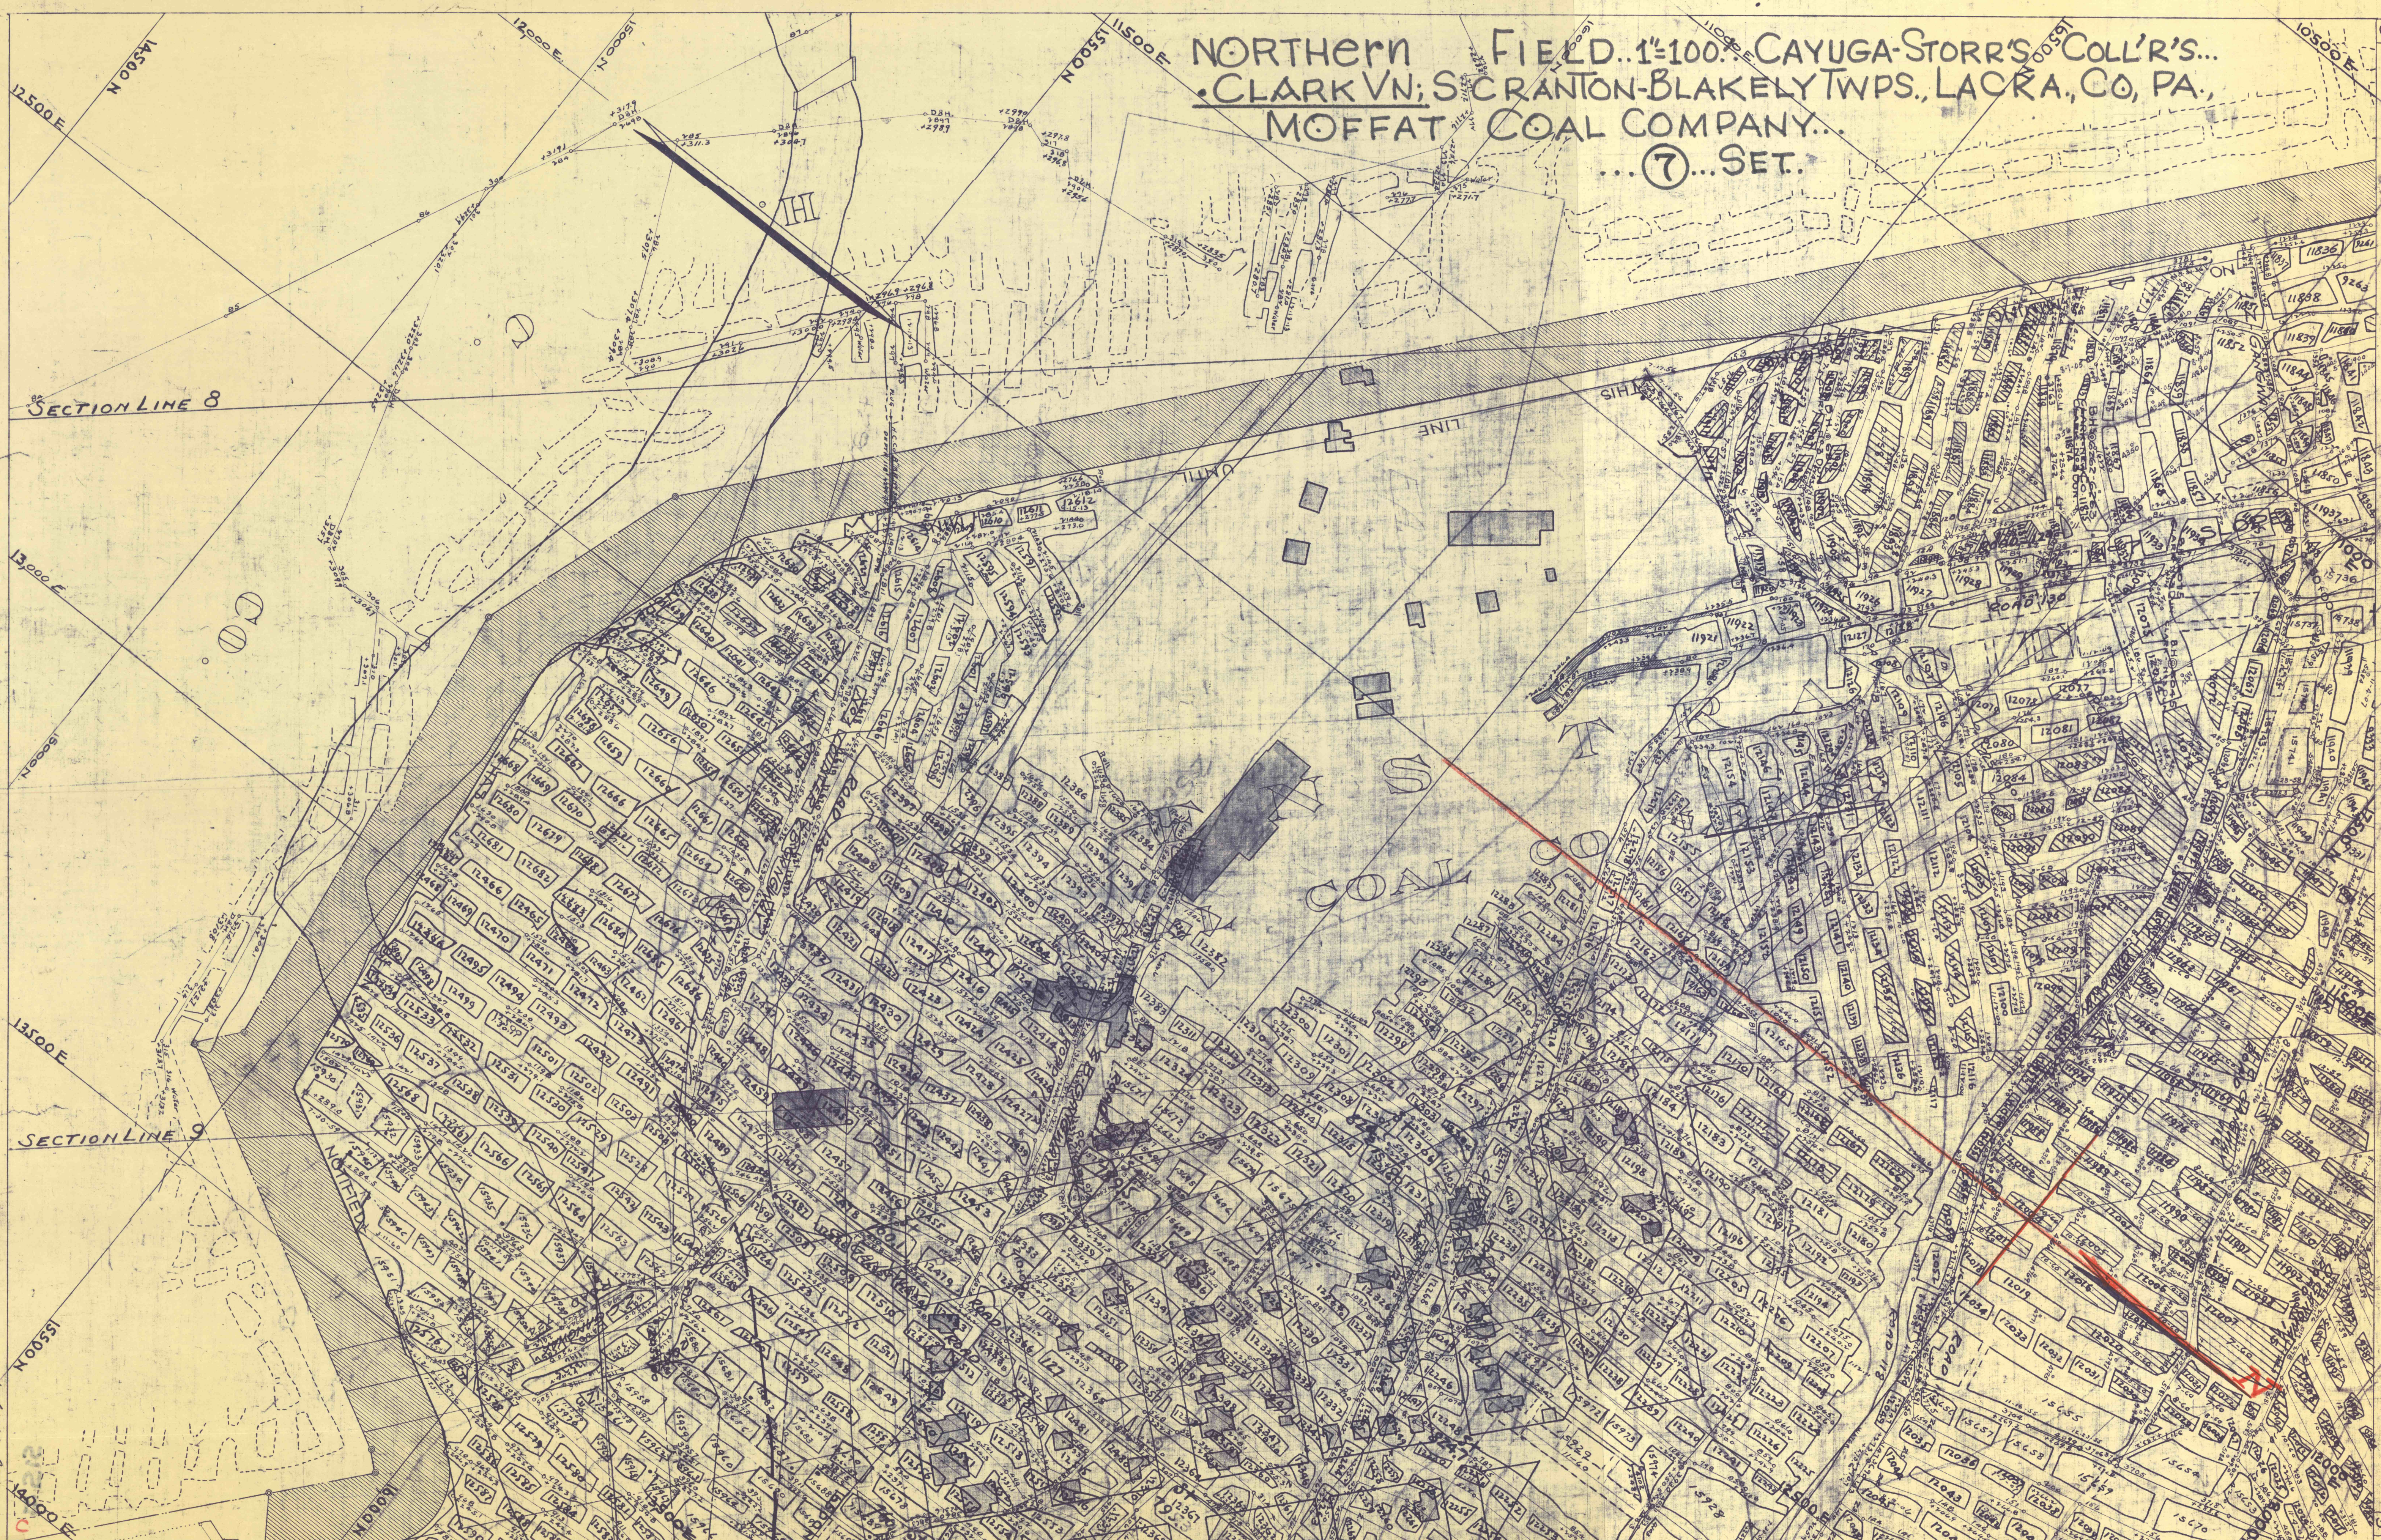

SEE SHEET N84 FOR LAST PILLAR N8

IN SERIES APR 26, 1922

Clark Vn