


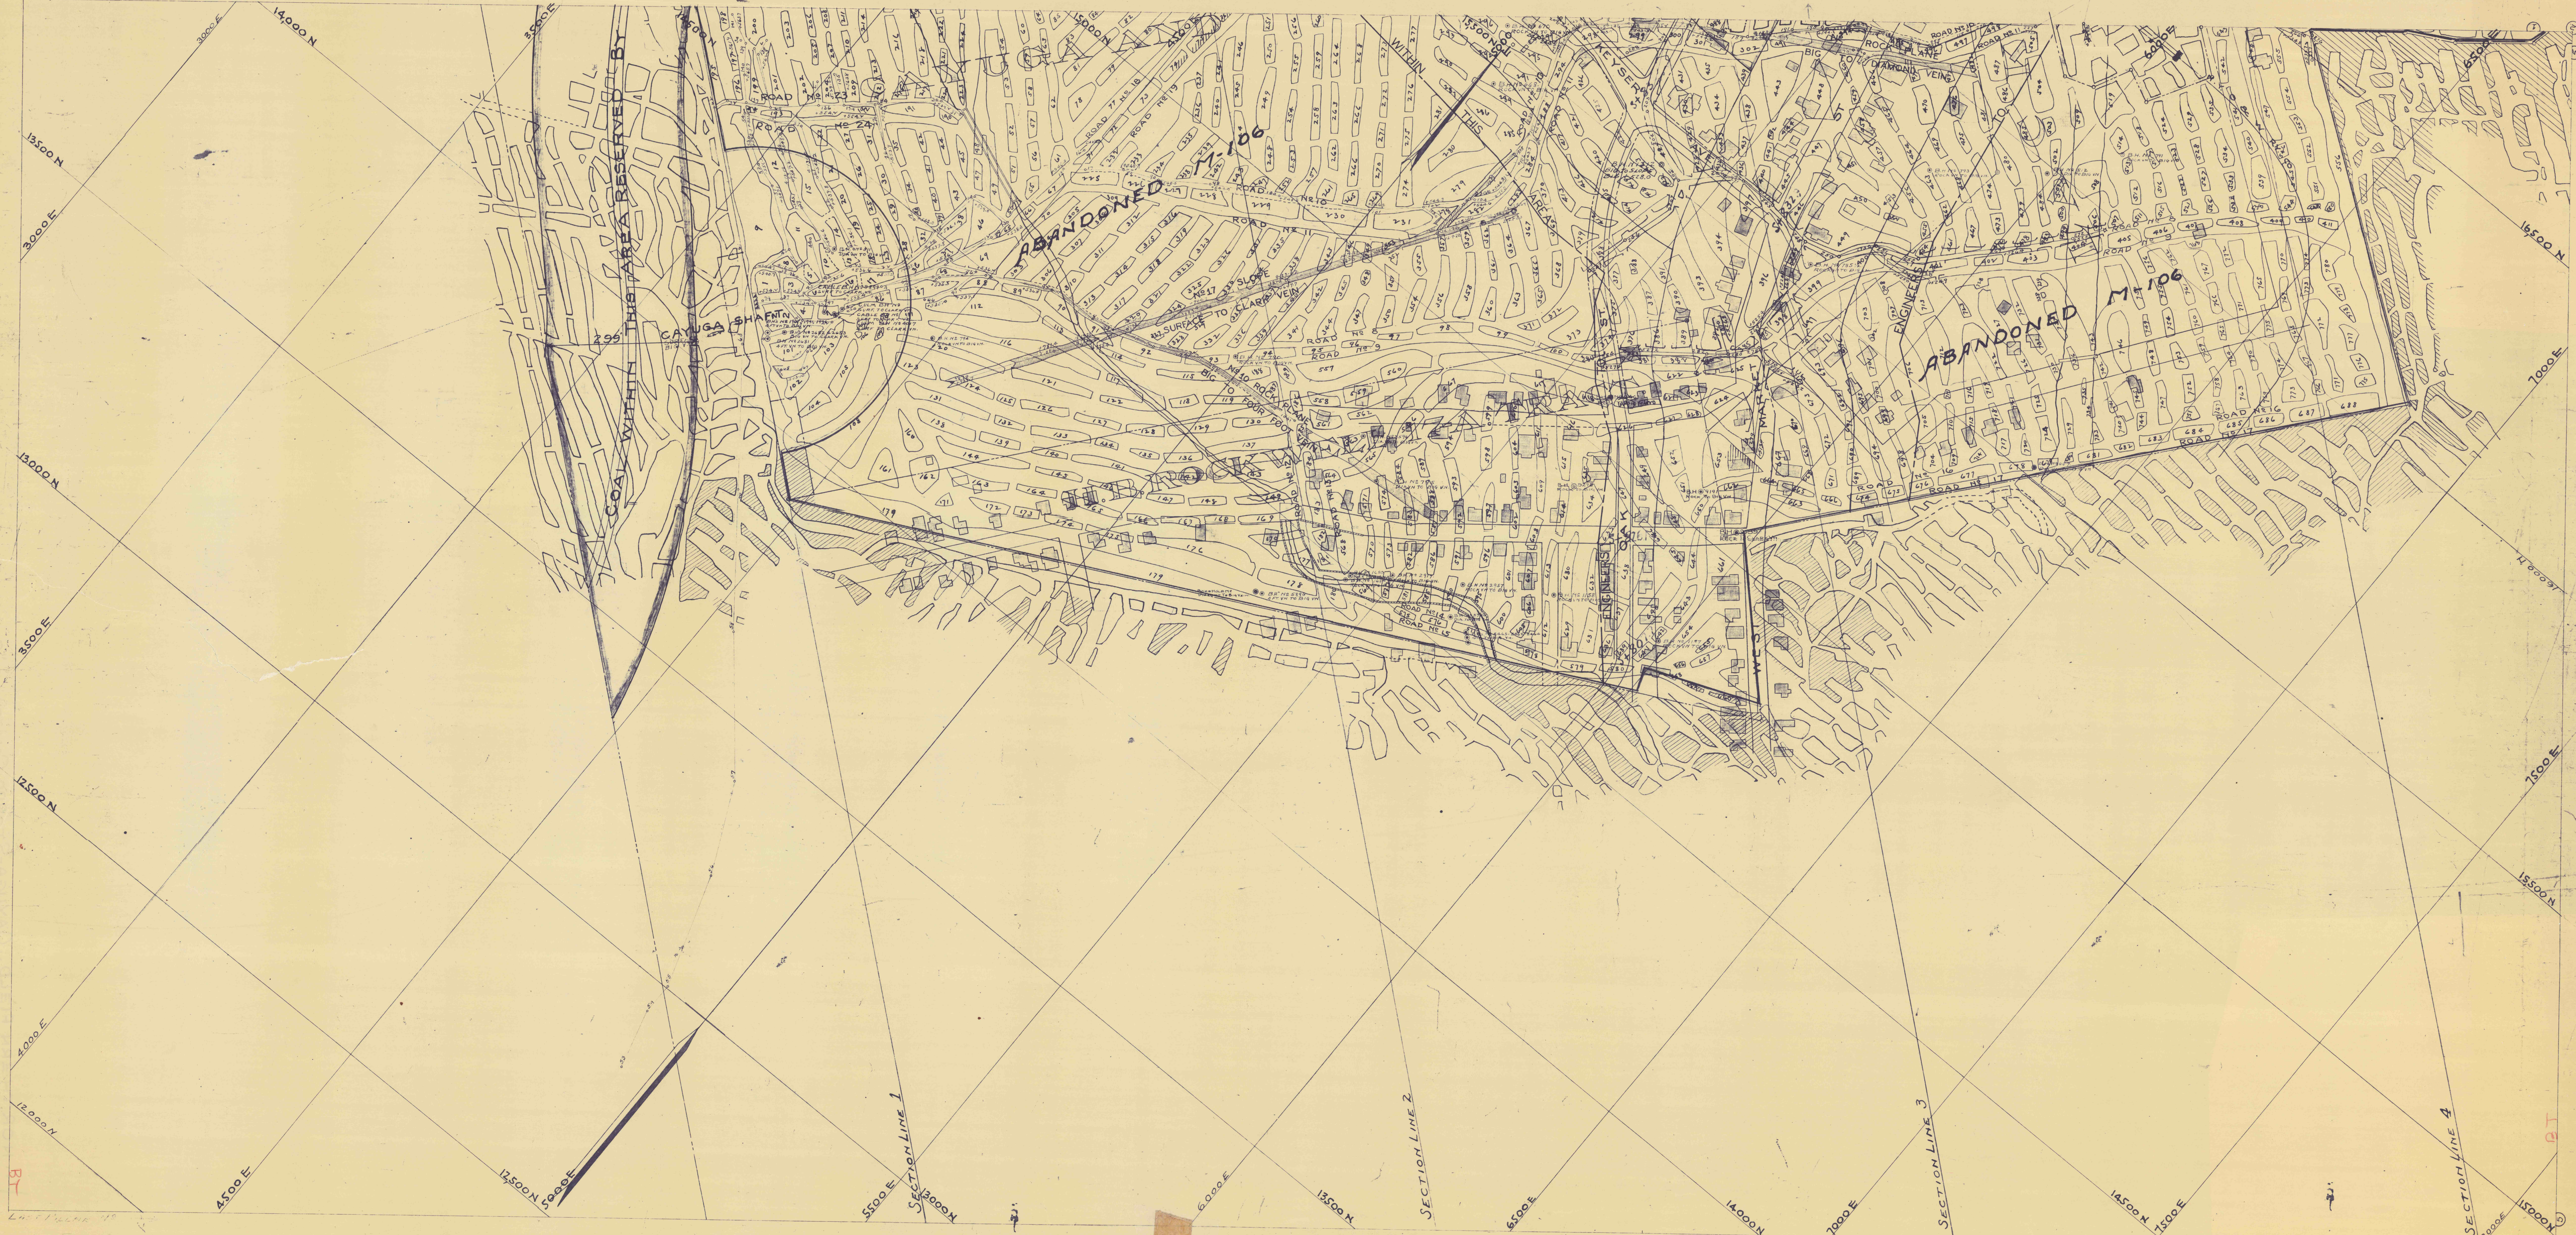

NORTHERN FIELD, SCRANTON-BLAKELY TWPS., 1/2 100'. MOFFATT COAL CO.
CAYUGA-STORRS-BIG TOP VEIN.
COLLIERIES-INACTIVE
JULY 1959.

Stores Big Top