


Cubana 106 Rock

TOPROCK BED
CAPOUSE COLLIERY
PENN ANTHRACITE MINING CO
SCALE 1"=400' Nov. 13 1933

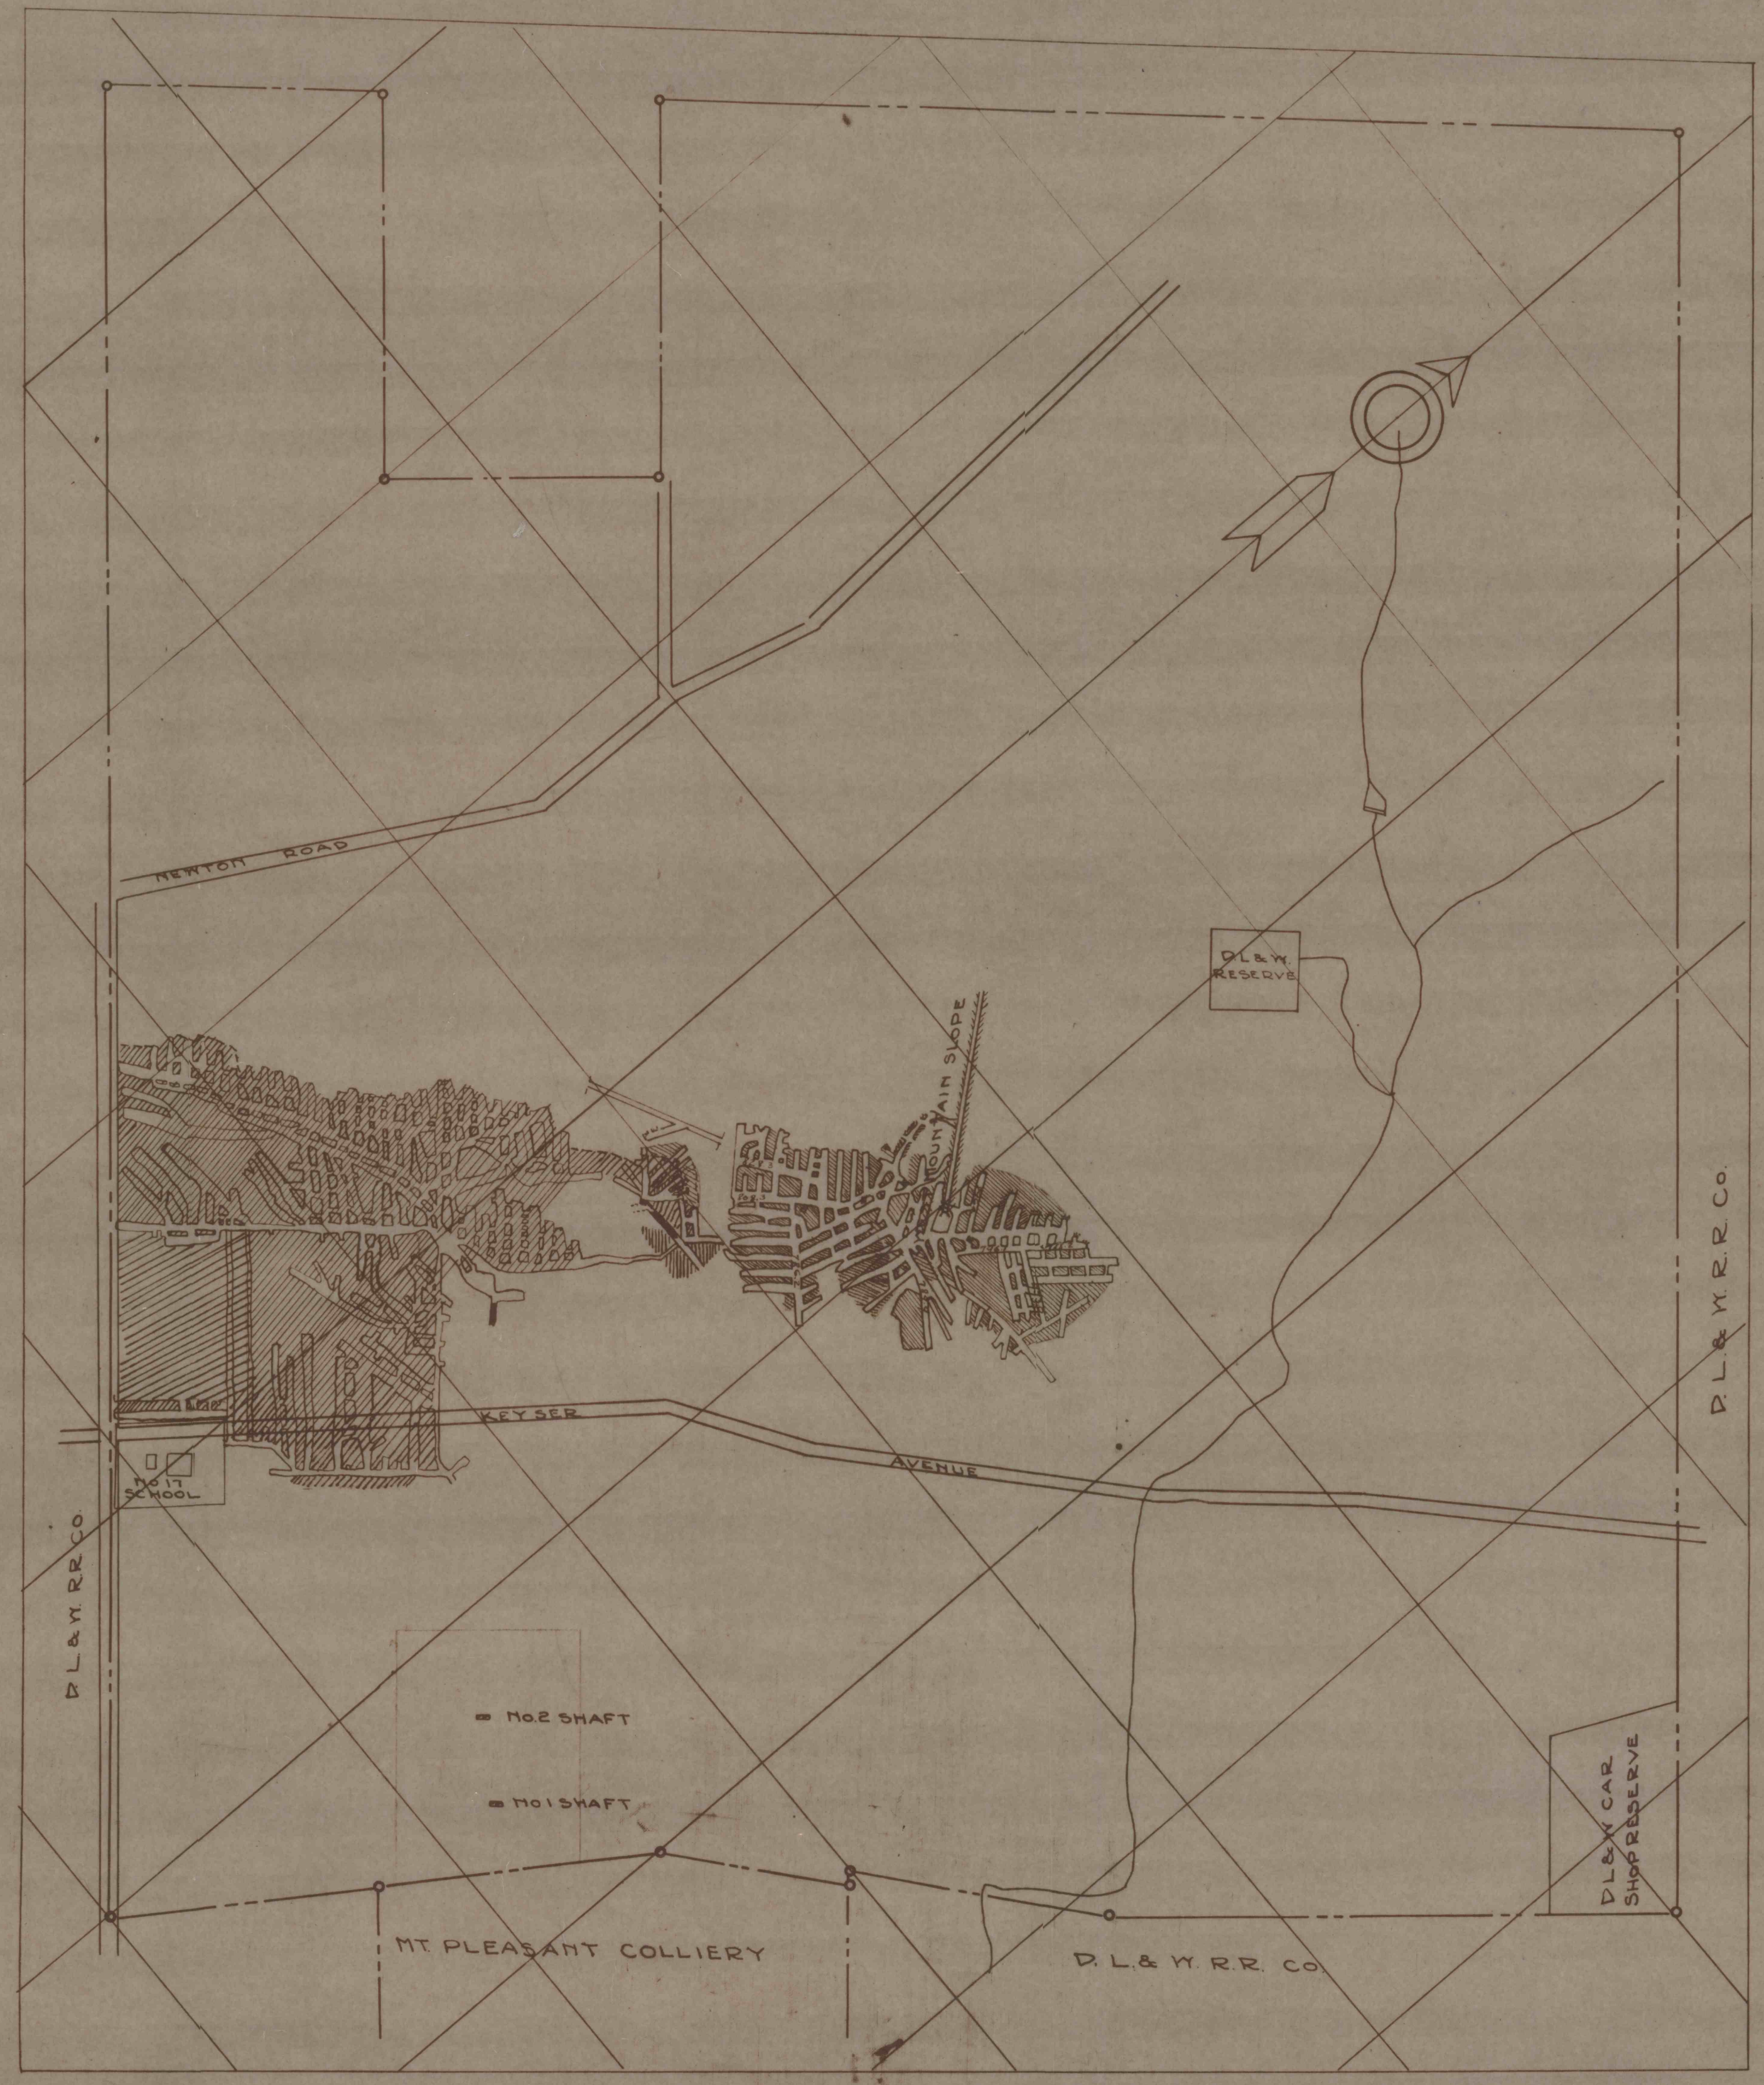

25
E