


CADWELL JOB CLARK

TOP CLARK BED
CAPOUSE COLLIERY
PENN ANTHRACITE MINING CO
SCALE 1"=400' NOV. 12 1933

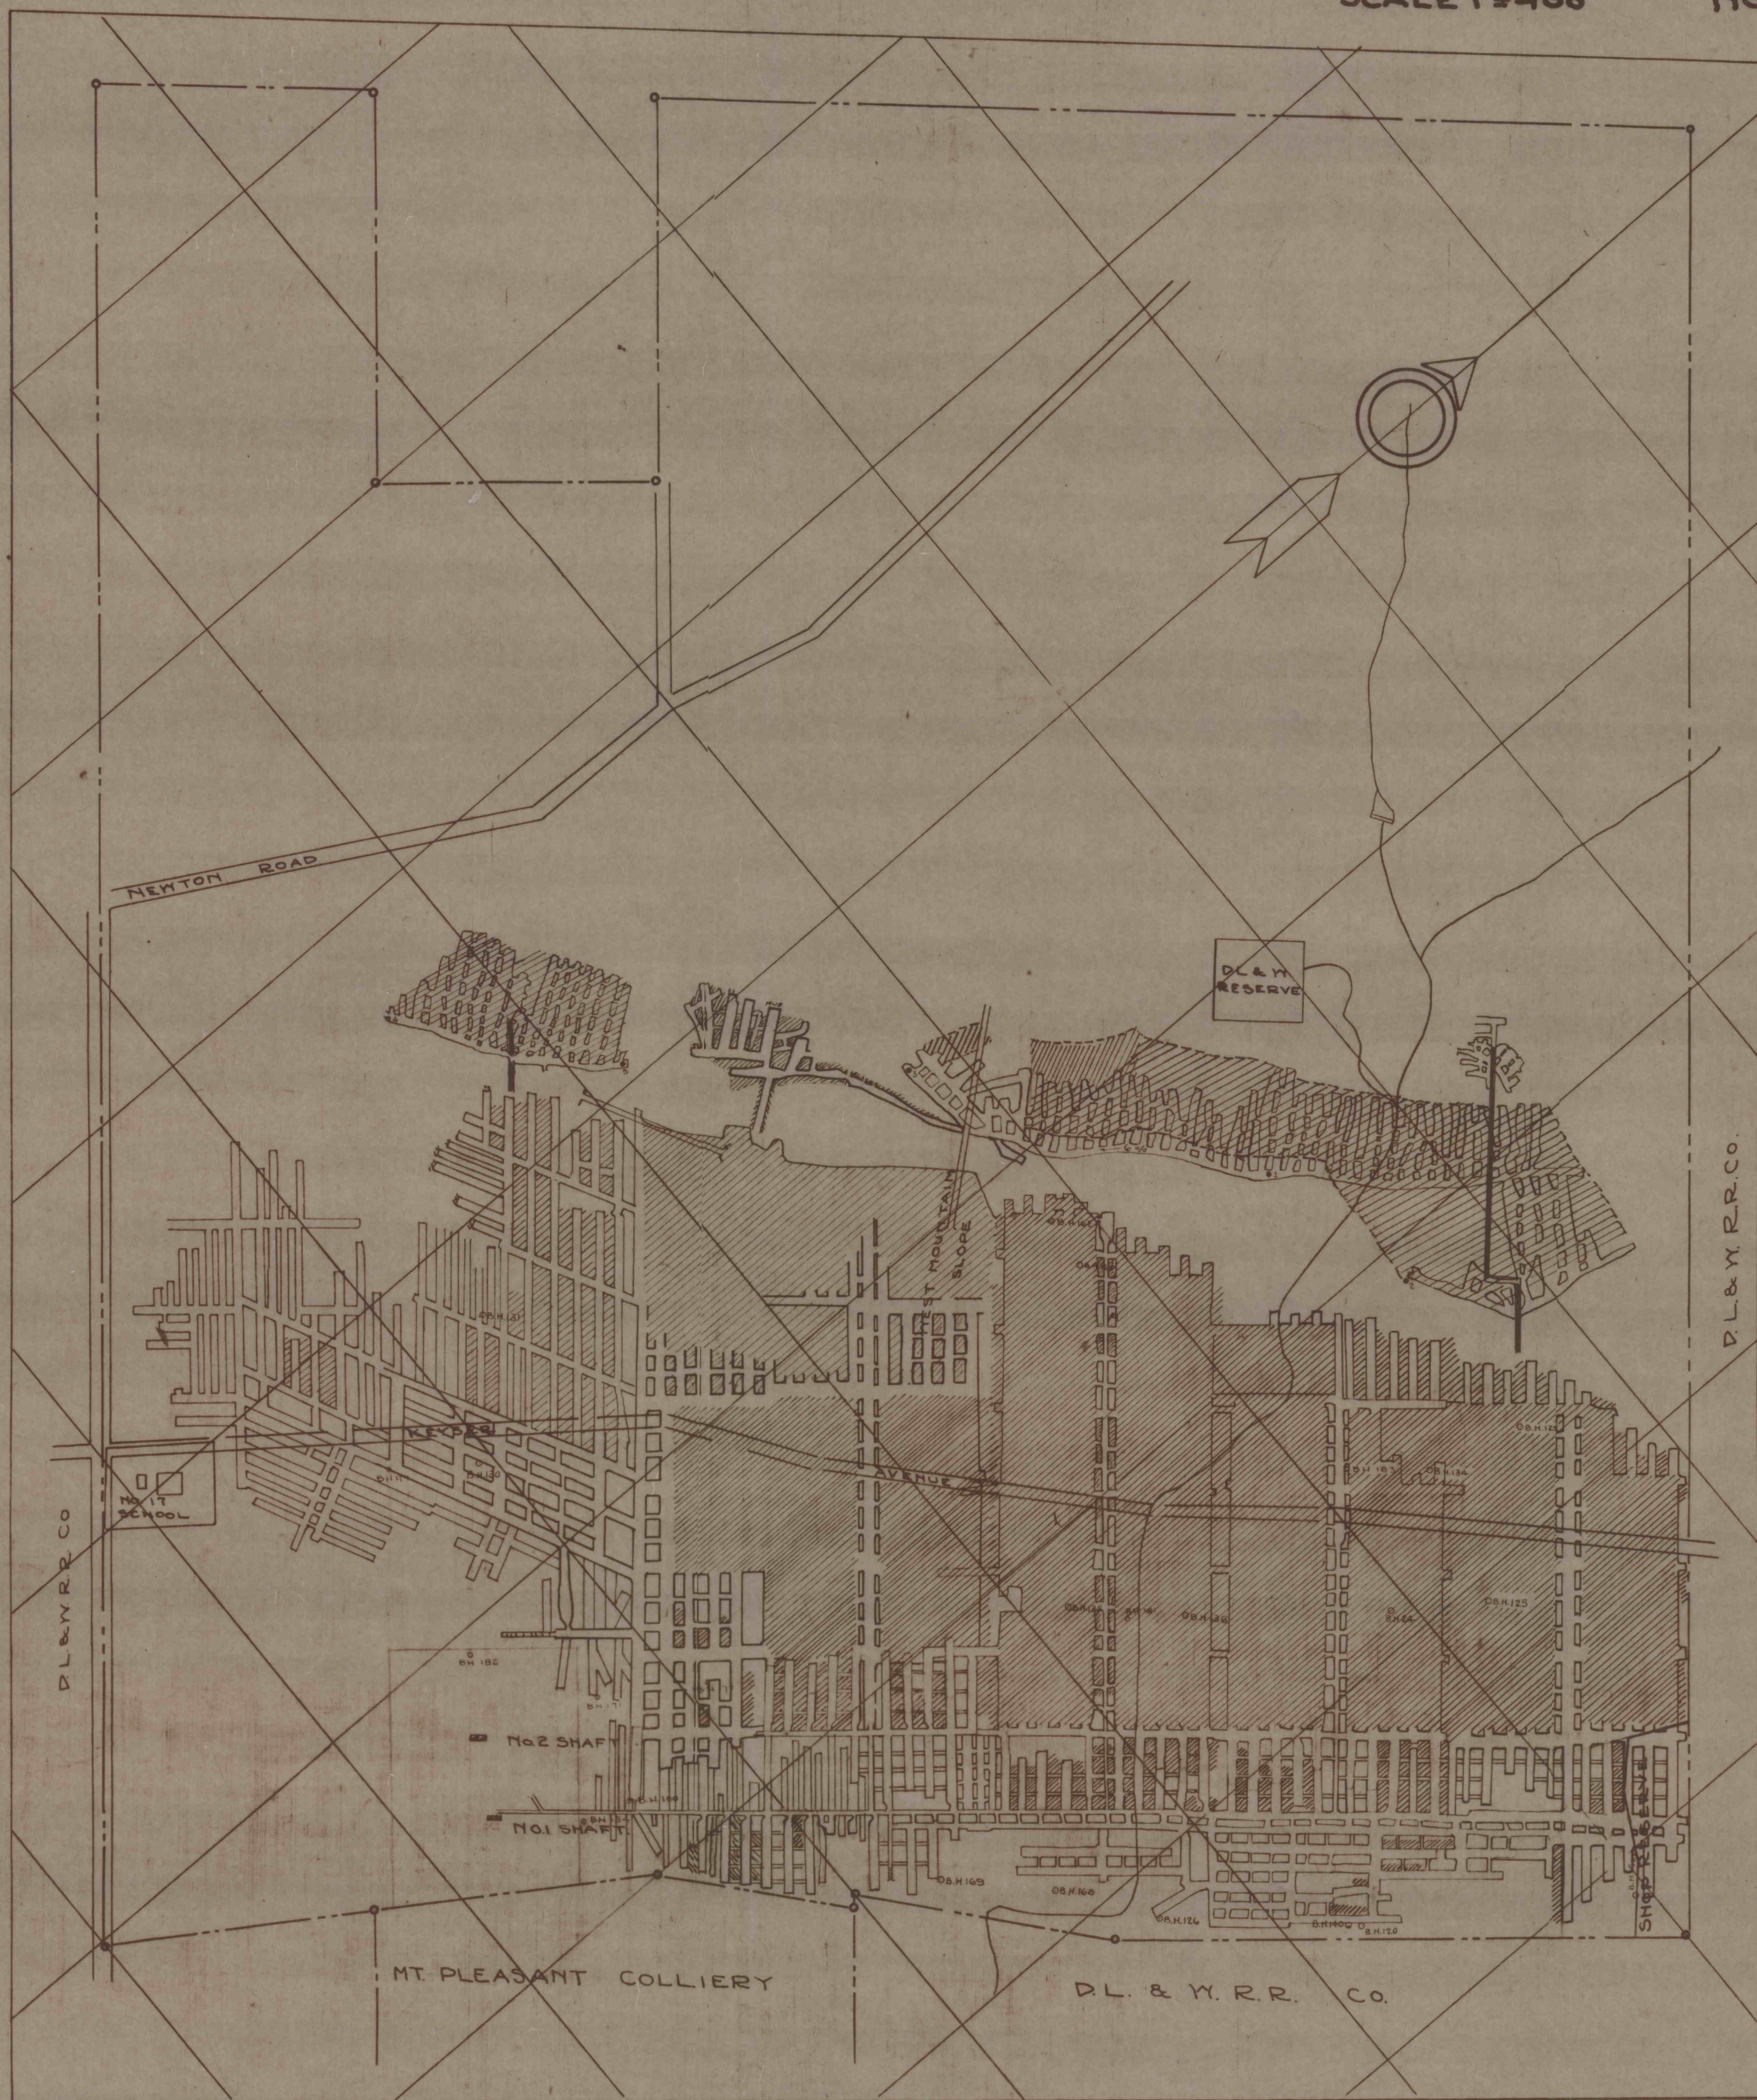

USE #