

Cd bones No 5 Dnn


DUNMORE No 2 VEIN
CAPOUSE COLLIERY
SCRANTON COAL CO.
Scale 400 ft = 1 in July 1, 1921

DL & W. R. R. CO.

DL & W. R. R. CO.

DL & W. R. R. CO.

D. L. & W. CAR
SHOP RESERVE

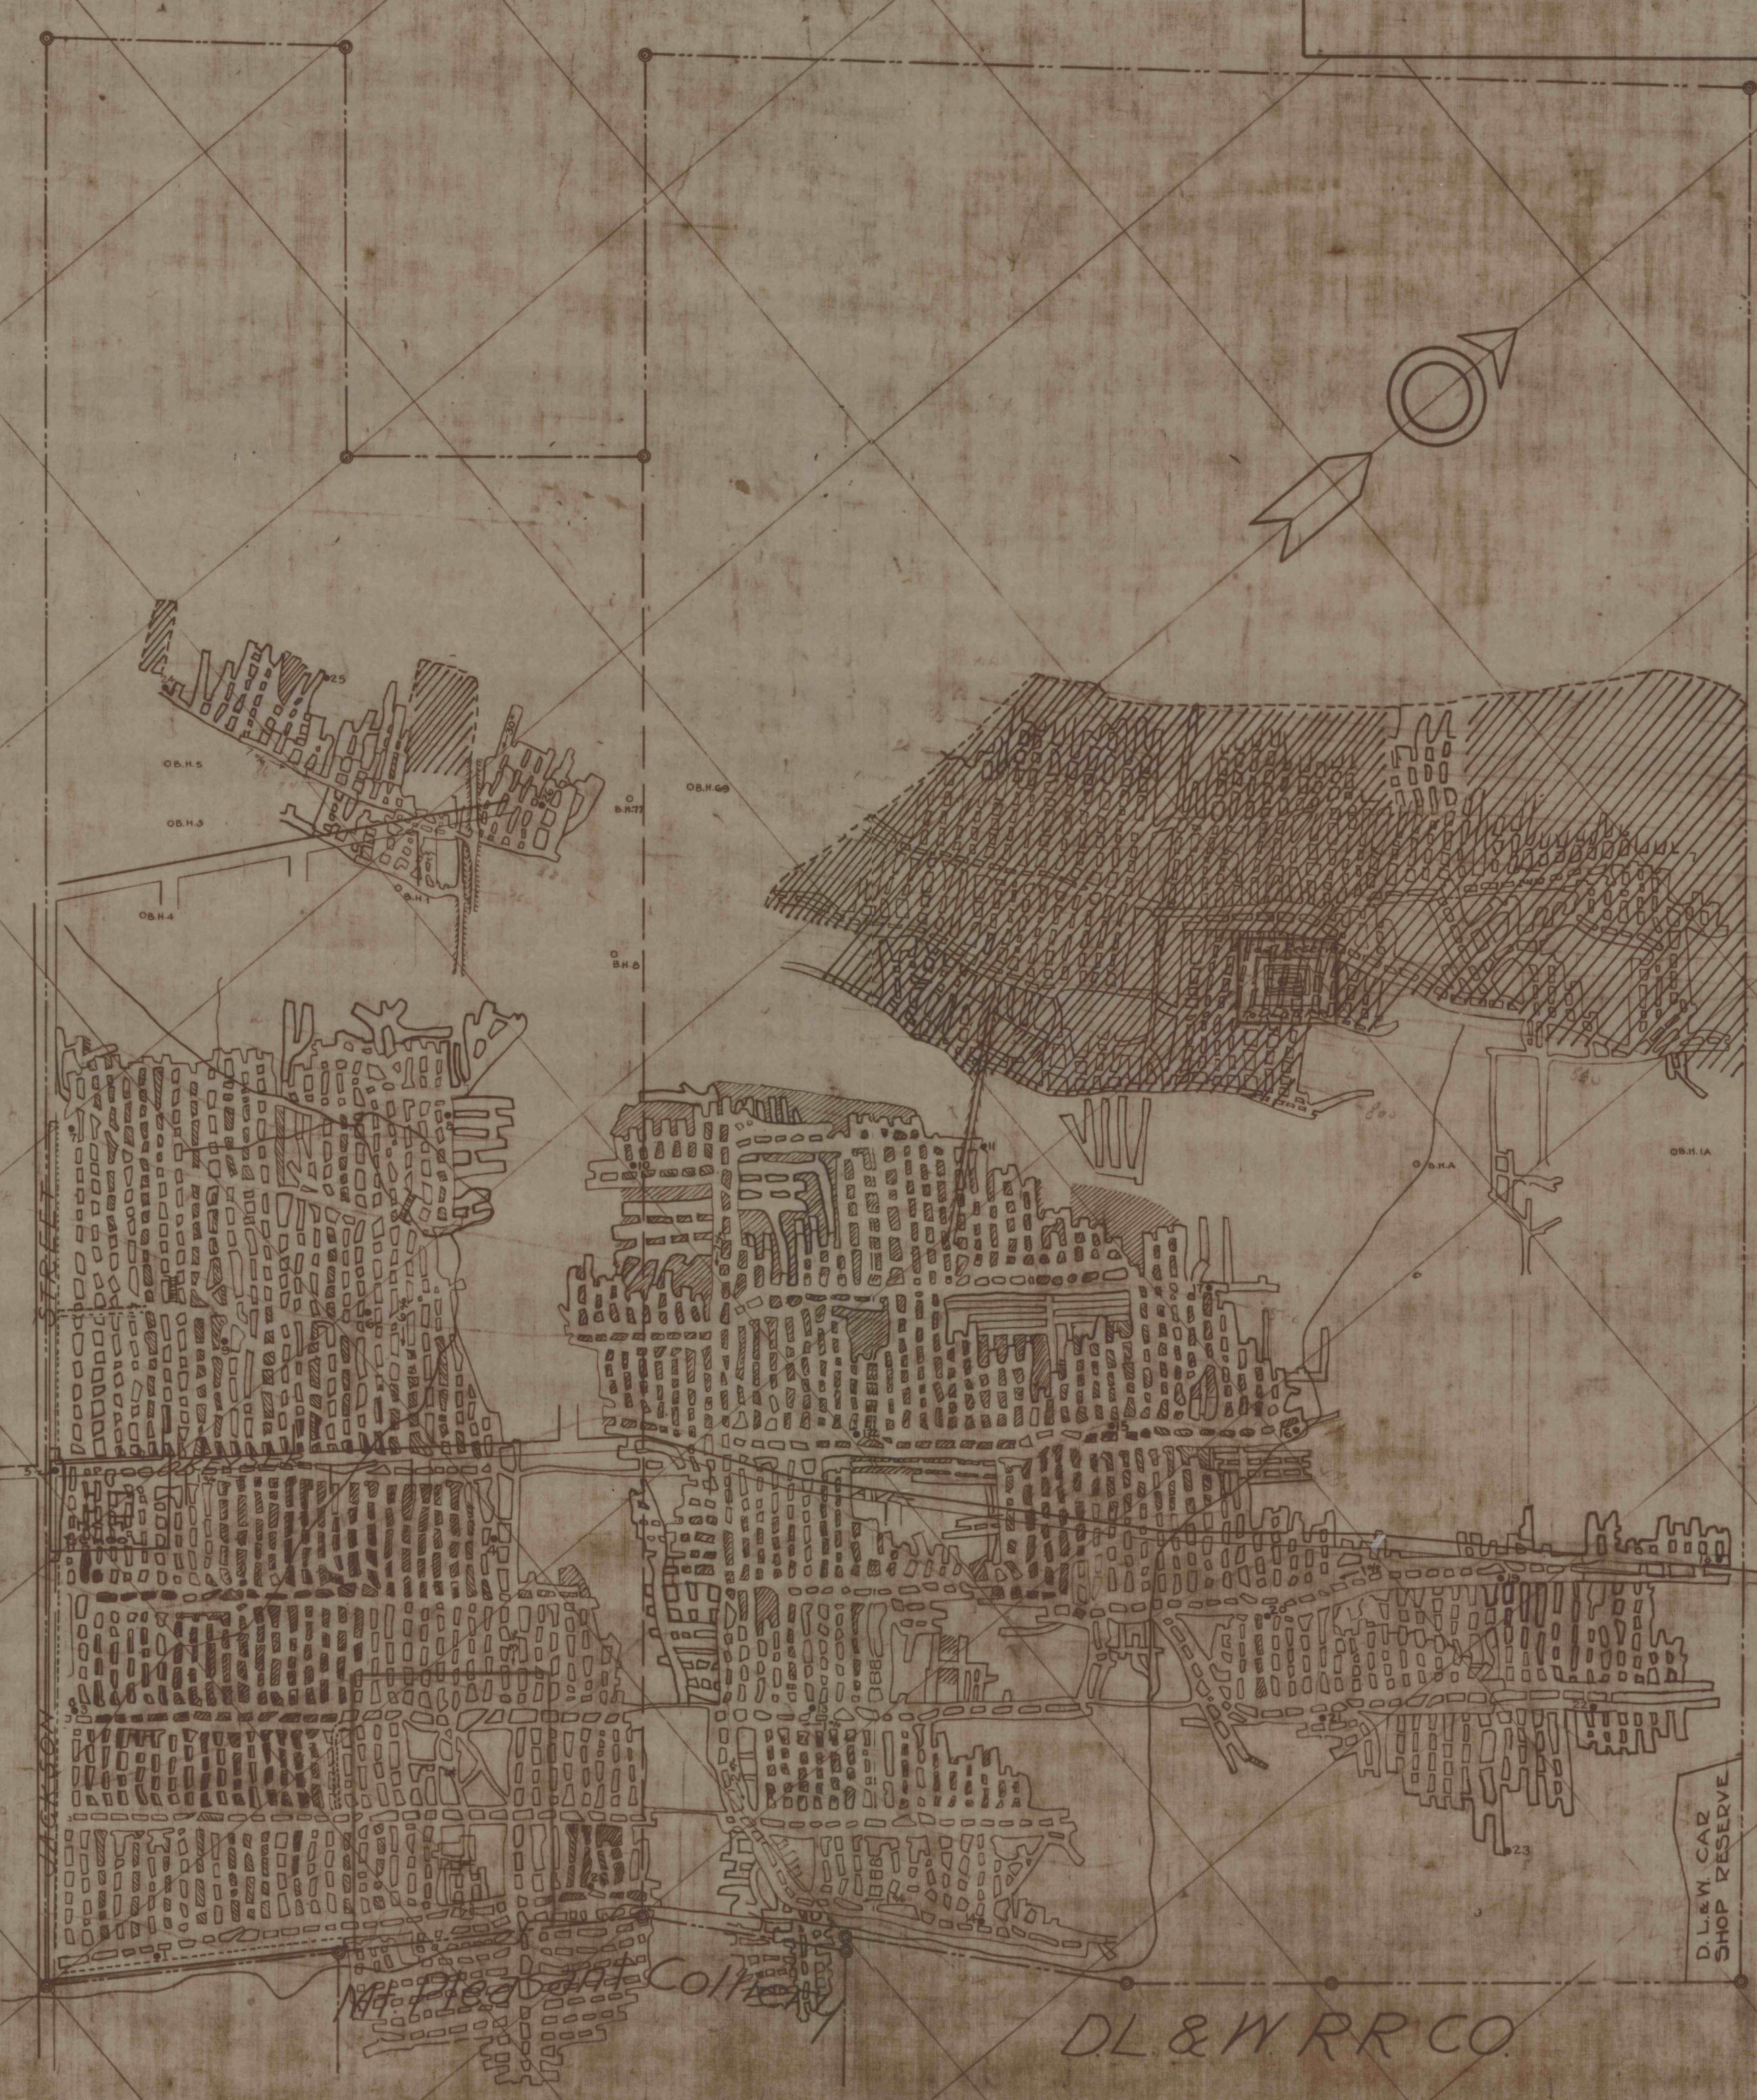

#451 5