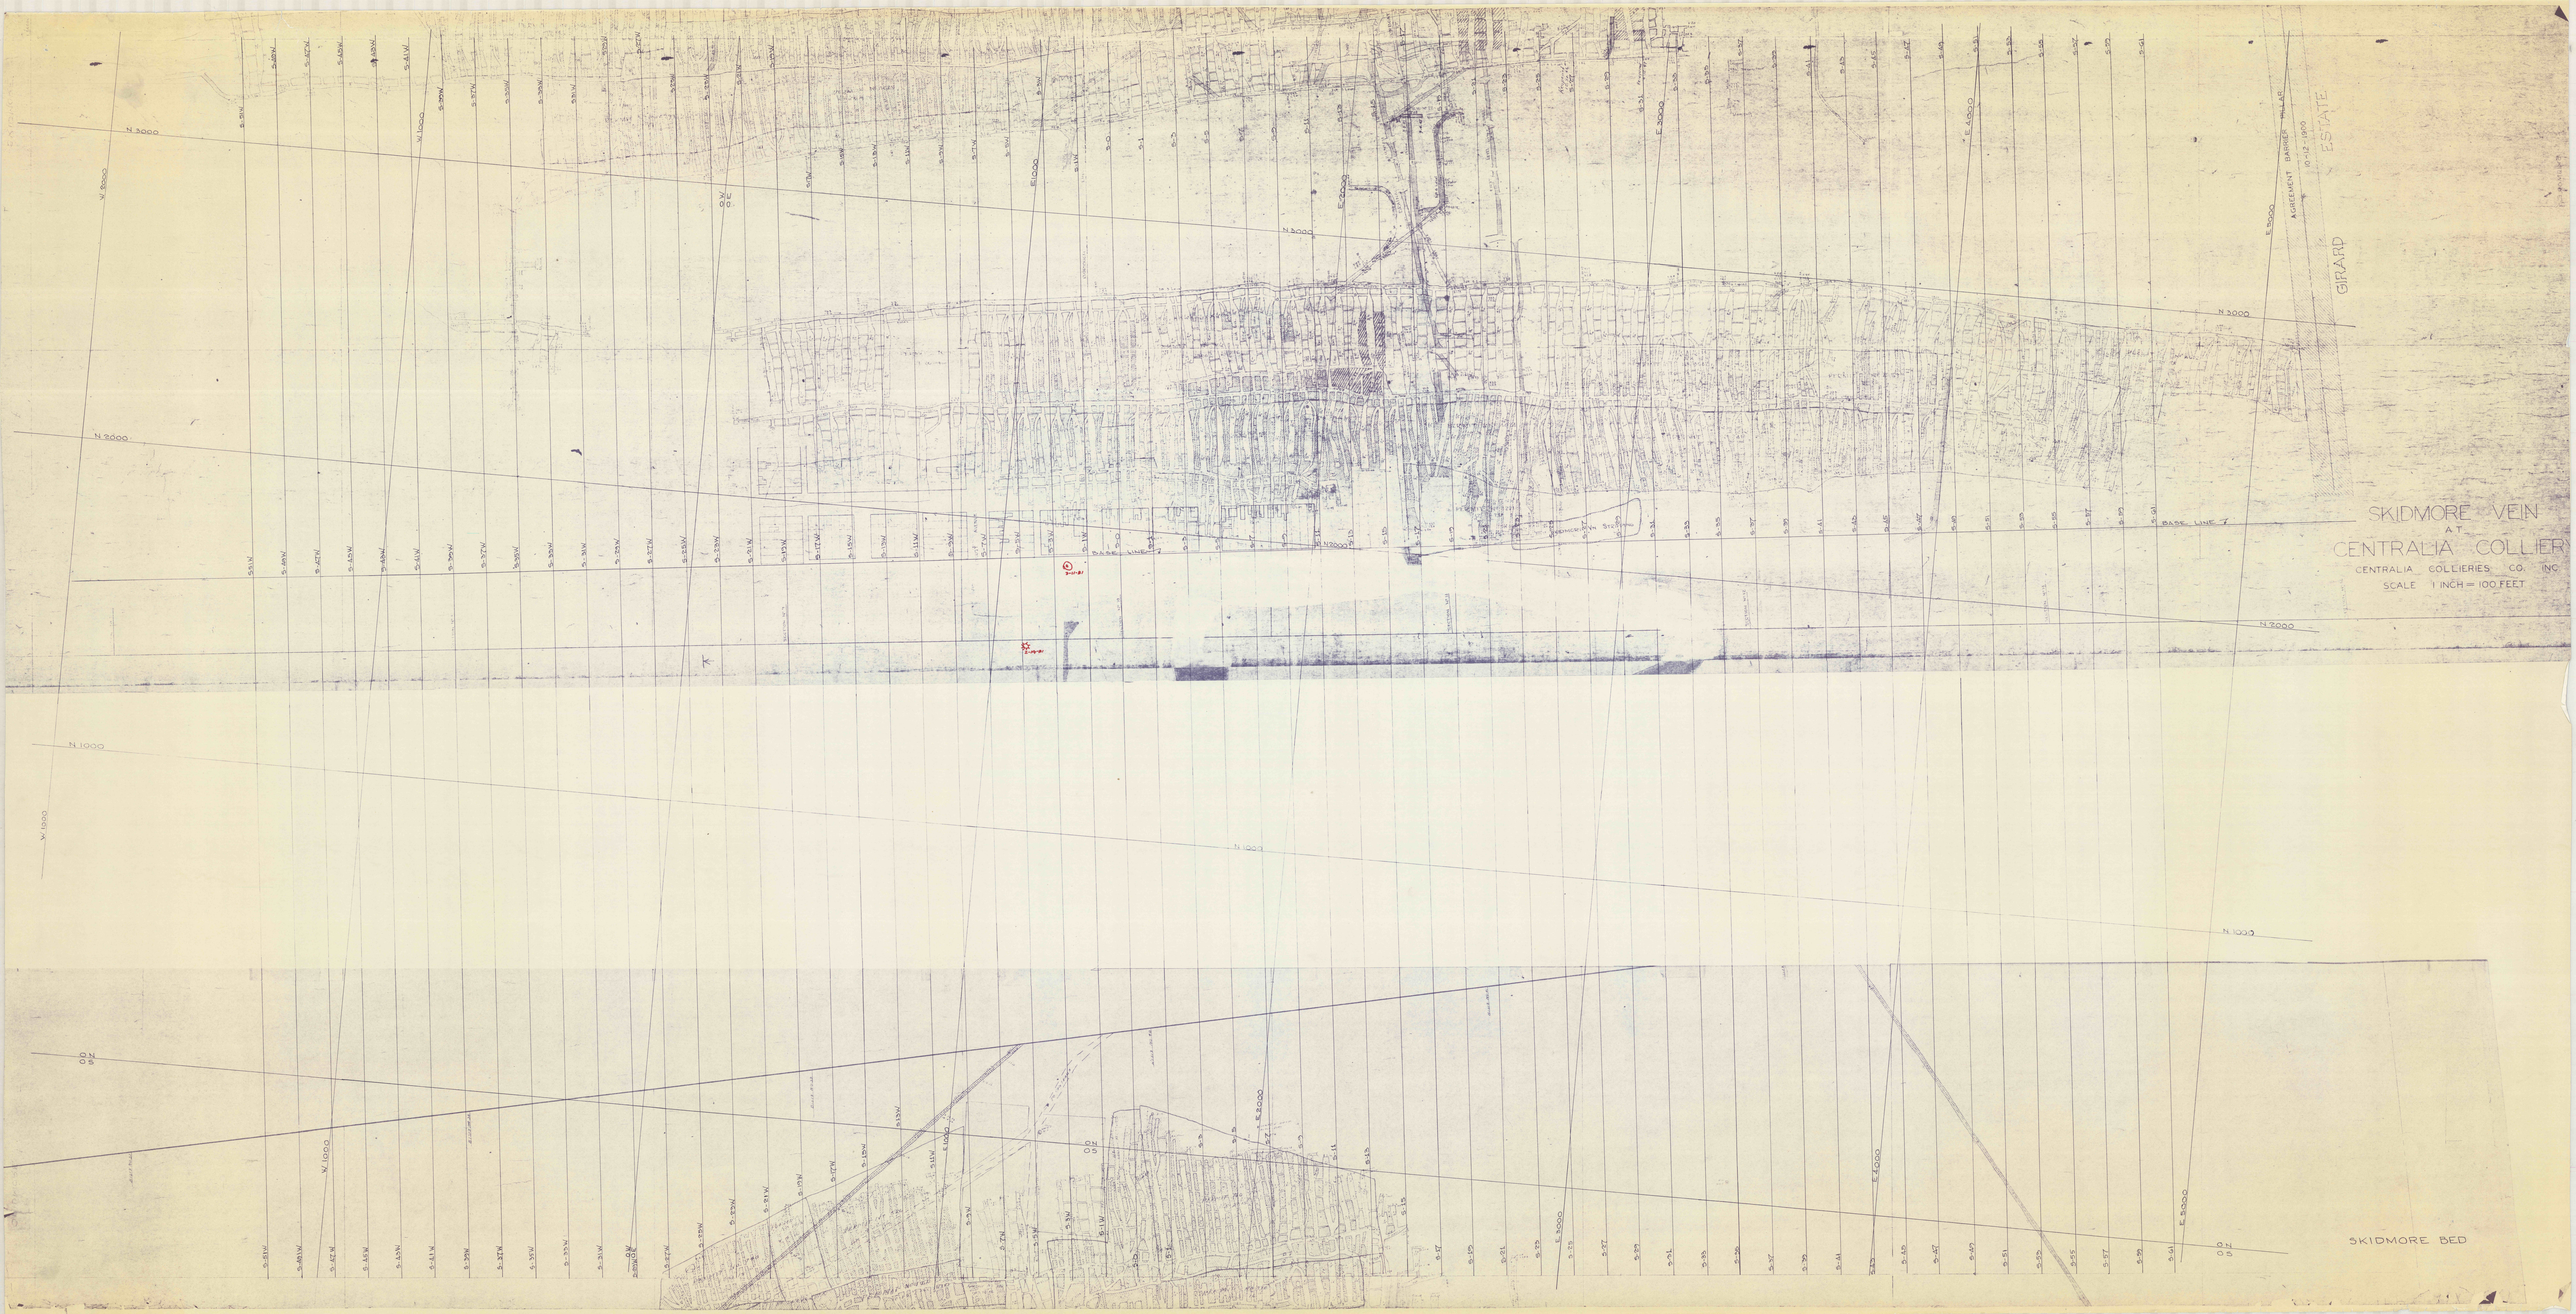
SKIDMORE VEIN
AT
CENTRALIA COLLIERY
CENTRALIA COLLIERIES CO. INC.
SCALE 1 INCH = 100 FEET
GIRARD ESTATE
AGREEMENT BARRIER
0-012-1900
SKIDMORE BED
BASE LINE
N 3000
N 2000
N 1000
W 8000
W 1000
E 2000
E 3000
E 4000
E 5000