


SEE D-885

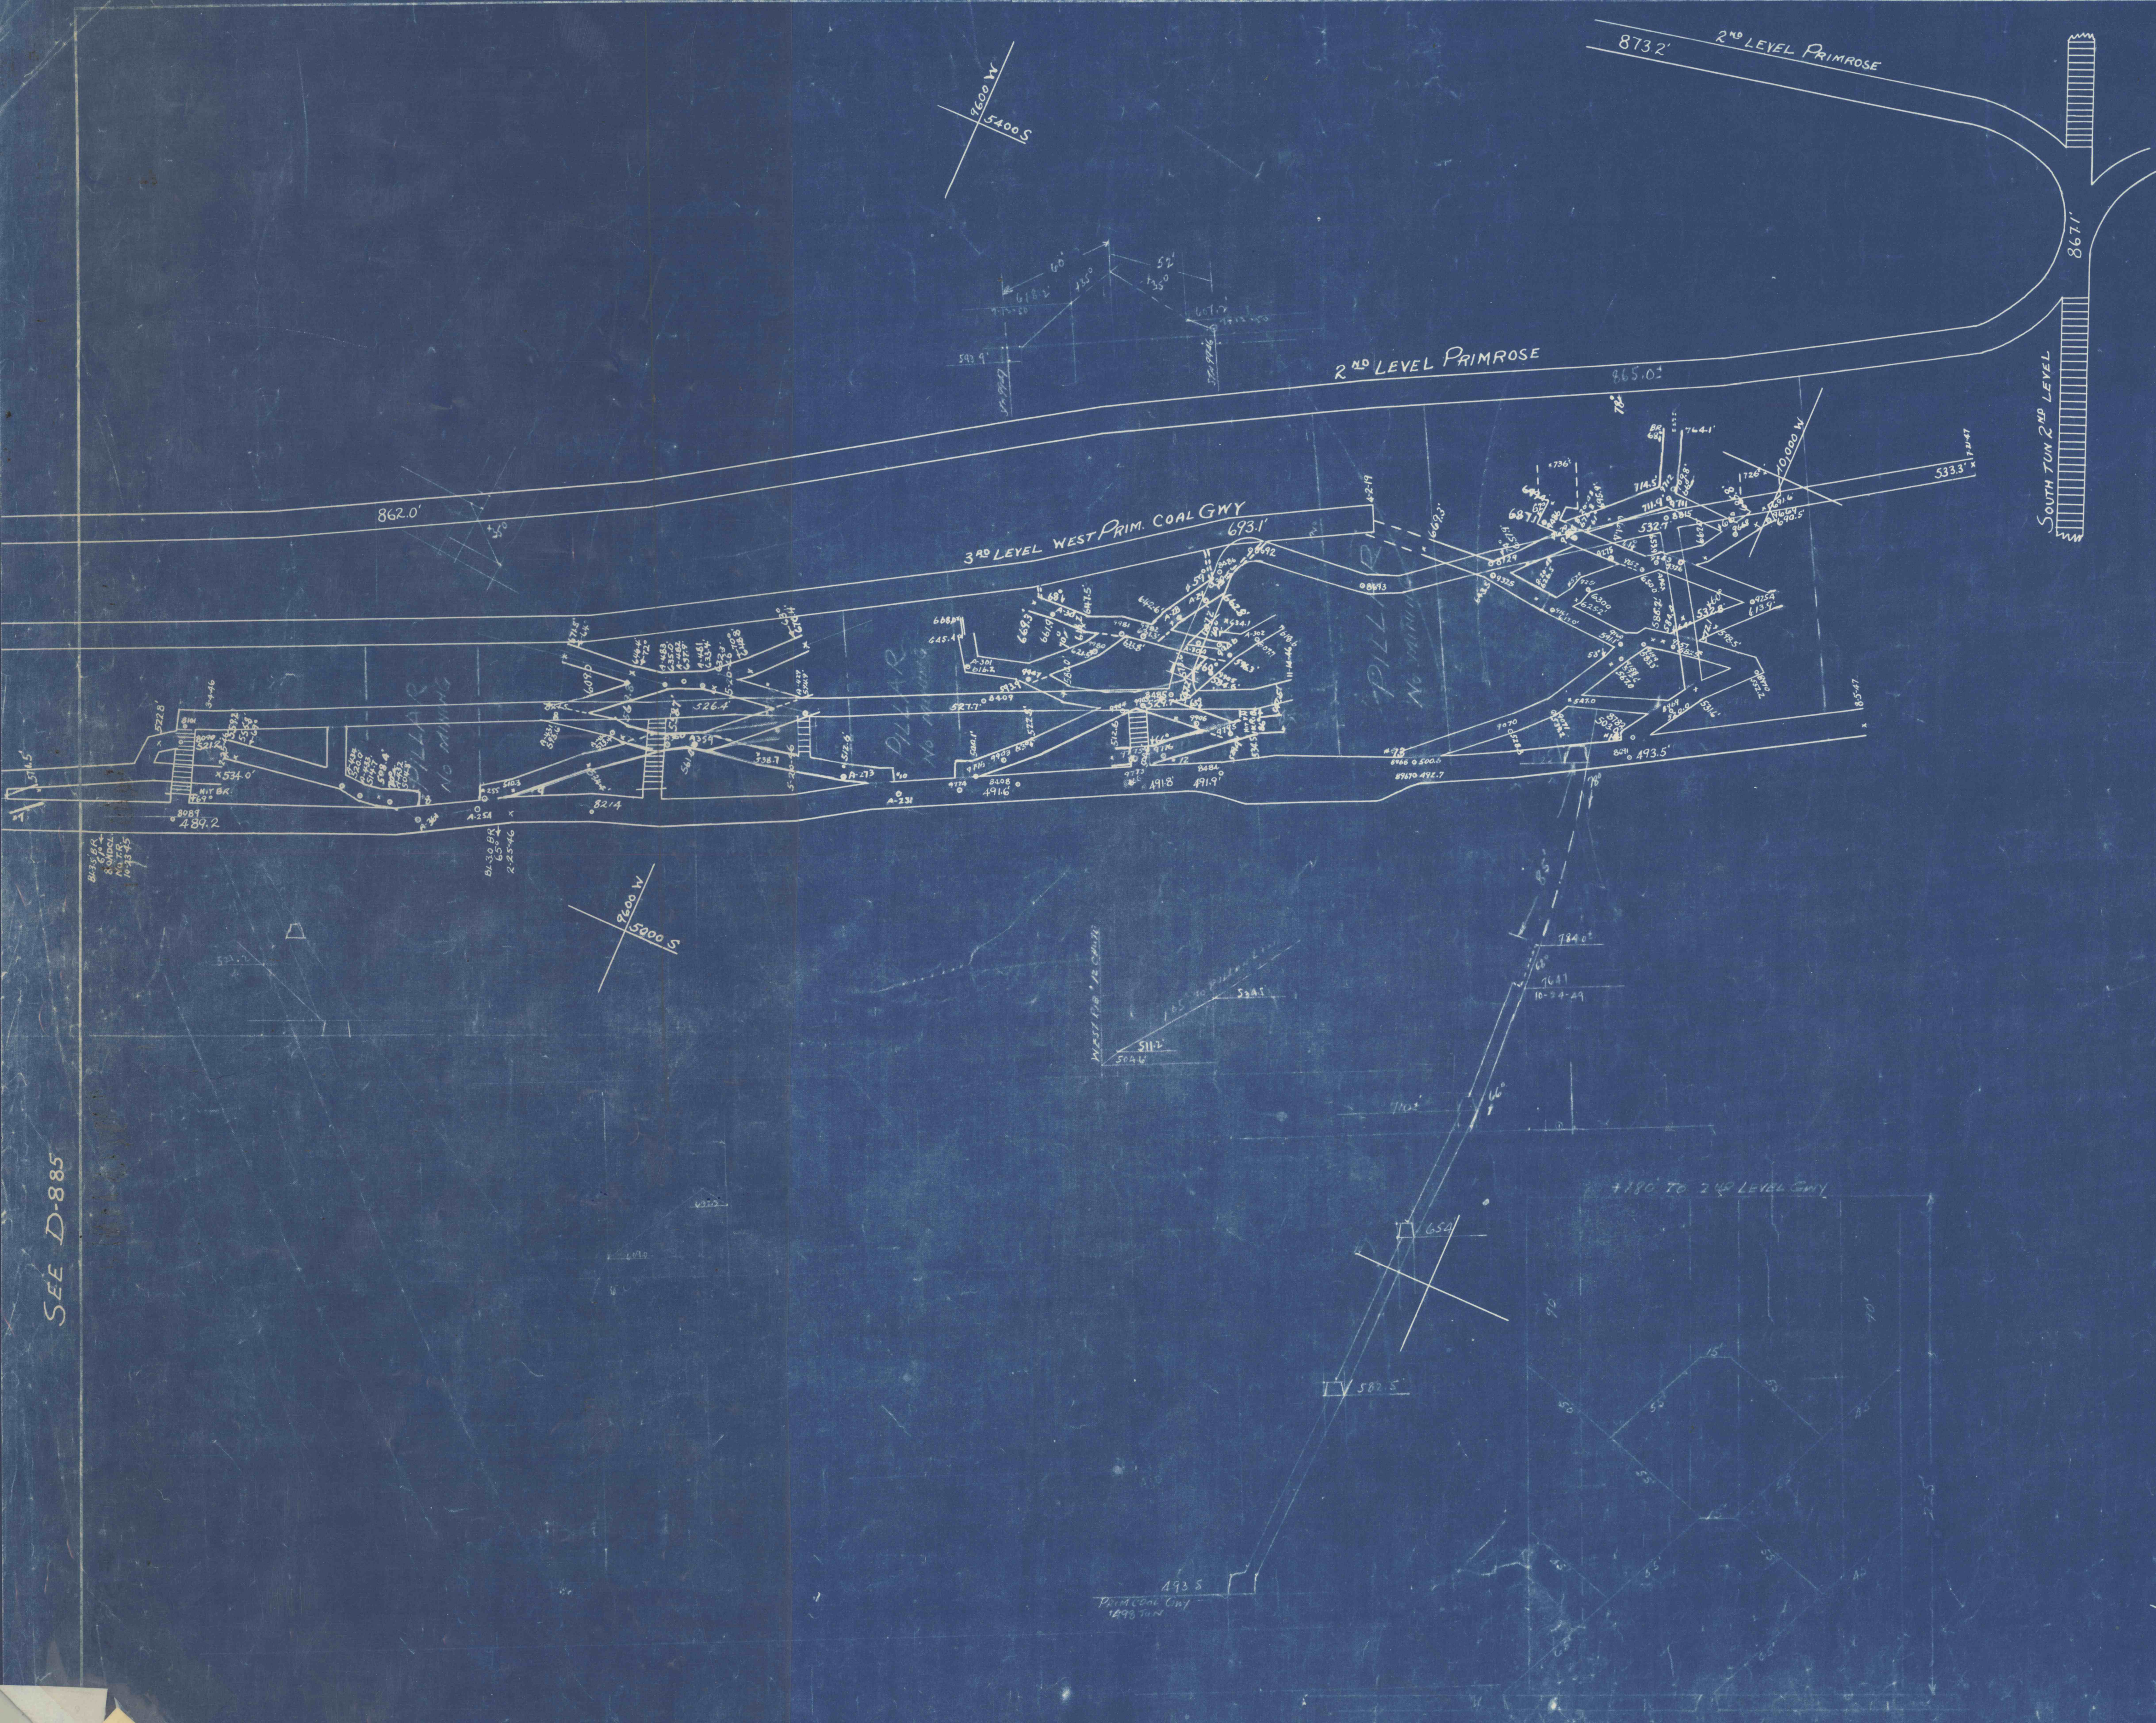

SOUTHERN FIELD
RAHN TWP. SCHUYLKILL
COUNTY PA.
2-OF-2.

LEHIGH NAVIGATION COAL CO. INC. LANSDOWN, PENNA. MINING ENGINEERING DEPT.	
COALDALE COLLIERY PLAN OF MINING IN WEST PRIMROSE GWY - "478 TUN."	
SCALE: 1"=40'	DATE: 8-19-47
MADE BY: A.S.B.	TRACED BY: A.S.B.
REVISOR:	CHECKED BY:
APPROVED:	
MIN. ENGR. DIST. SUPT. V.P. & GEN. MGR.	
D 939	