


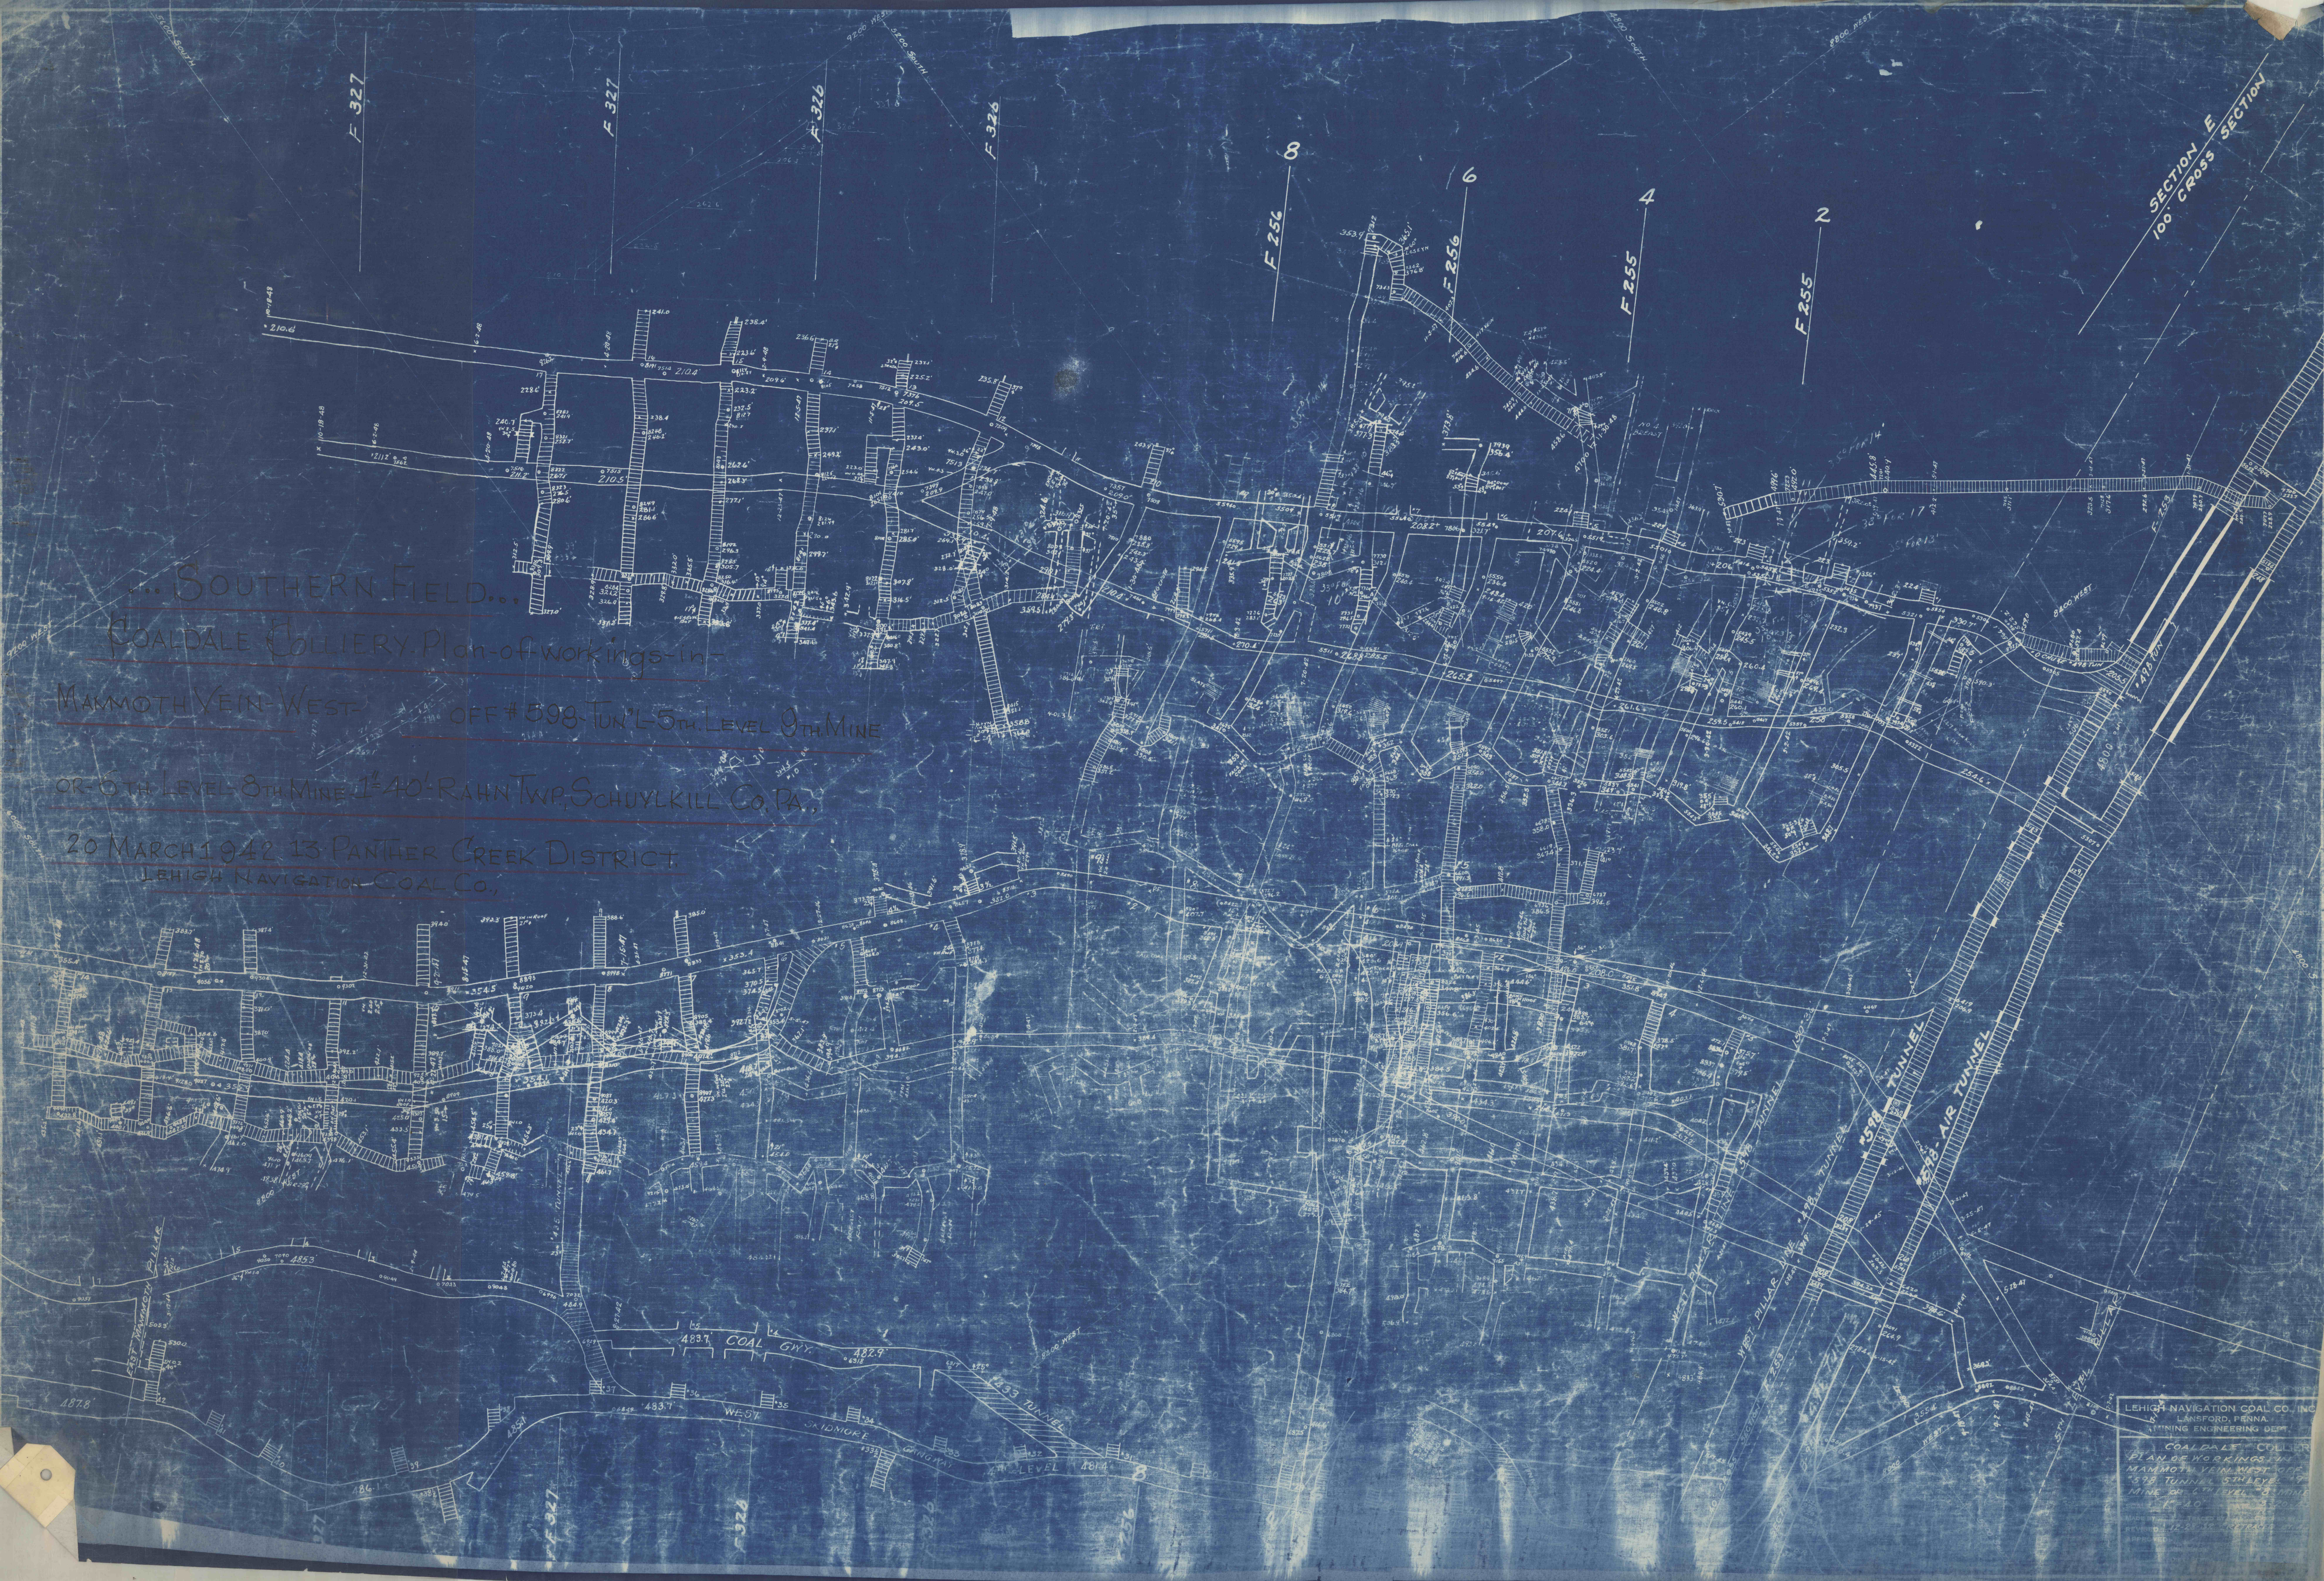

LEHIGH NAVIGATION COAL CO. INC.
LANSFORD, PENNA.
MINING ENGINEERING DEPT.

COALDALE COLLIER
PLAN OF WORKINGS IN
MAMMOTH VEIN WEST GFB
578 TUNNEL 5TH LEVEL "9"
MINE OR 6TH LEVEL "8" MINE
SCALE 1"=40' 578-20-25
MADE BY _____ TRACED BY _____
REVISED BY 12-22-59 RETRACED BY _____