


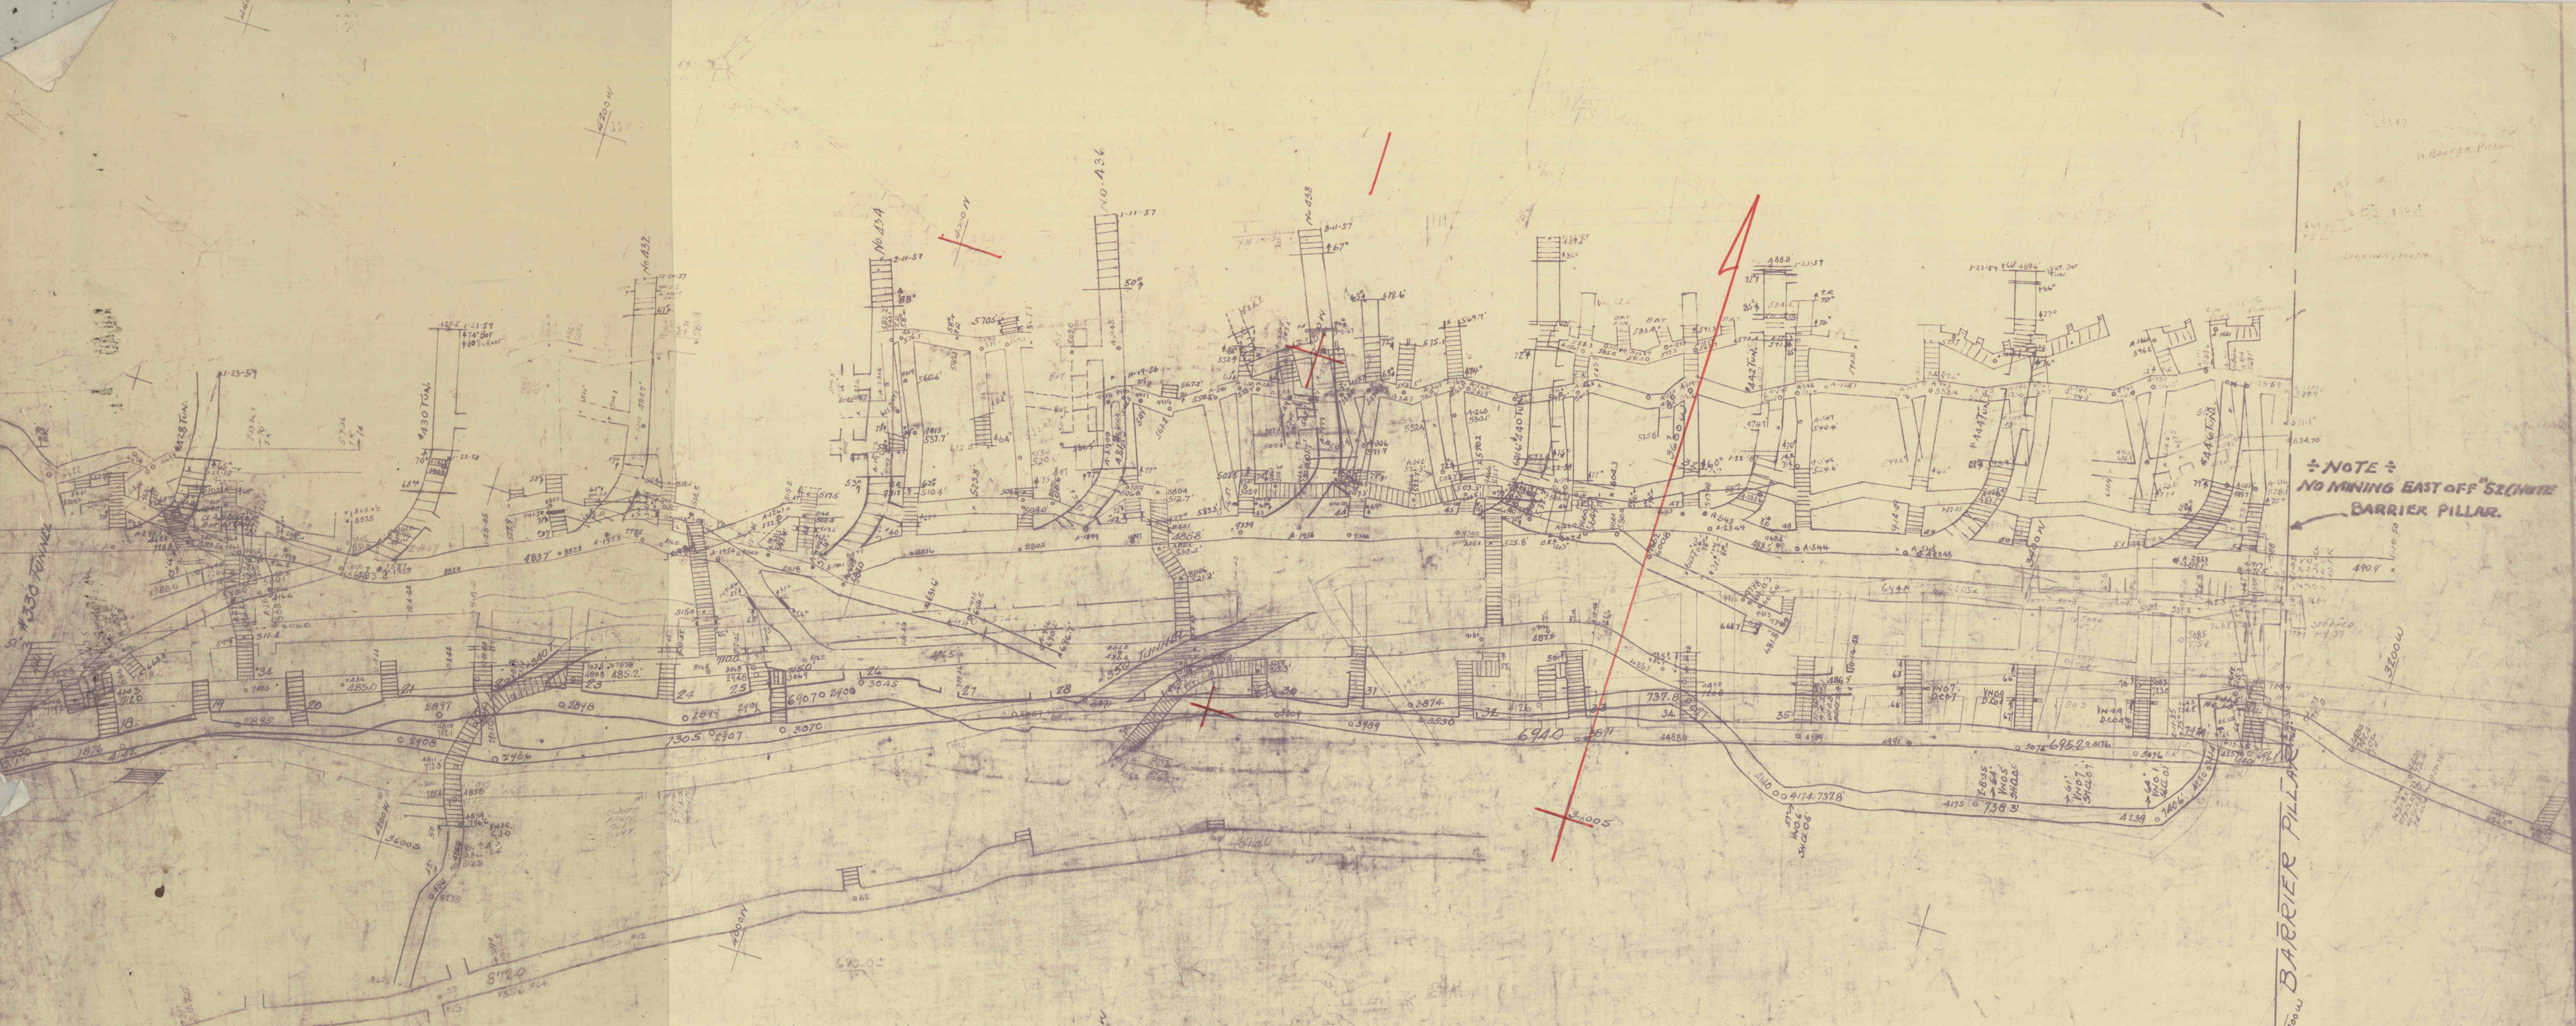

SOUTHERN FIELD..1"=40'.
COALDALE COLLY. EAST SKIDMORE GWY,
& AIRWAY TUN'L #320. TUN'L FROM #330 TUN'L
TO BARRIER PILLAR, 3RD LEVEL.
MAUCH CHUK TWP. CARBON COUNTY,
LANSFORD, PA. LEHIGH NAVIGATION COAL CO., INC.

LEHIGH NAVIGATION COAL COMPANY
LANSFORD, PENNA.
MINING ENGINEERING DEPT.
COALDALE COLLIERY
SKETCH SHOWING EAST SKIDMORE
GANGWAY & AIRWAY #320 TUNNEL
FROM #330 TUNNEL TO BARRIER
PILLAR, 3RD LEVEL, 1935
SCALE 1"=40' DATE 2/11/35
MADE BY J.G. TRACY & J.G. CHAPMAN
REVISED
APPROVED
J. MILLER
D781