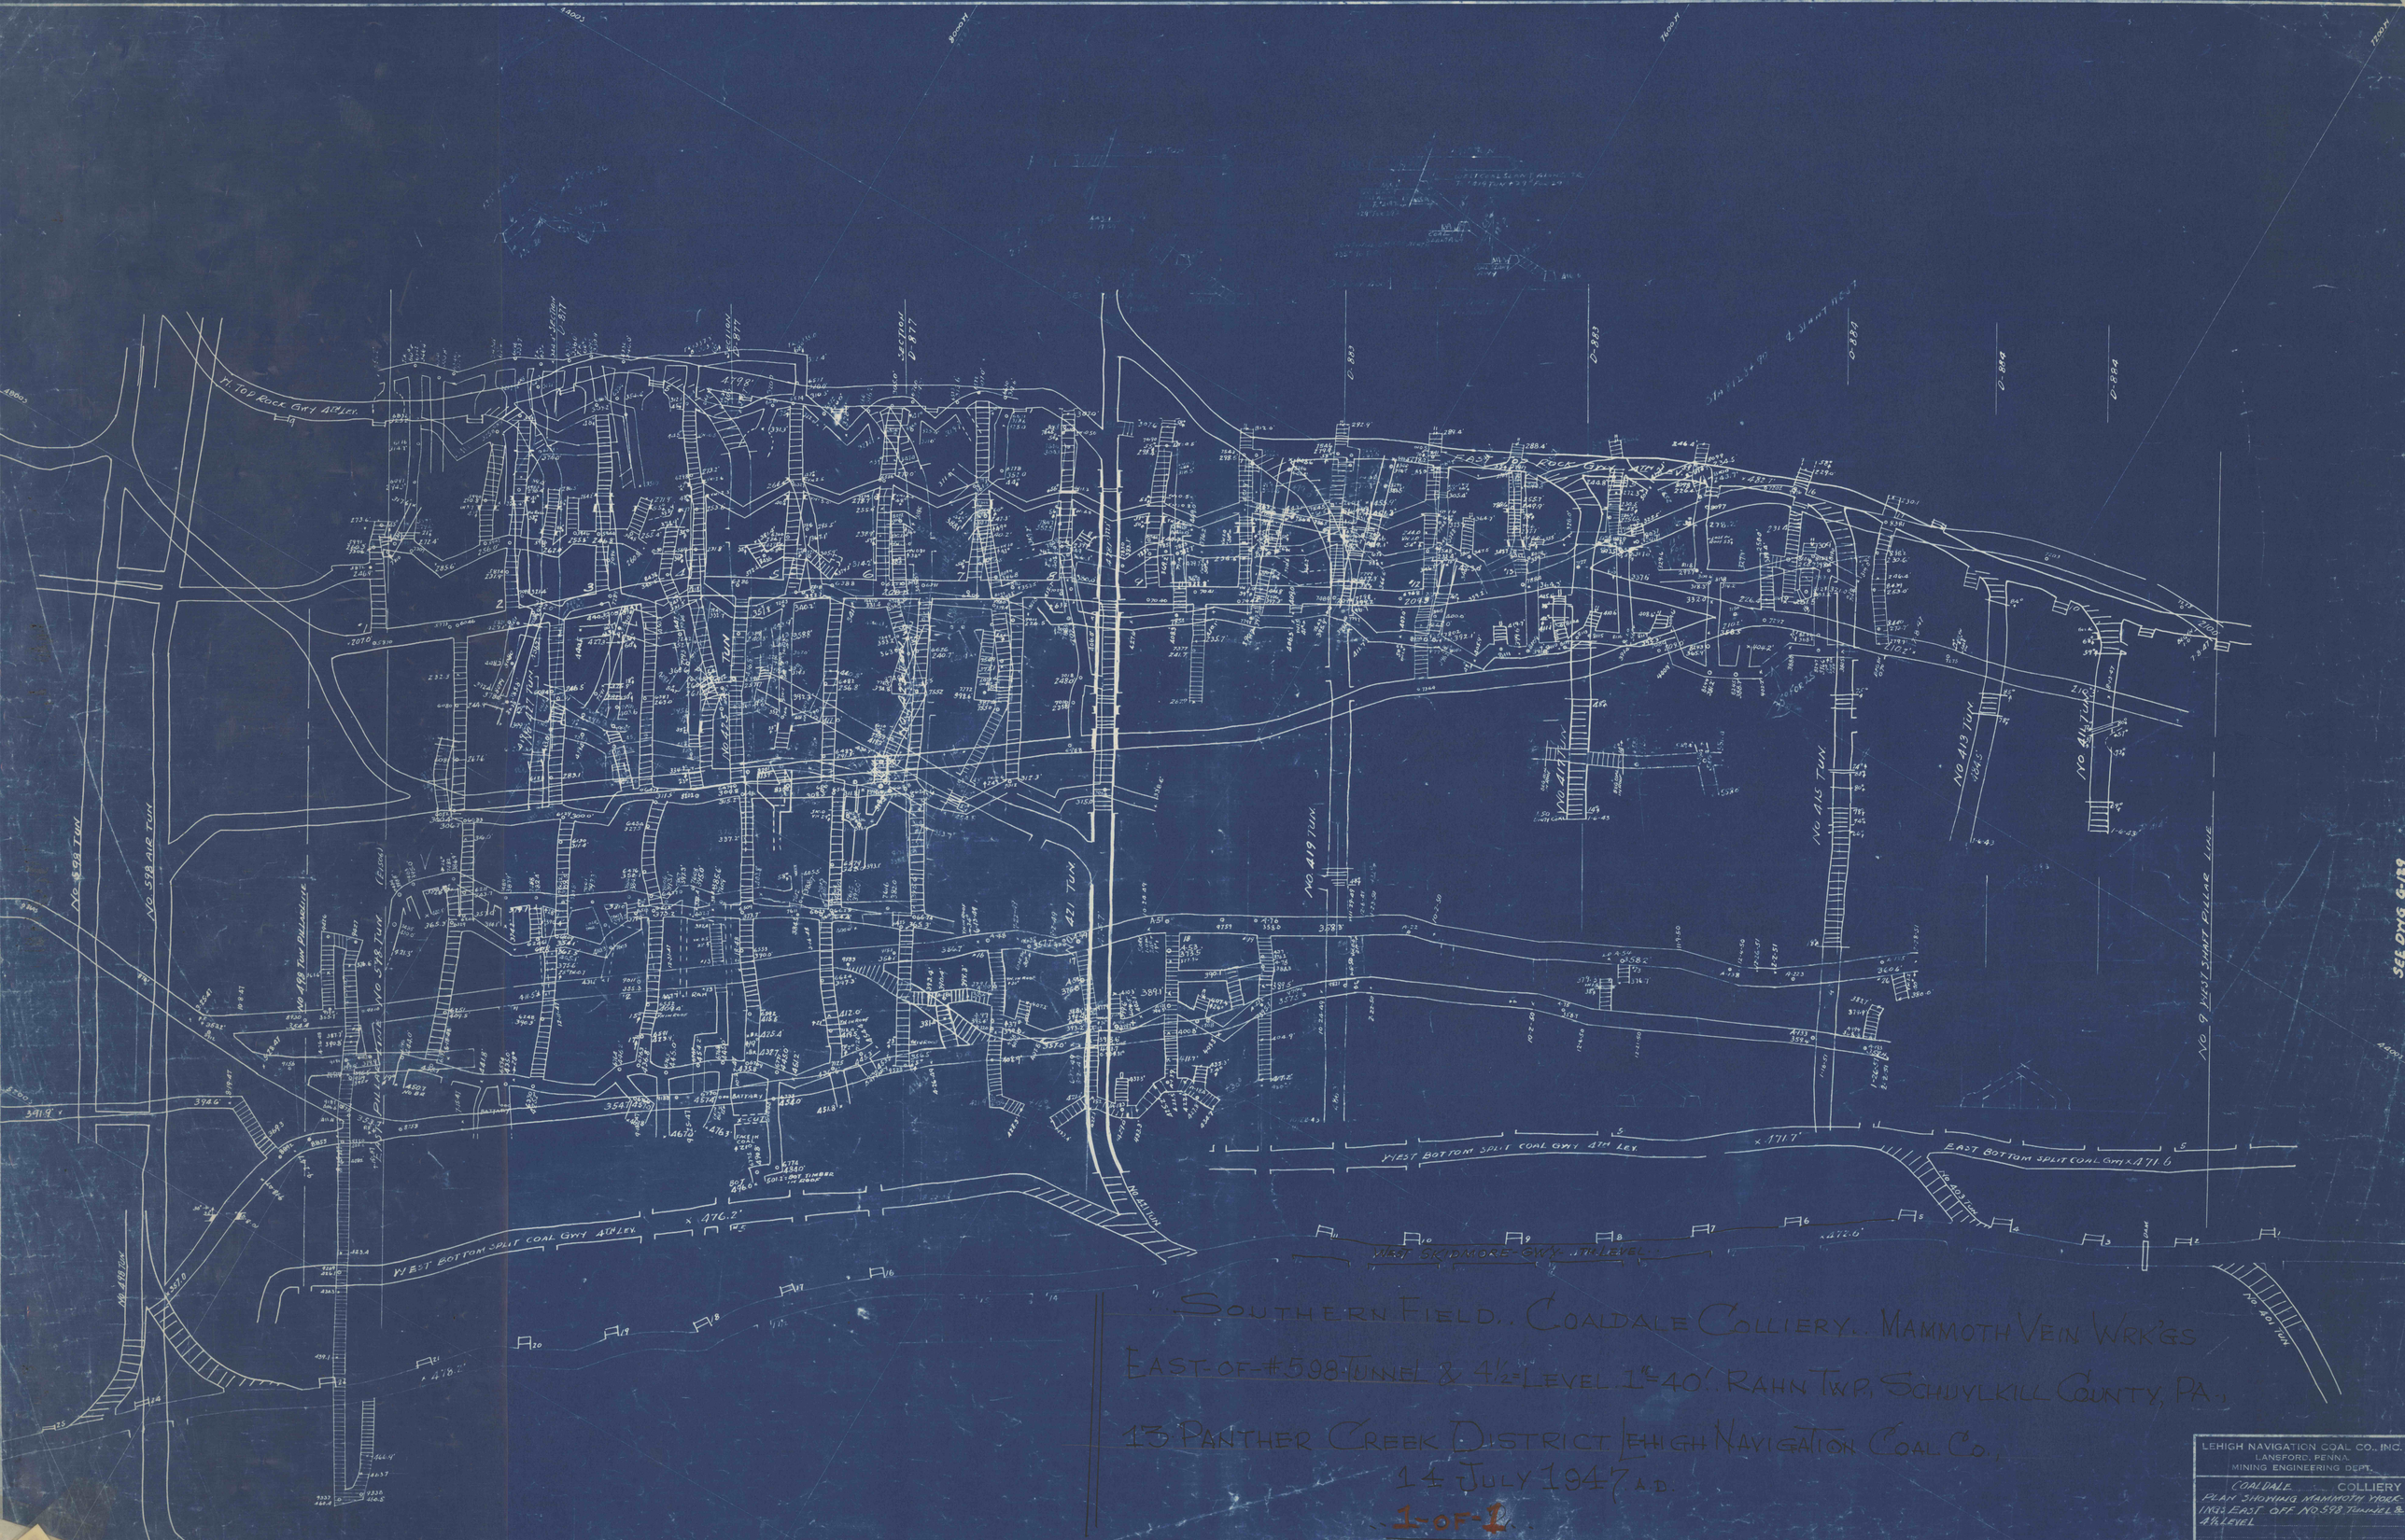

SOUTHERN FIELD, COALDALE COLLIERY, MAMMOTH VEIN WRK'GS

EAST OF #598 TUNEL & 4½ LEVEL 1" = 40', RAHN TWP, SCHUYLKILL COUNTY, PA.,

PANTHER CREEK DISTRICT LEHIGH NAVIGATION COAL CO.,

14 JULY 1947 A.D.

1 OF 1

LEHIGH NAVIGATION COAL CO., INC.
LANSFORD, PENNA.
MINING ENGINEERING DEPT.

COALDALE COLLIERY
PLAN SHOWING MAMMOTH WORKINGS EAST OFF NO. 598 TUNNEL & 4½ LEVEL

SCALE 1" = 40' DATE JULY 14, 1947
MADE BY TRACED BY G.A.K. CHECKED BY
REVISED
APPROVED
ENG. ENGR.
DIST. SUPT.

G304