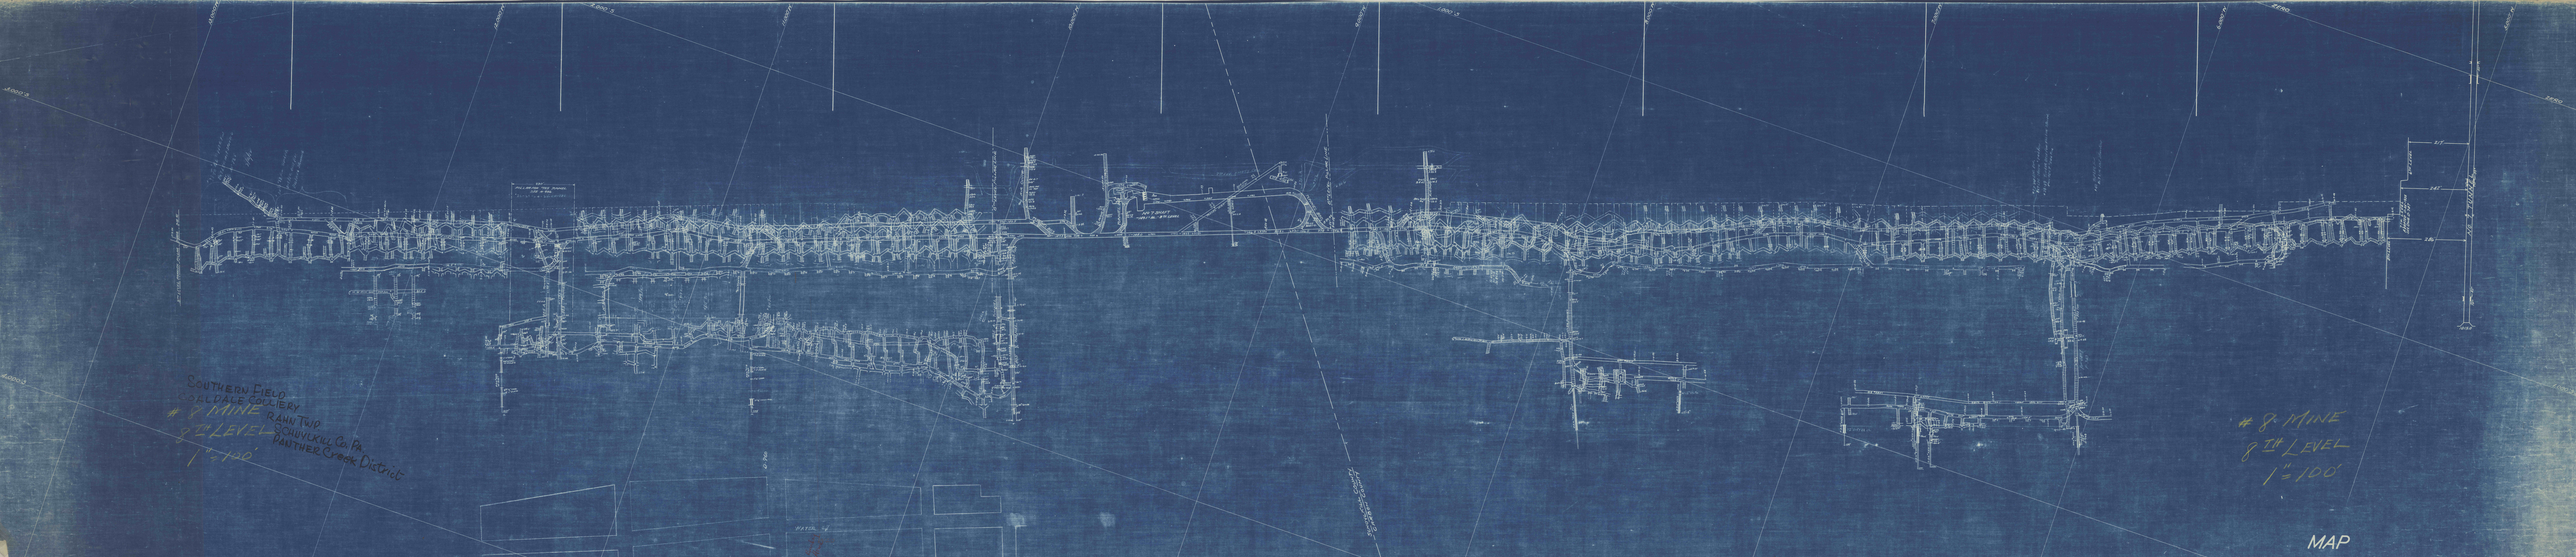
SOUTHERN FIELD
COALDALE COLLIERY
8 MINE
8TH LEVEL
1" = 100'
RAHN TWP
SCHUYLKILL Co. PA.
PANTHER Creek District
8 MINE
8 TH LEVEL
1" = 100'
MAP