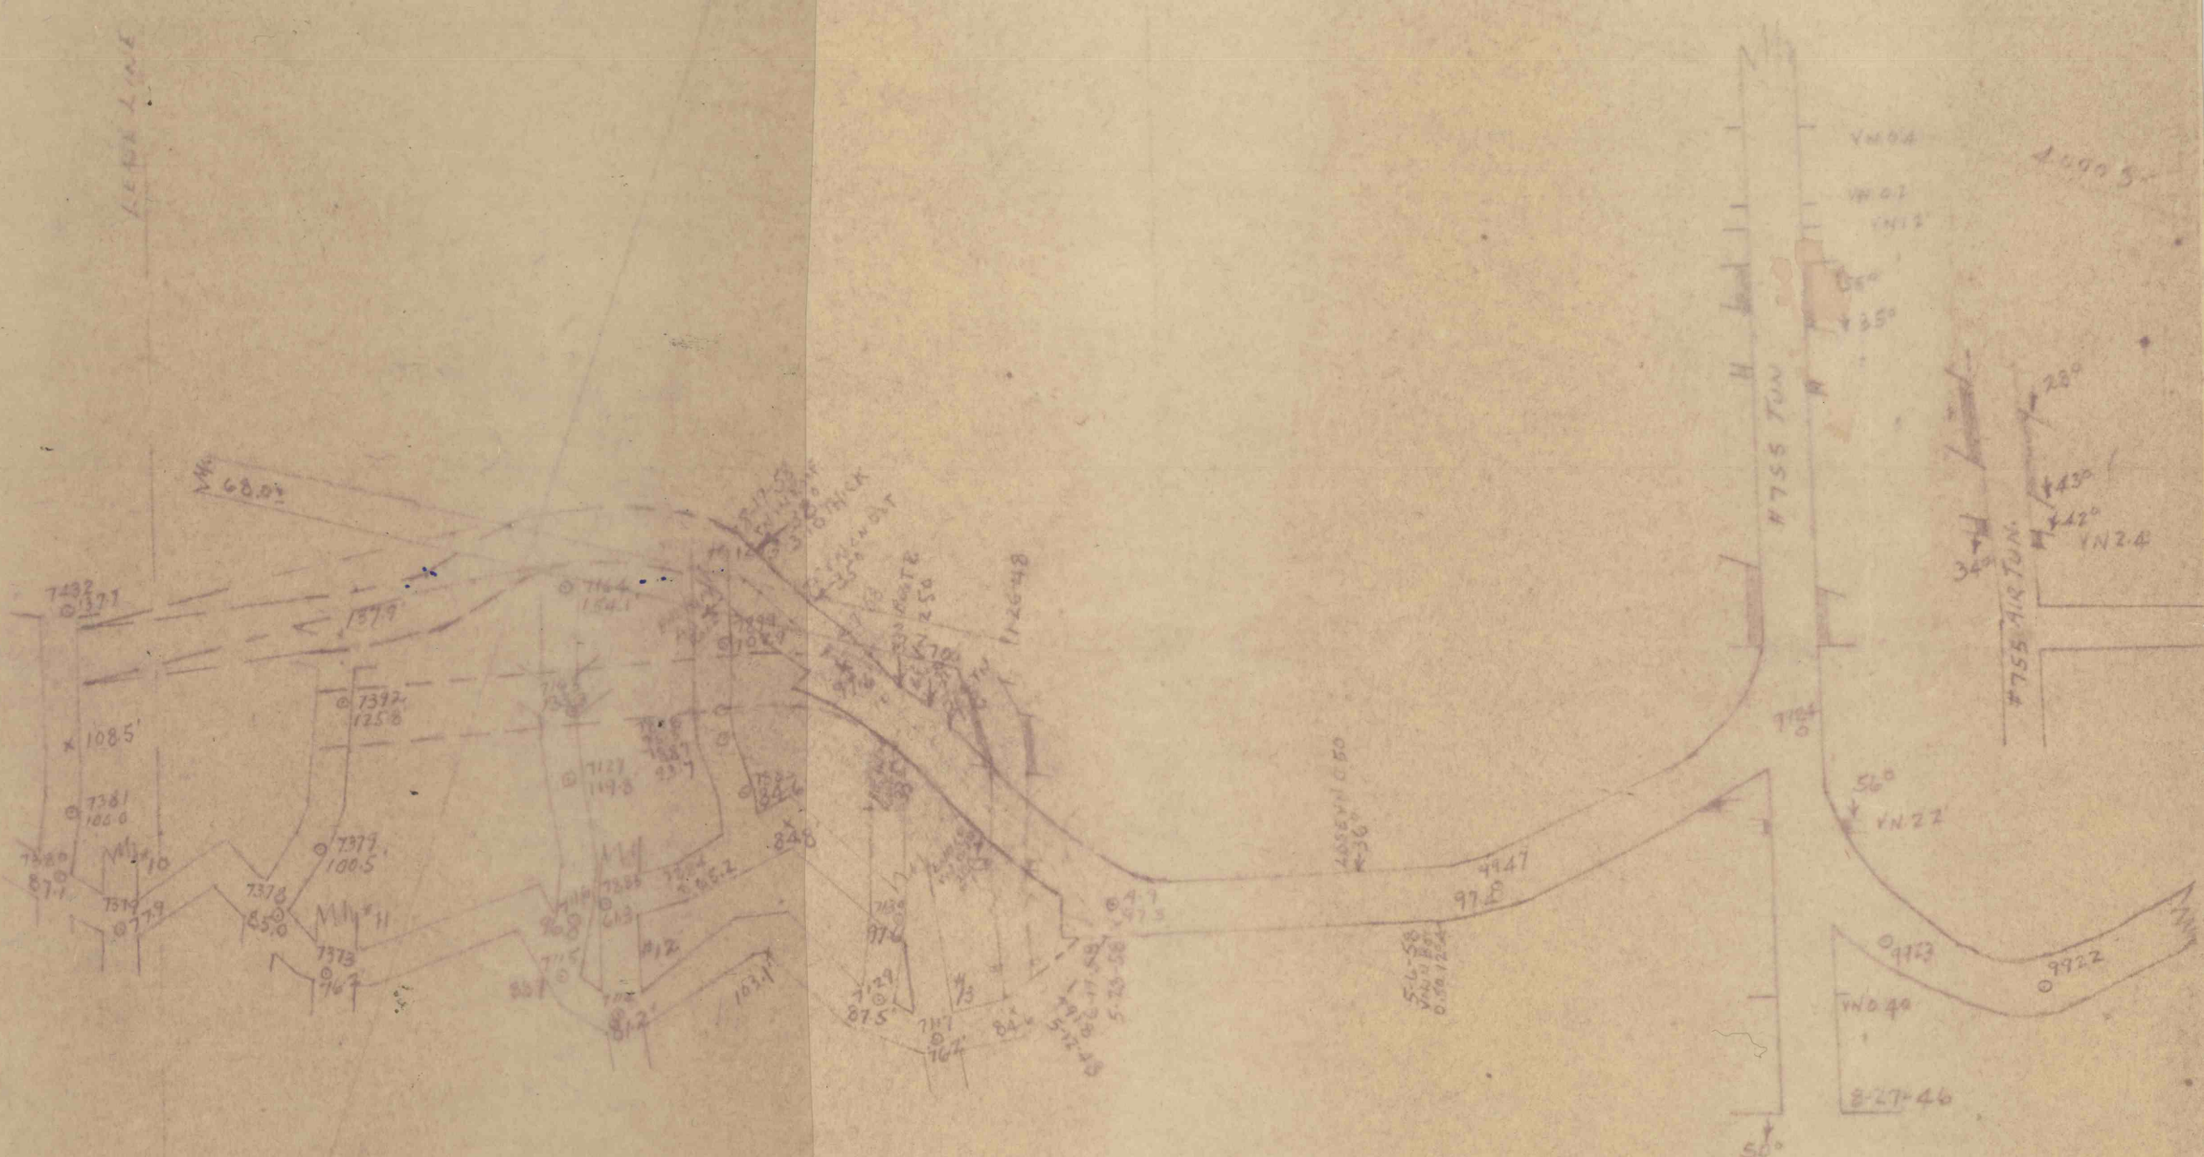

Southern Coal Field
Coal Dale Colly. Rahn Twp.
Schuylkill. Co, Pa.

PROPOSED-WEST-40 ROCK GWY-OFF #755-TUNNEL

SCALE: 1"=40' 7/16-1958.