

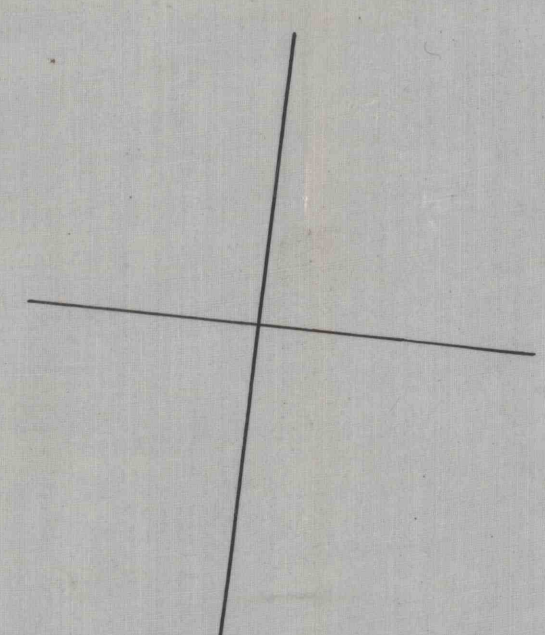
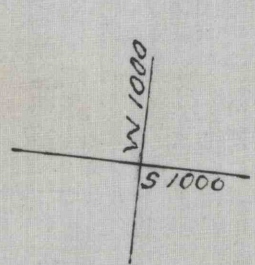
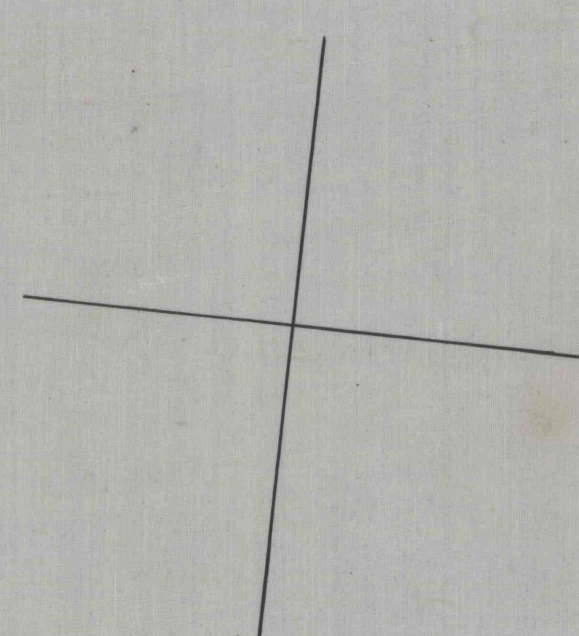
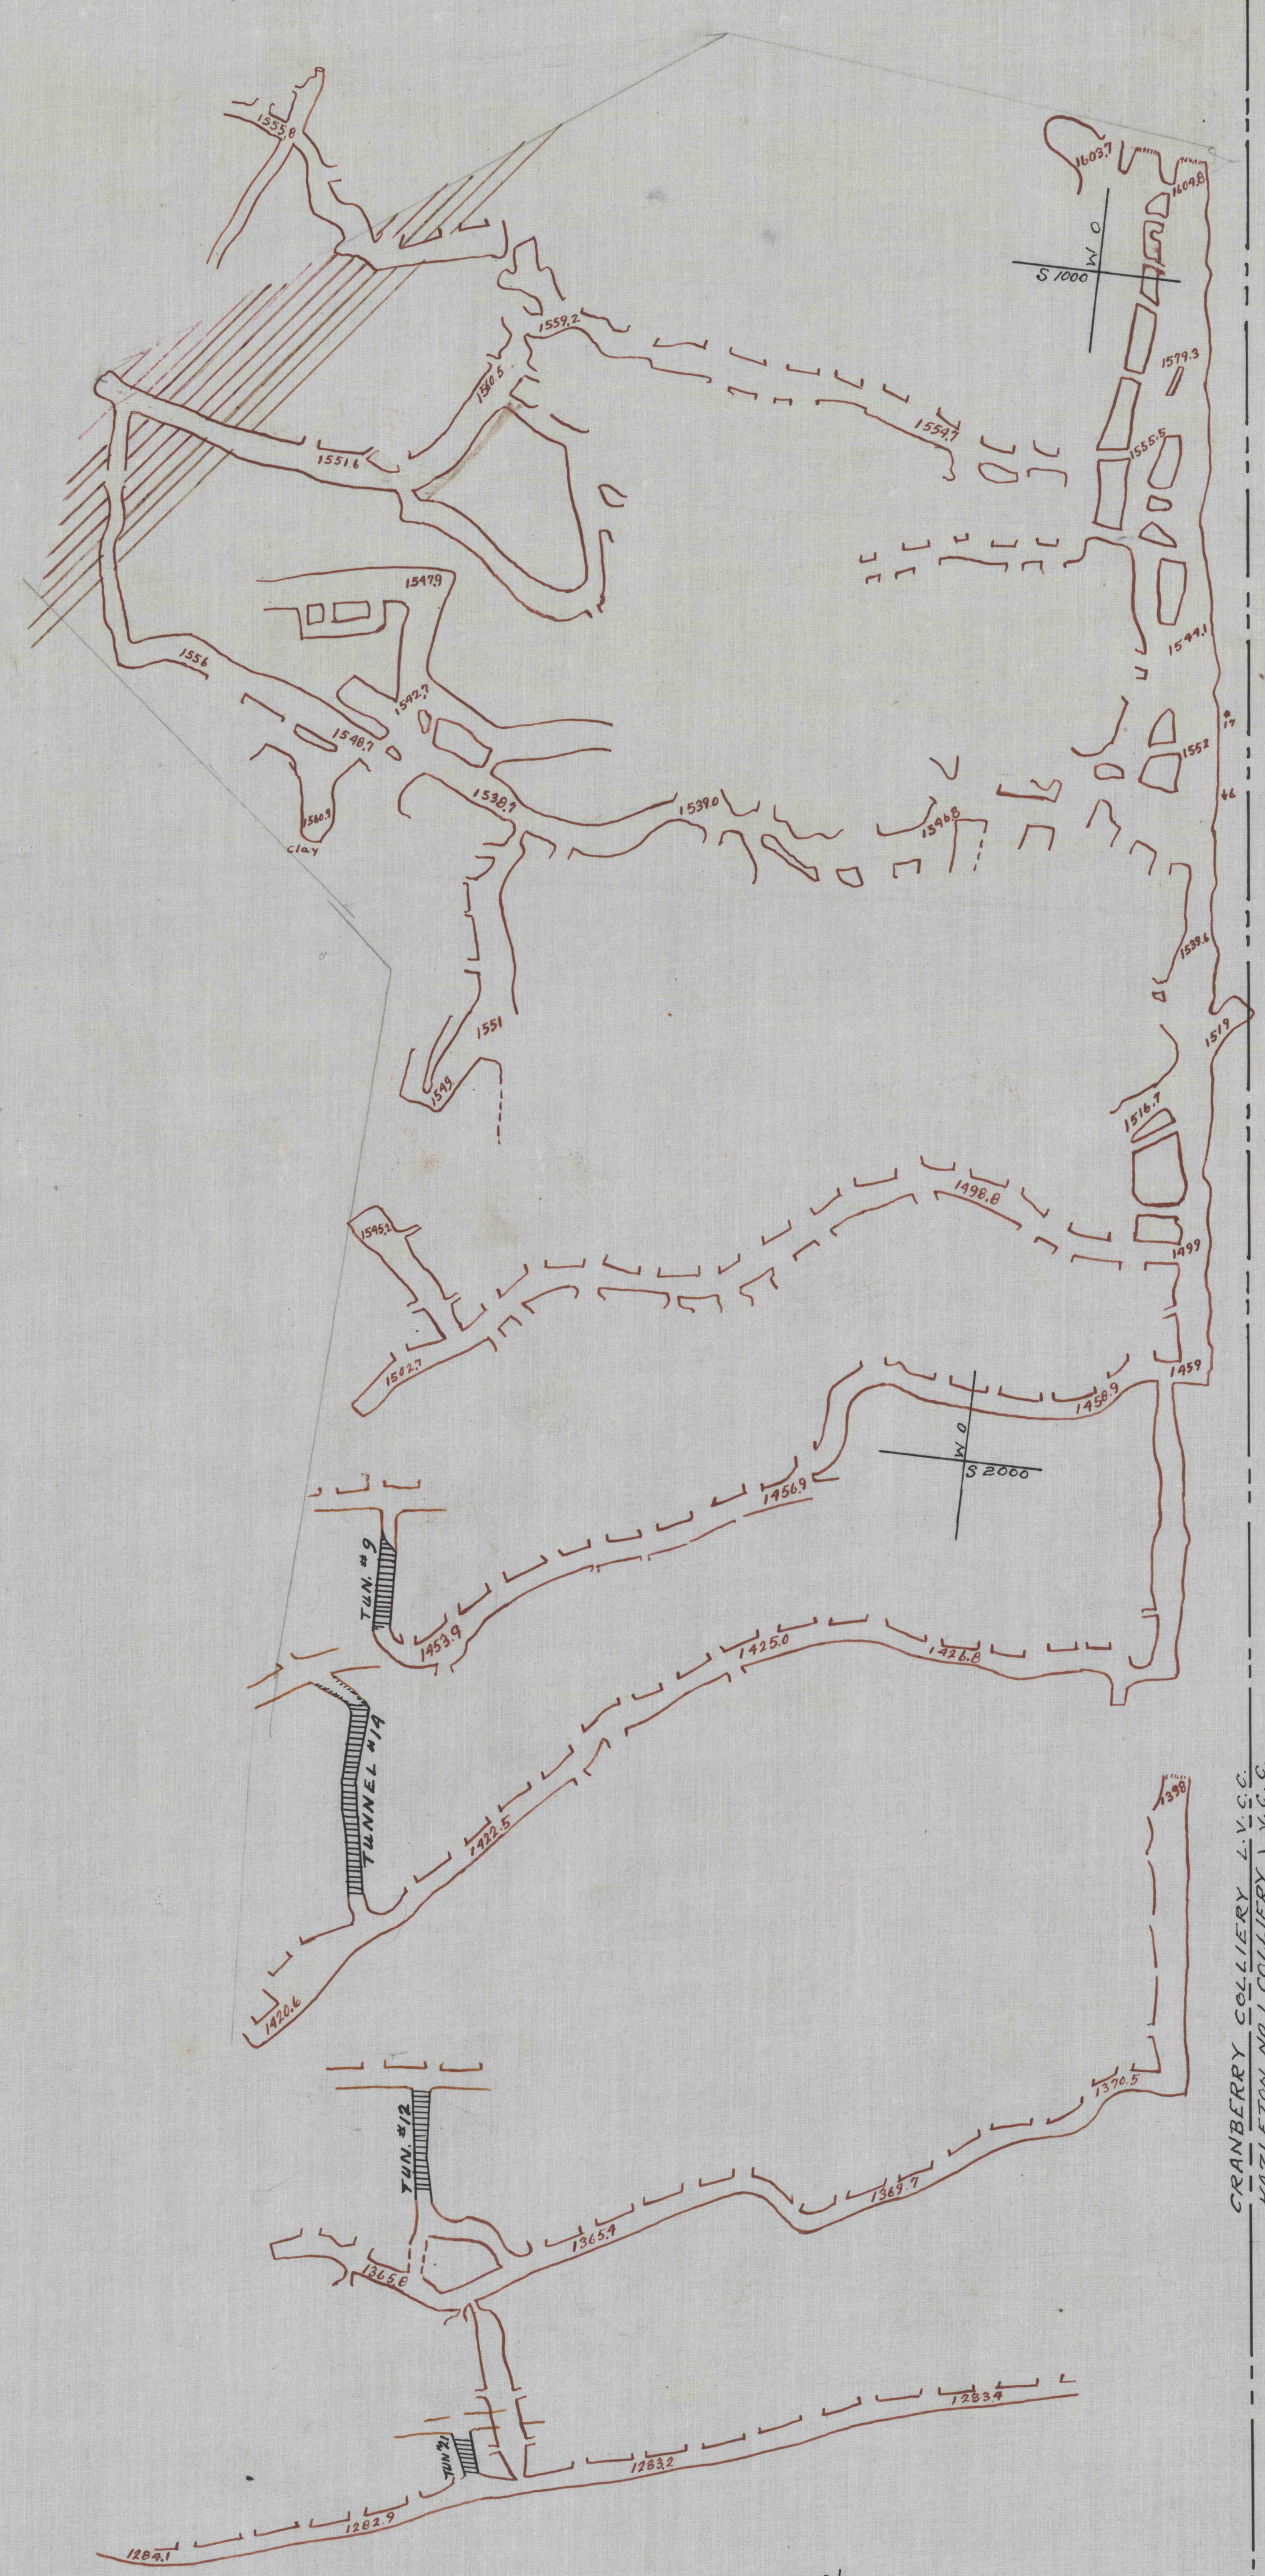
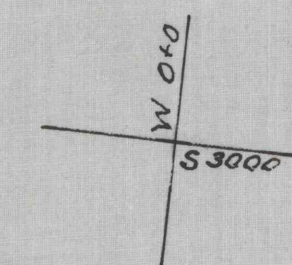


1 2 ROT 023221 3111
152 1009 RU07

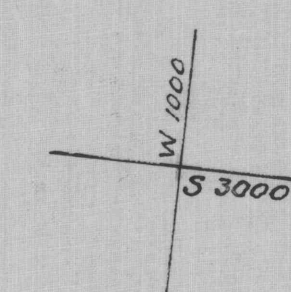

SLOPE #6

SLOPE #1

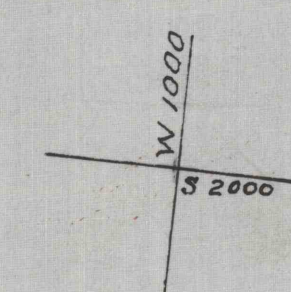

MINE INSPECTOR'S TRACING
.: EASTERN Middle Field .:
FOUR FOOT SPLIT VEIN
LUZERNE COUNTY, PA. HAZLETON DIST. #8
CRANBERRY PROPERTY
SCALE 1" = 100' COLLIERY FEBRUARY 1928

POSTING BY YEAR
C.S. Welliver 1928
W.H. WINTER'S 1937
NO CHANGE C.M.B. JUNE 1950

CRANBERRY COLLIERY L.V.C.C.
HAZLETON NO. 1 COLLIERY L.V.C.C.

1 2 ROT 023221 3111
152 1009 RU07