

ME
NOV 20 1974

NORTHERN FIELD..
EXETER TWP, LUZERNE COUNTY, W. PITTSTON BORO.
3. PITTSTON DISTRICT.

CLEAR Spring
Colliery

LOWER SPLIT
OF
PITTSTON VEIN.
SULLIVAN TRAIL COAL CO.
WEST PITTSTON, PA.
SCALE 1" = 100'.
INSPECTOR'S TRACING


DATUM -
500 FEET BELOW TIDE

Extended	July 20, 1936
"	Oct. 1, 1936
"	Jan. 15, 1937
"	Apr. 20, 1937
"	Oct. 20, 1937
"	Jan. 3, 1938
"	Apr. 7, 1938
"	July 19, 1938

CEMETERY

To the best of our knowledge and belief,
this is a true and correct tracing of surveys
made at Clear Spring Colliery to the time of
abandonment

Signed: *Hugh S. Wilson*
Title: MINING ENGINEER

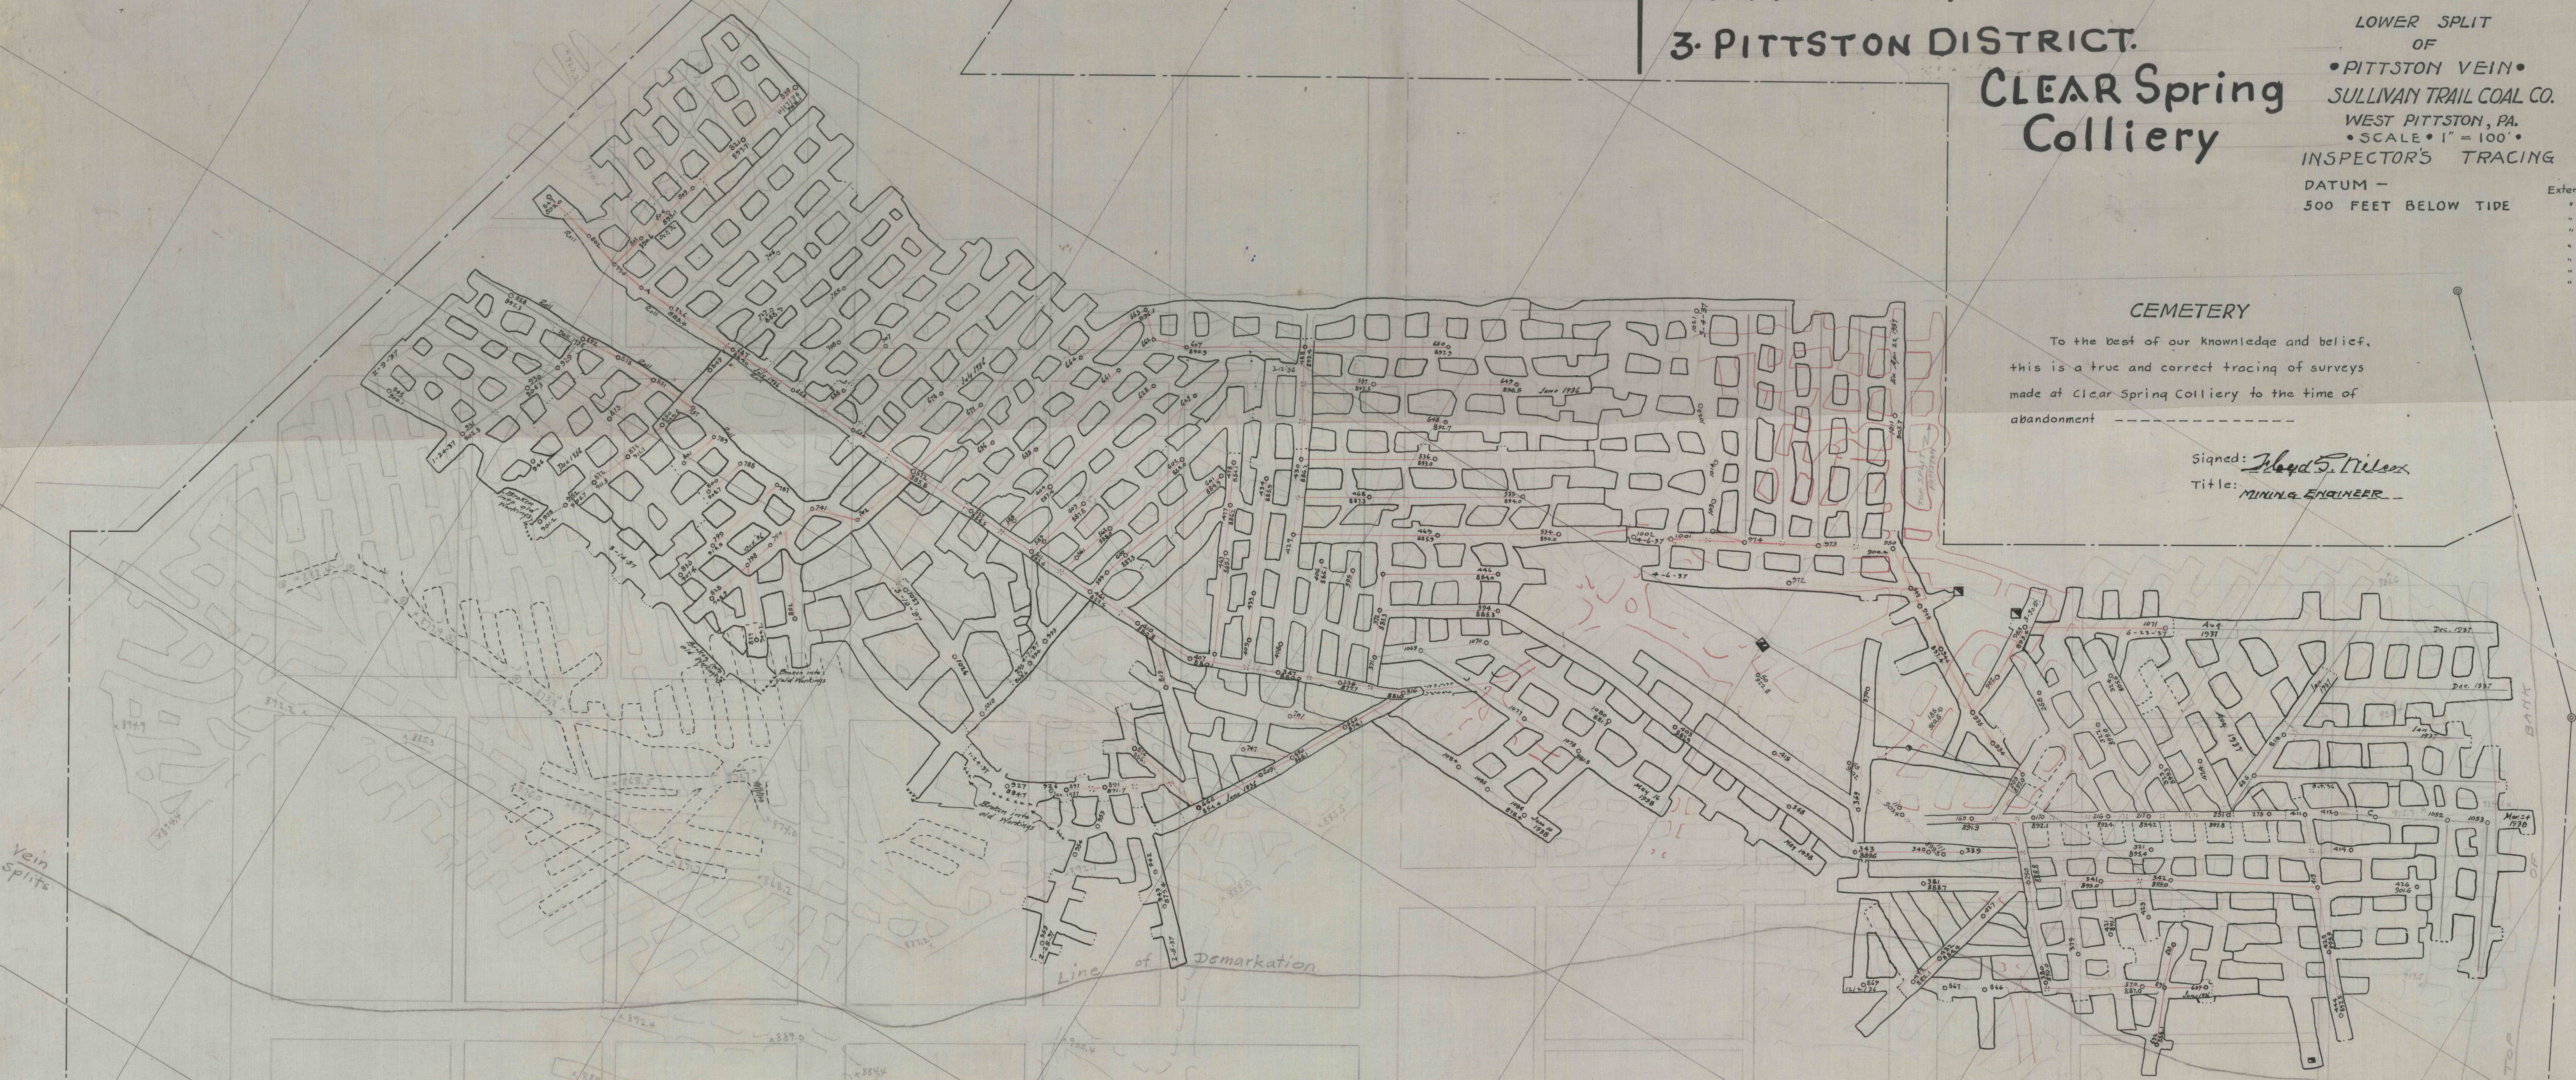

W. PITTSTON BORO, LUZERNE COUNTY, PA.
SULLIVAN TRAIL COAL CO. LOWER SPLIT, CLEAR SPRING COAL FIELD
NORTHERN FIELD