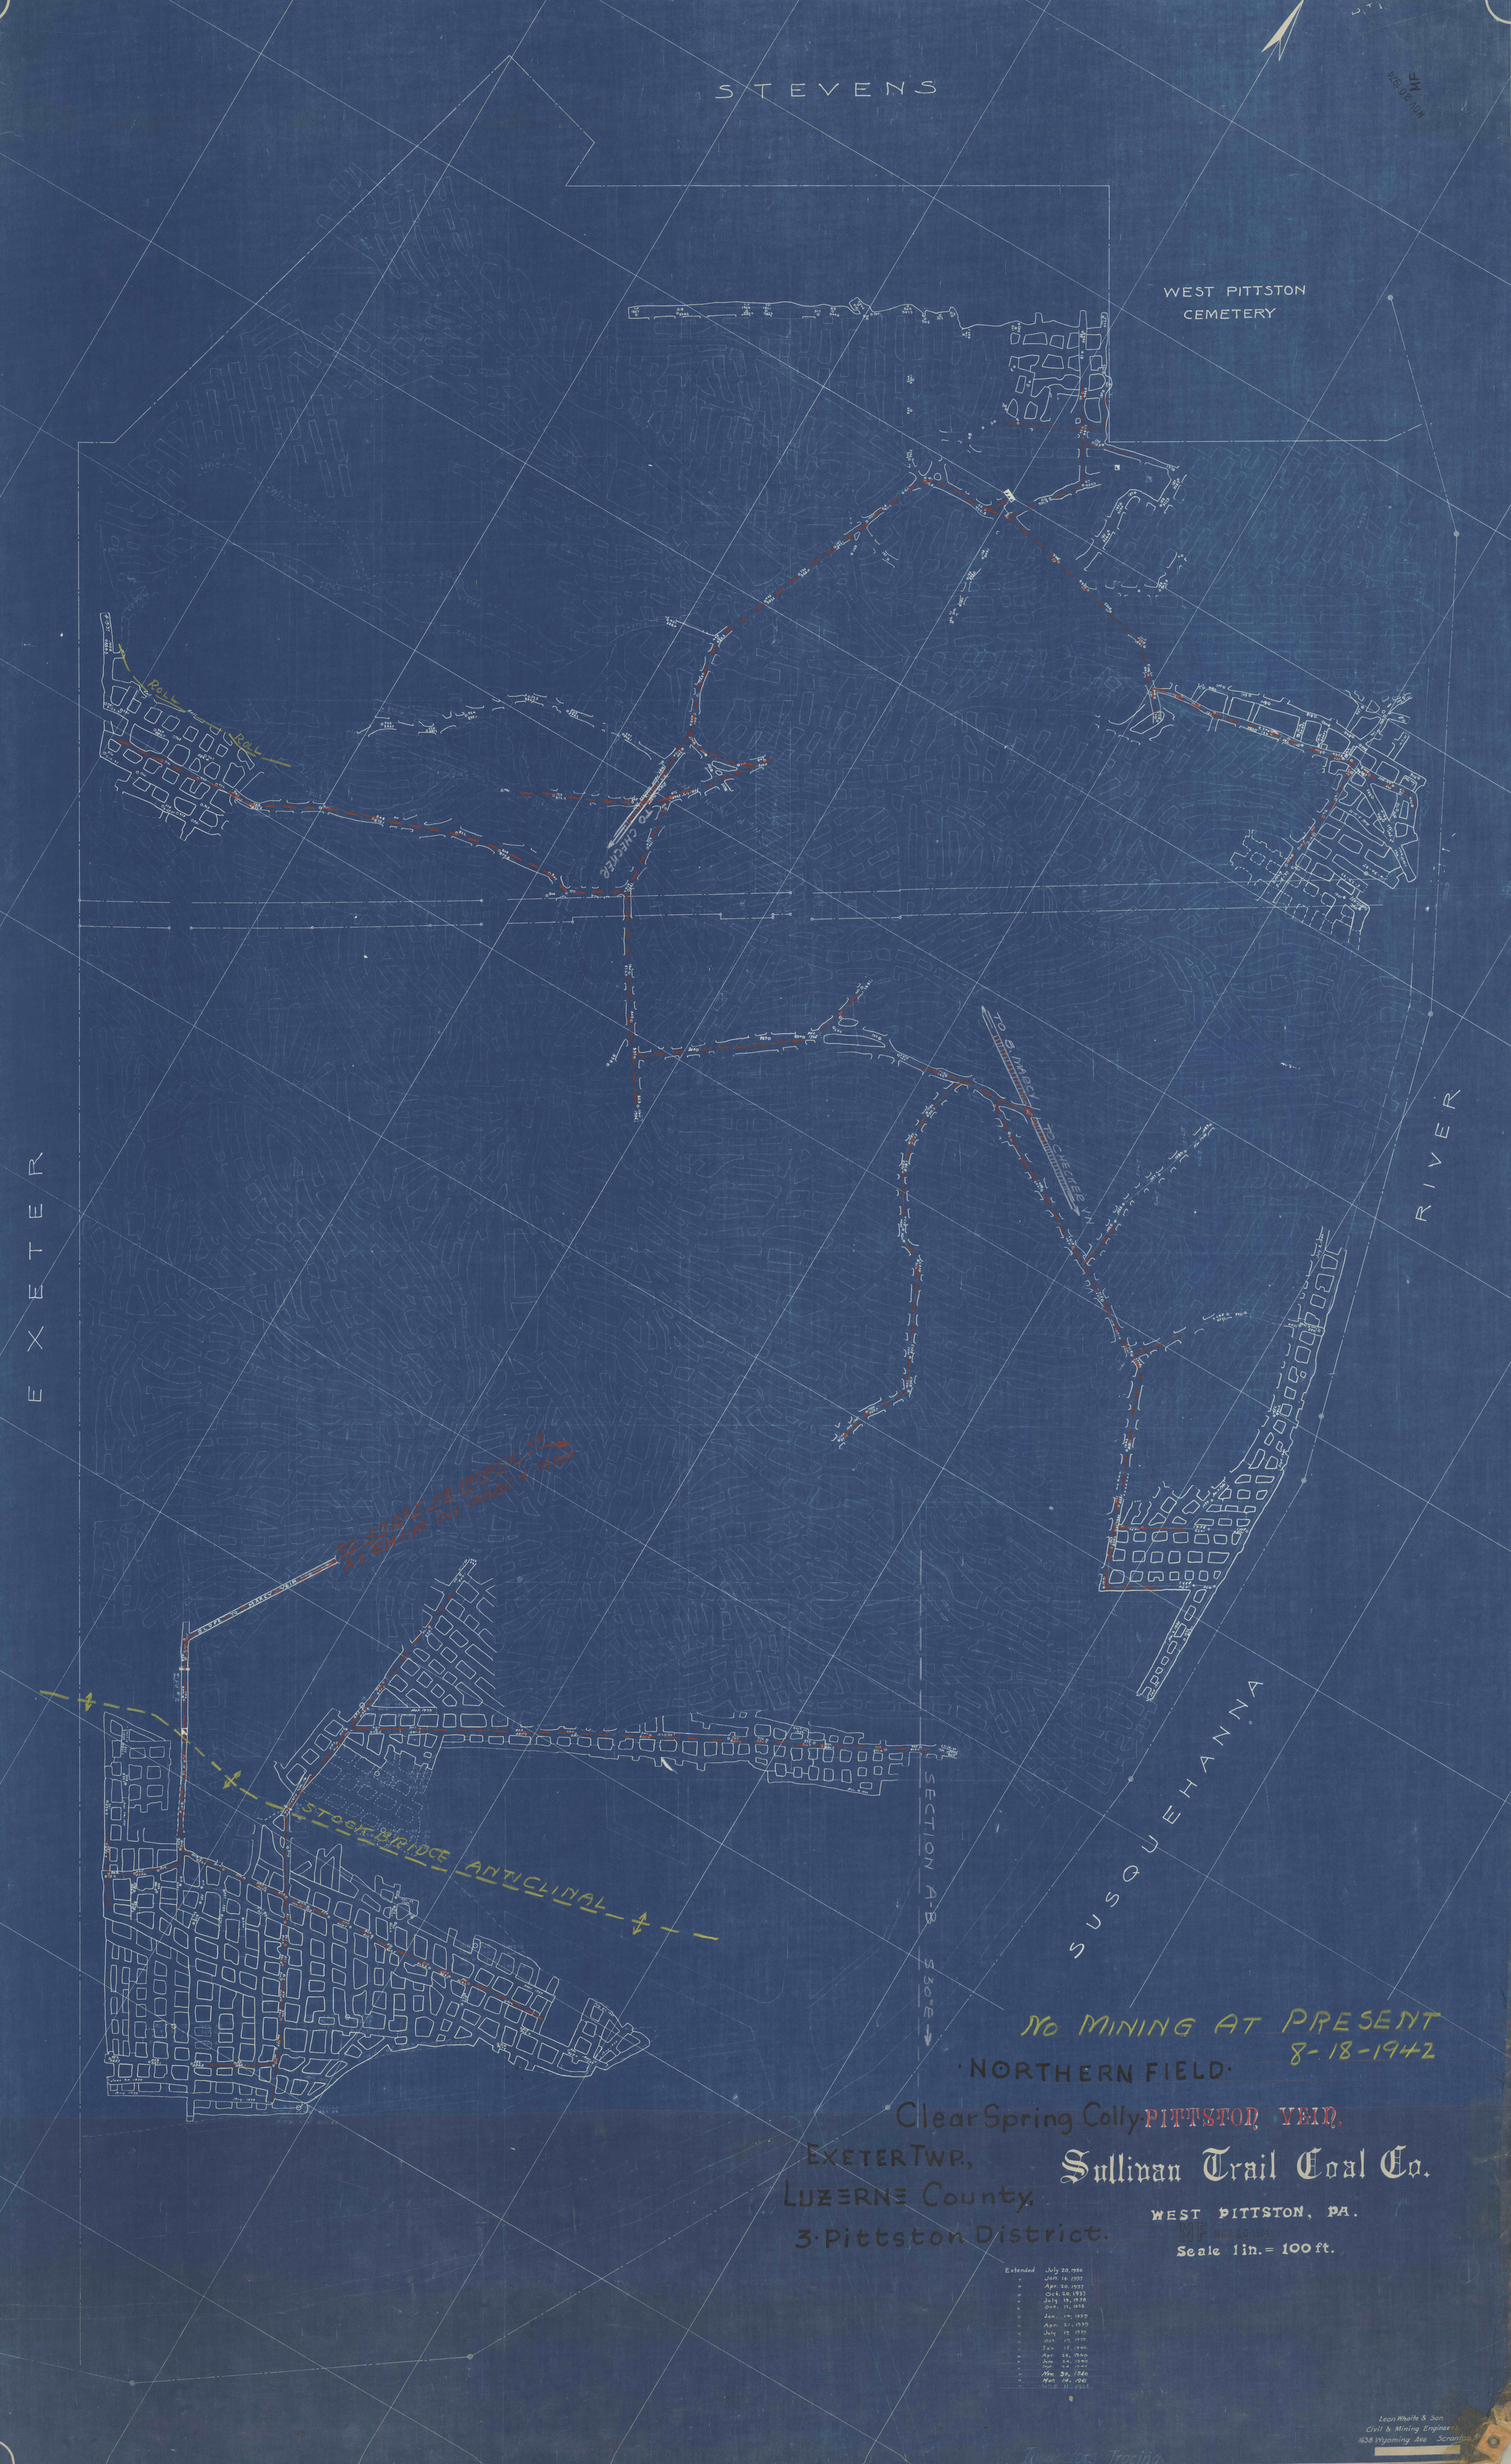
STEVENS
WEST PITTSTON CEMETERY
ROLL
ROLL
TO CHECKER
TO S. MABEY
TO CHECKER
TO SHEET VIA MABEY VIA AS SHOWN ON MABEY MAP
SLOPE TO MABEY VEIN
STOCKBRIDGE ANTICLINAL
SECTION A-B S 30° E
EXETER
SUSQUEHANNA
RIVER
No MINING AT PRESENT
8-18-1942
NORTHERN FIELD
Clear Spring Colly. PITTSTON VEIN.
EXETER TWP.,
LUZERNE County.
3. Pittston District.
Sullivan Trail Coal Co.
WEST PITTSTON, PA.
Scale 1 in. = 100 ft.
Extended July 20, 1936
" Jan. 14, 1937
" Apr. 20, 1937
" Oct. 20, 1937
" July 19, 1938
" Oct. 17, 1938
" Jan. 14, 1939
" Apr. 21, 1939
" July 19, 1939
" Oct. 19, 1939
" Jan. 15, 1940
" Apr. 26, 1940
" July 24, 1940
" Sept. 24, 1940
" Nov. 30, 1940
" Mar. 14, 1941
Leon Whaite & Son
Civil & Mining Engineers
1638 Wyoming Ave. Scranton