
 


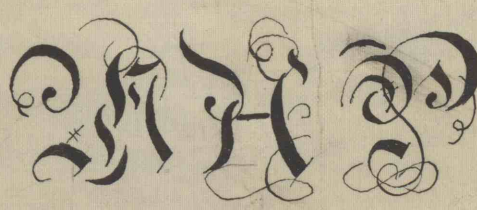

NORTHERN FIELD. 
WEST PITSTON Boro, OF W. PITSTON, Pa.
CLEAR SPRING COLLY
MARCH 1908 VEIN
SCALE 100 FT = 1 INCH
LUZERNE COUNTY, Sullivan TRAIL COAL CO.,

POSTED TO	DATE	BY	NAME
"	JAN 99	"	"
"	FEB 1900	"	"
"	JAN 1901	"	"
"	JAN 1902	"	"
"	JUNE 1902	"	"
"	JULY 1903	"	"
"	JULY 1904	"	"
"	JAN 1905	"	"
"	JULY 1905	"	"
"	JAN 1906	"	"
"	JULY 1906	"	"
"	JAN 1907	"	"
"	JUNE 1907	"	"
"	JAN 1908	"	"
"	JAN 1910	"	"
"	JULY 1910	"	"
"	JAN 1911	"	"
"	MAY 1911	"	"

ME 50 804
50 804