


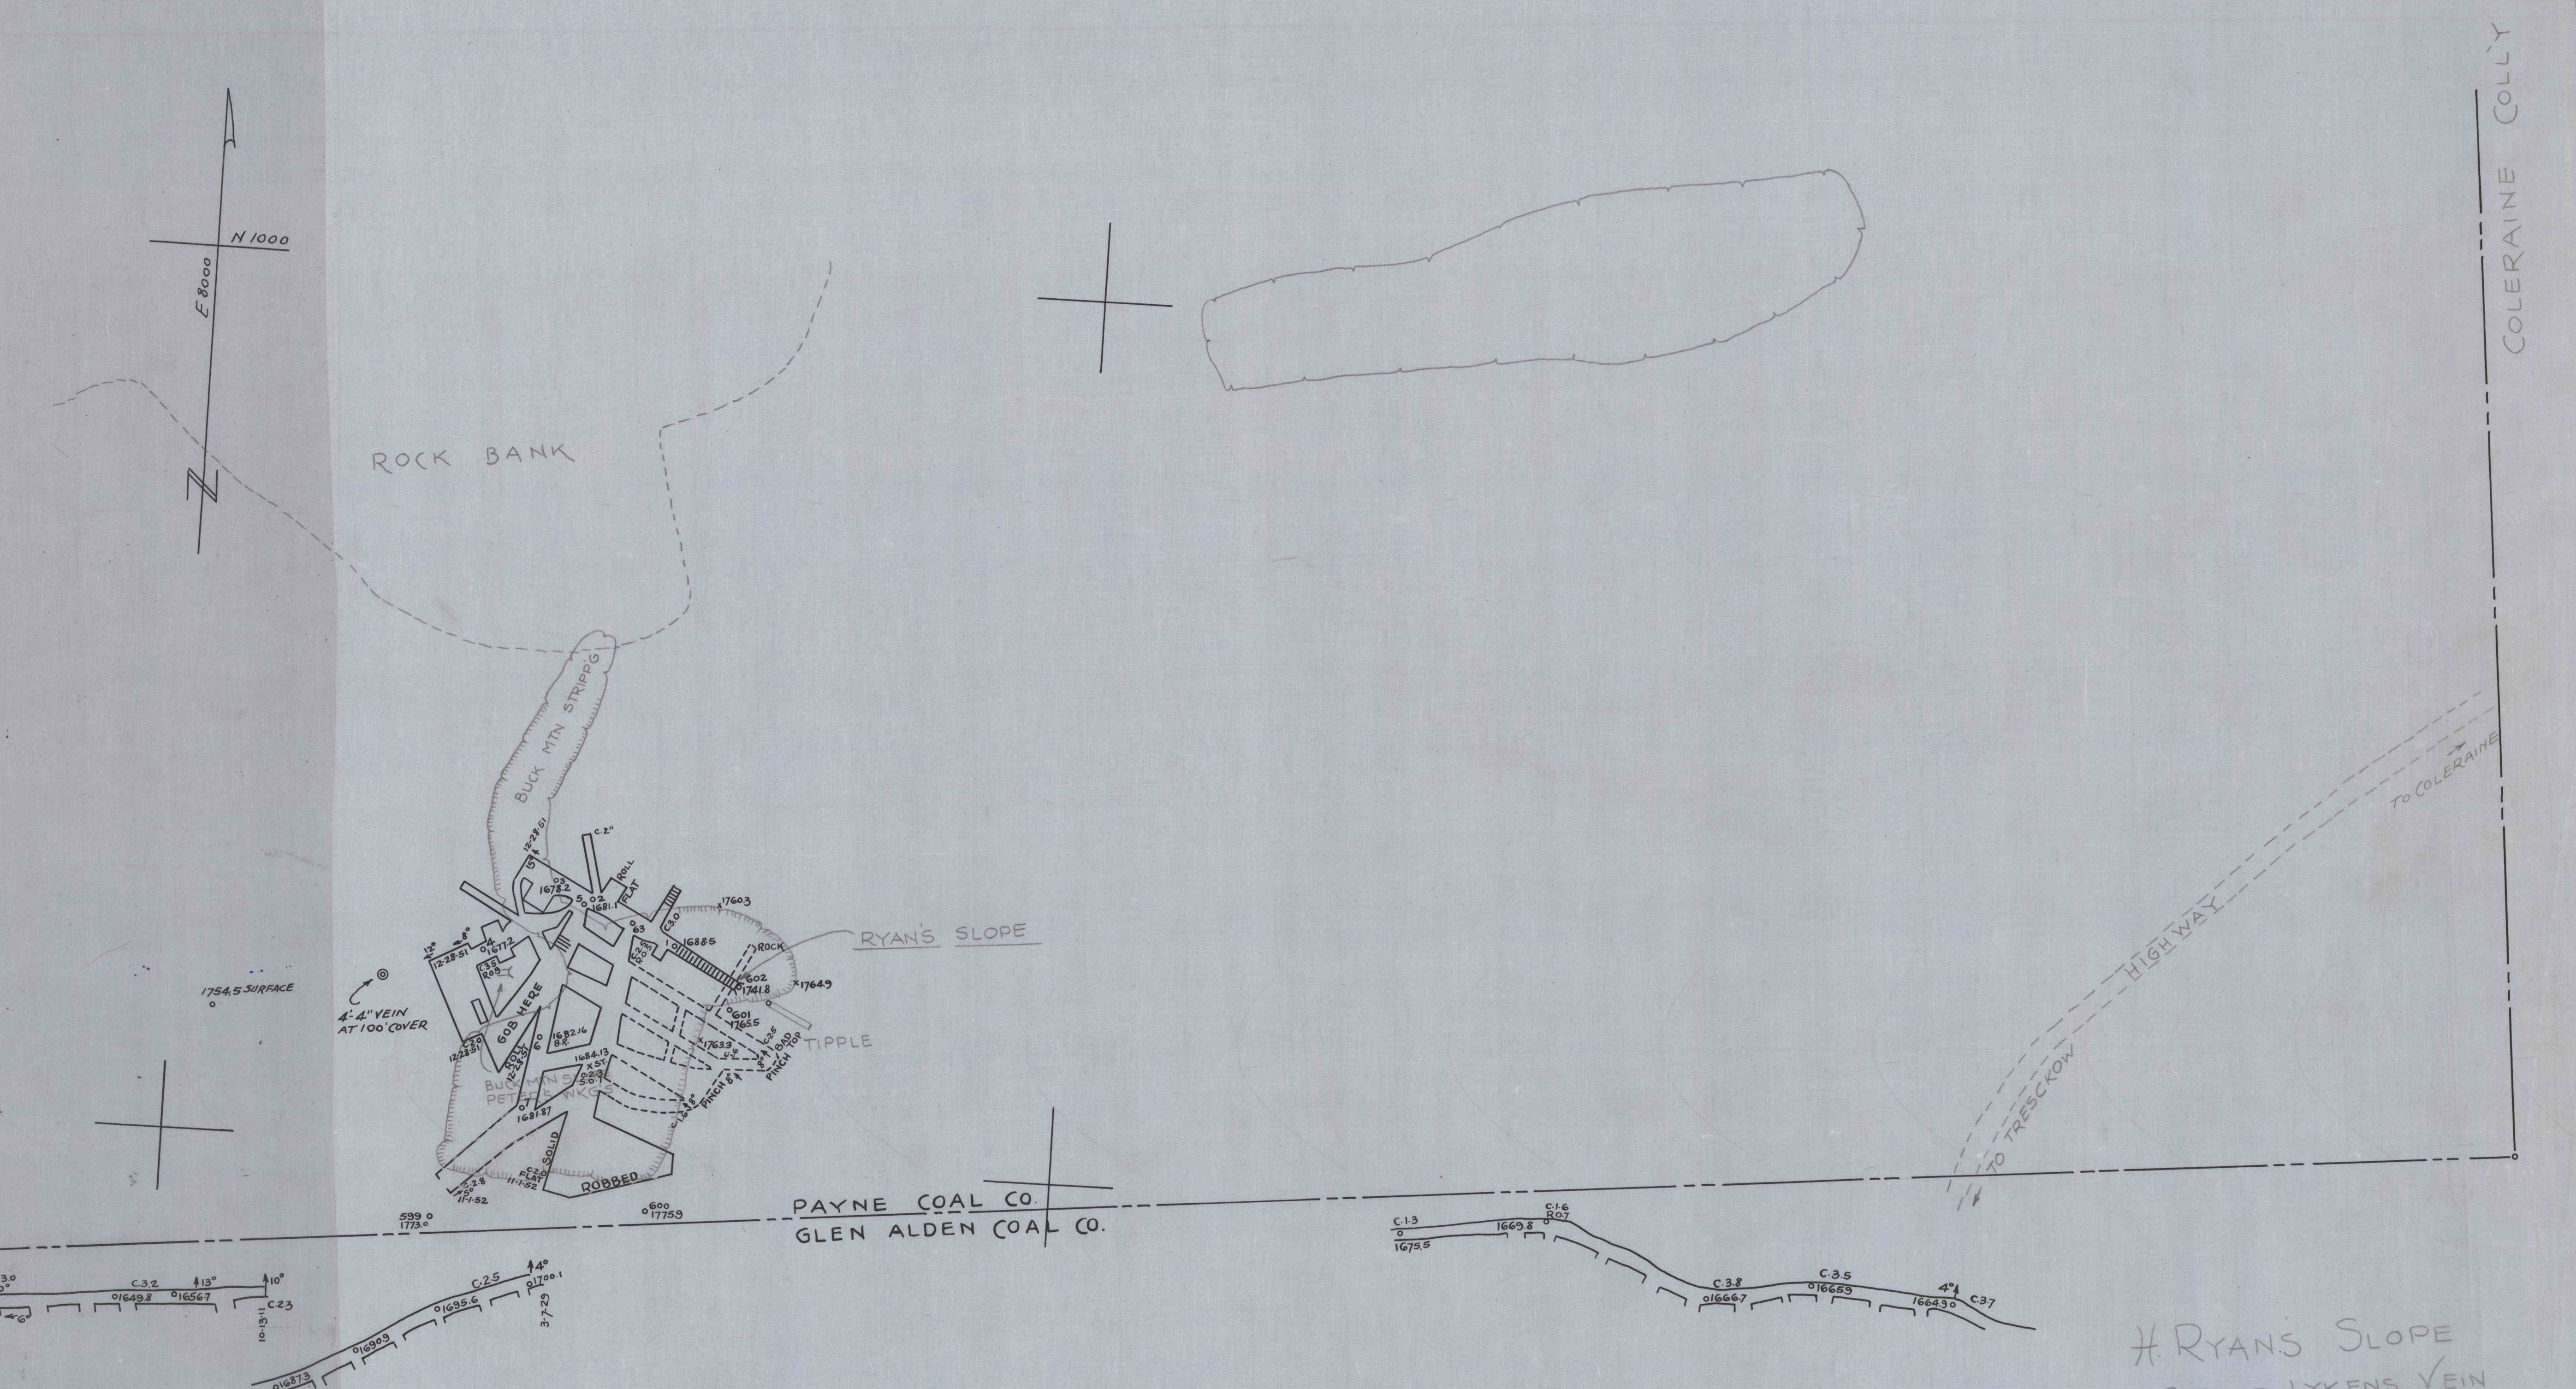

Eastern Middle Field. Coleraine Colliery..
 "OVERLAP LYKENS Vein." RYAN'S Slope.. 1"=100'..
 BANK Twp., Schuylkill-CARBON Counties..
 BEAVER DISTRICT. 9. Haddock MINING Co.,
 MEADOW .. # 212. ON MAP. .. 2-OF-2..