MAP
OF
EASTERN MIDDLE COAL FIELD.

COLERAINE COAL'Y PROPERTY
BANK TWP., SCHUYLKILL County Pa. CARBON COUNTY.
CHECKER VEIN. BEAVER MEADOW DISTRICT 9.
Haddock MINING Co.,
SCALE 1 INCH = 100 FEET

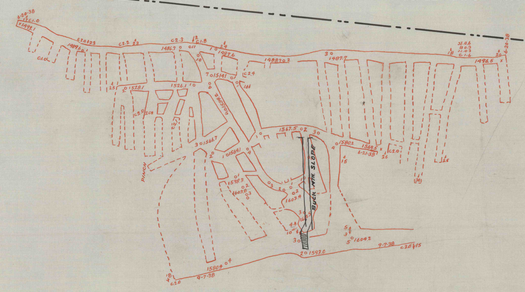

OCTOBER 27, 1938 P.H. VANNAUCKER

MF
OCT 1 01972

MF
OCT 1 01972

1 OF 2.