




PLAN
LOOKING EAST OR WEST
ALONG STRIKE OF VEIN

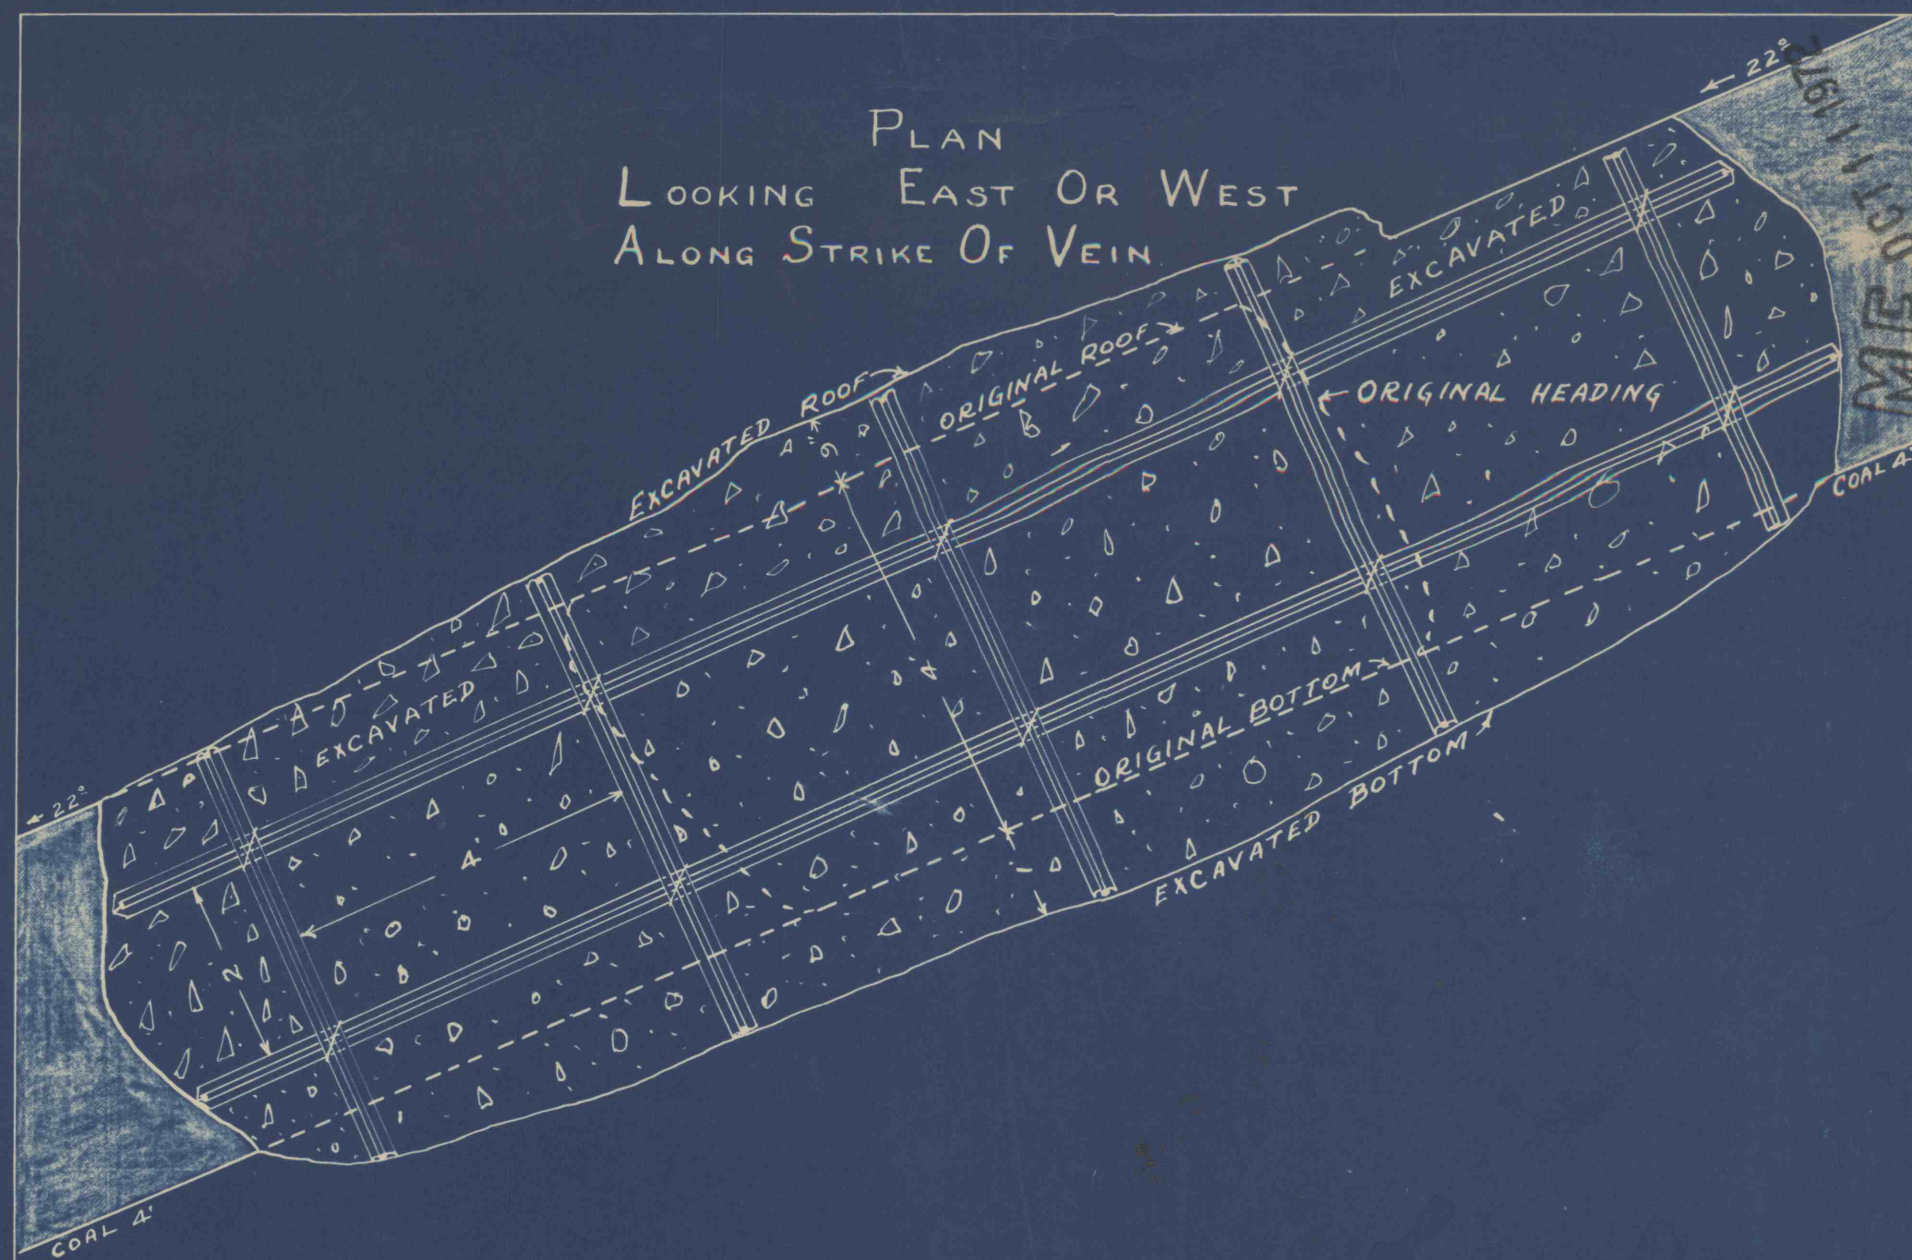


HORIZONTAL VIEW

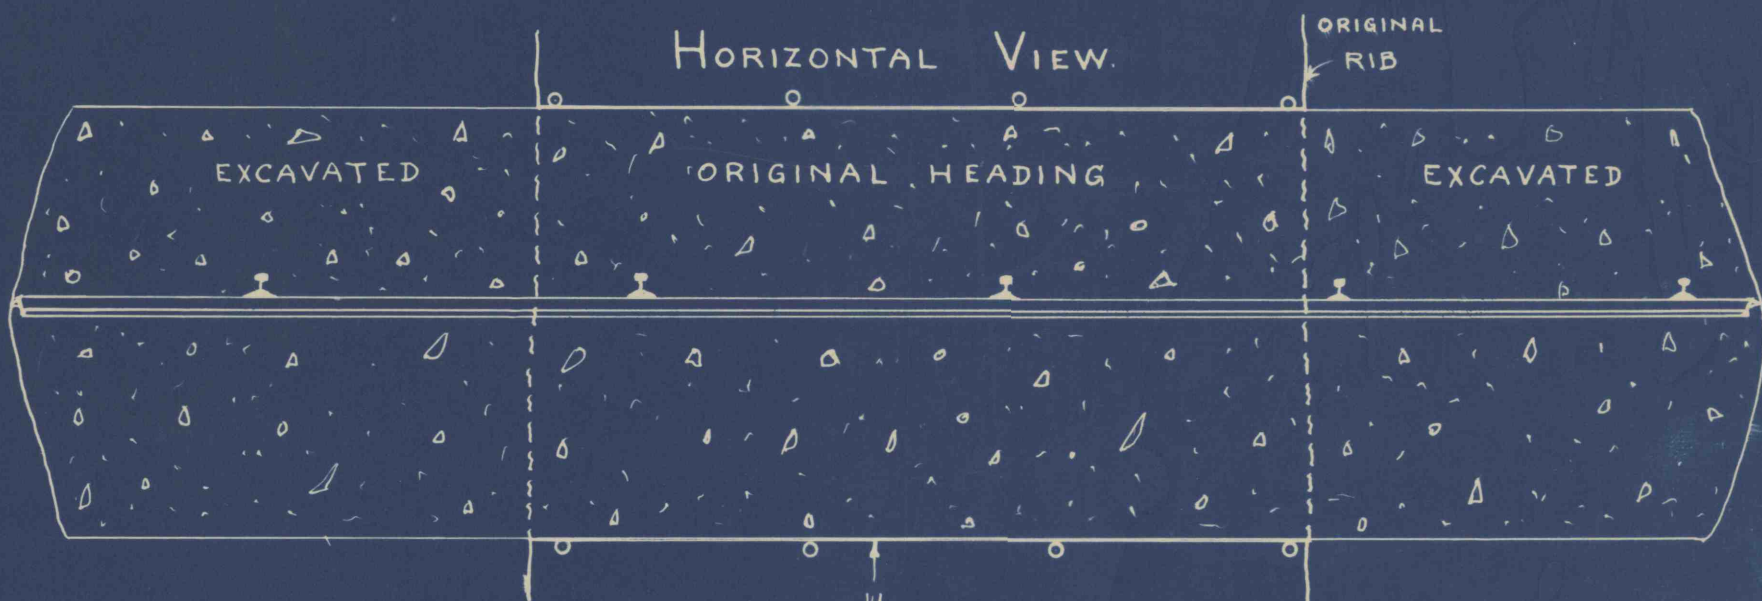

VERTICAL VIEW

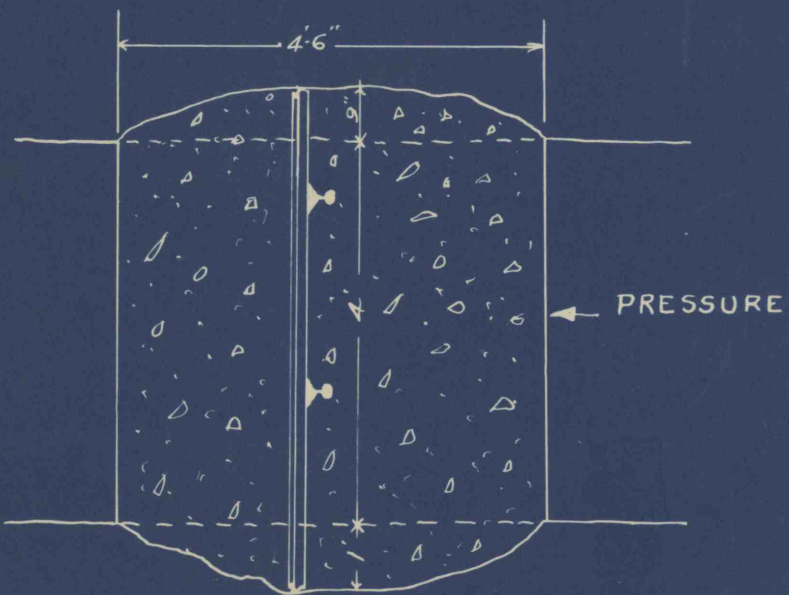

PLAN AND CROSS SECTION
OF REINFORCED HEADING IN THE GORDON SLOPE
OF THE, HADDOCK MINING CO. CANDLEMAS COLL'Y.
M'ADOO, SCH. CO. PA. - LOCATED 134 FT. ABOVE
BAY IN ROAD 5, BUCK MOUNTAIN VEIN
SCALE 1"=2' 4-17-36
CONCRETE MIXTURE 1-2-3. 1,170# RAILS.

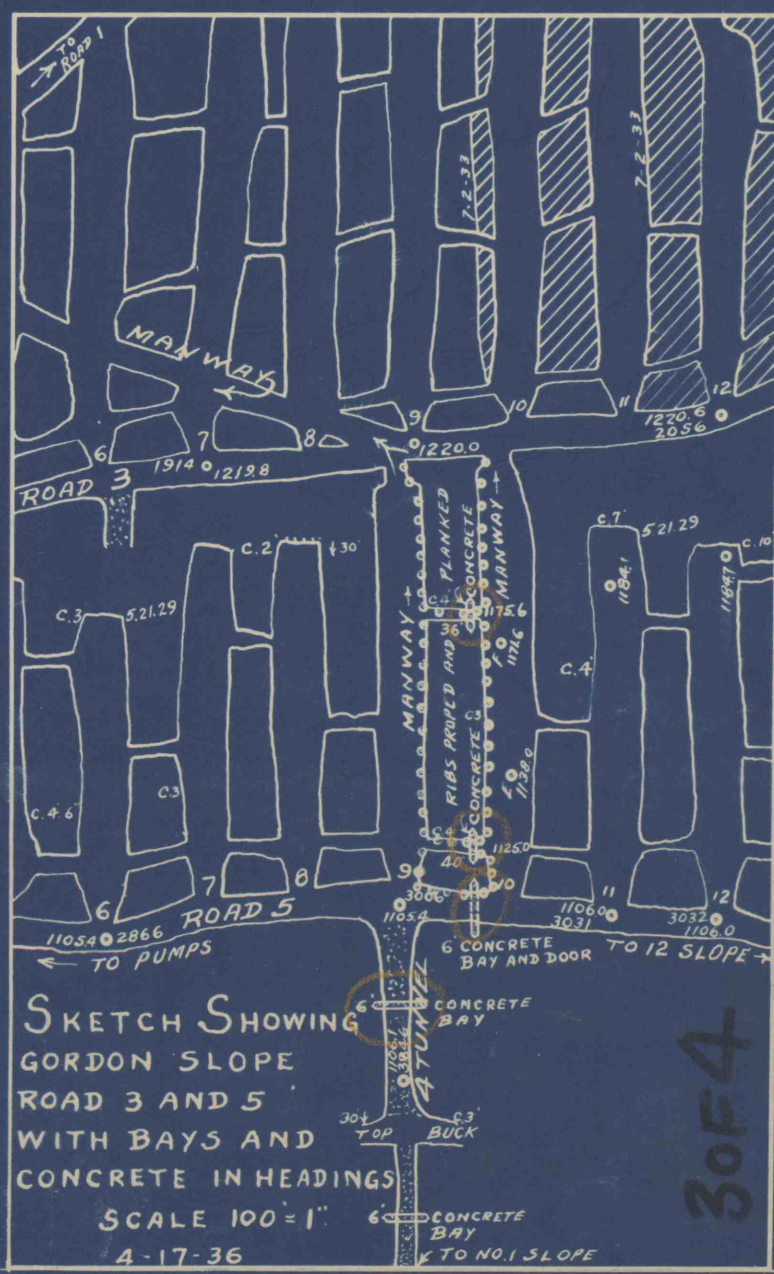

SKETCH SHOWING
GORDON SLOPE
ROAD 3 AND 5
WITH BAYS AND
CONCRETE IN HEADINGS

SCALE 100=1"
4-17-36

30F4