COLERAINE MINE WORKINGS
ADJOINING PROPERTY LINE — PER AGREEMENT OF ENGINEERS AND MINE INSPECTOR

FEB. 20th, 1899.

JUNE 1899.

SCALE 100 FEET = 1 INCH

W. L. CHAMBERLIN
ENGINEER

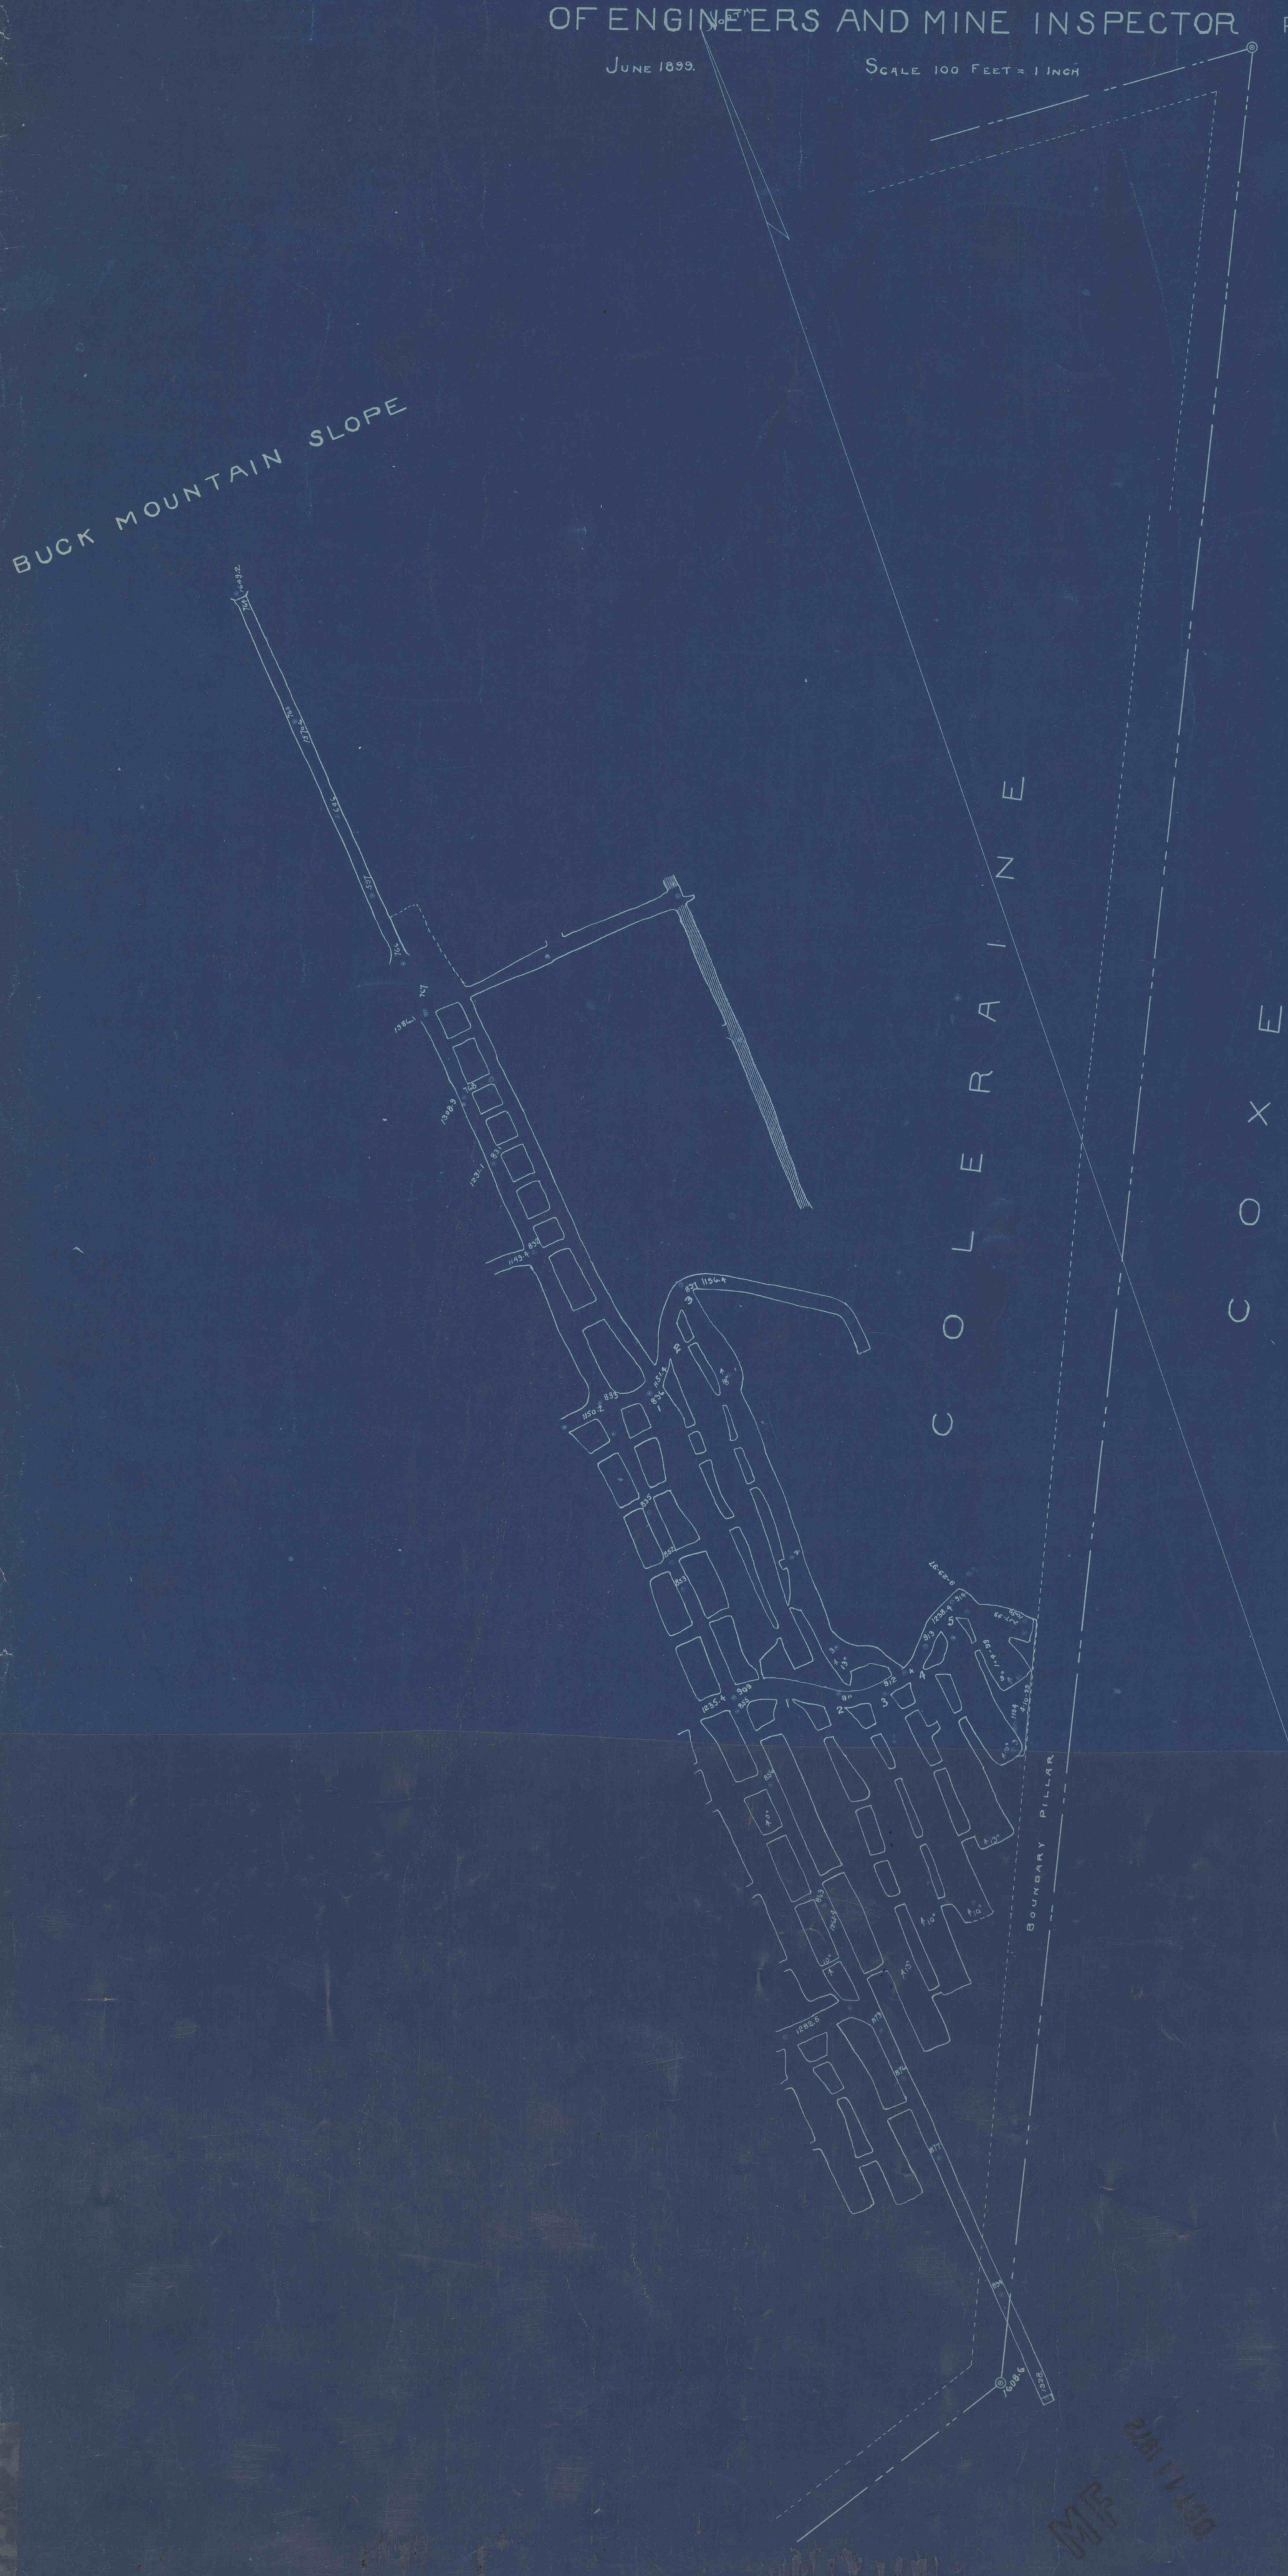

OCT 11 1972
MF