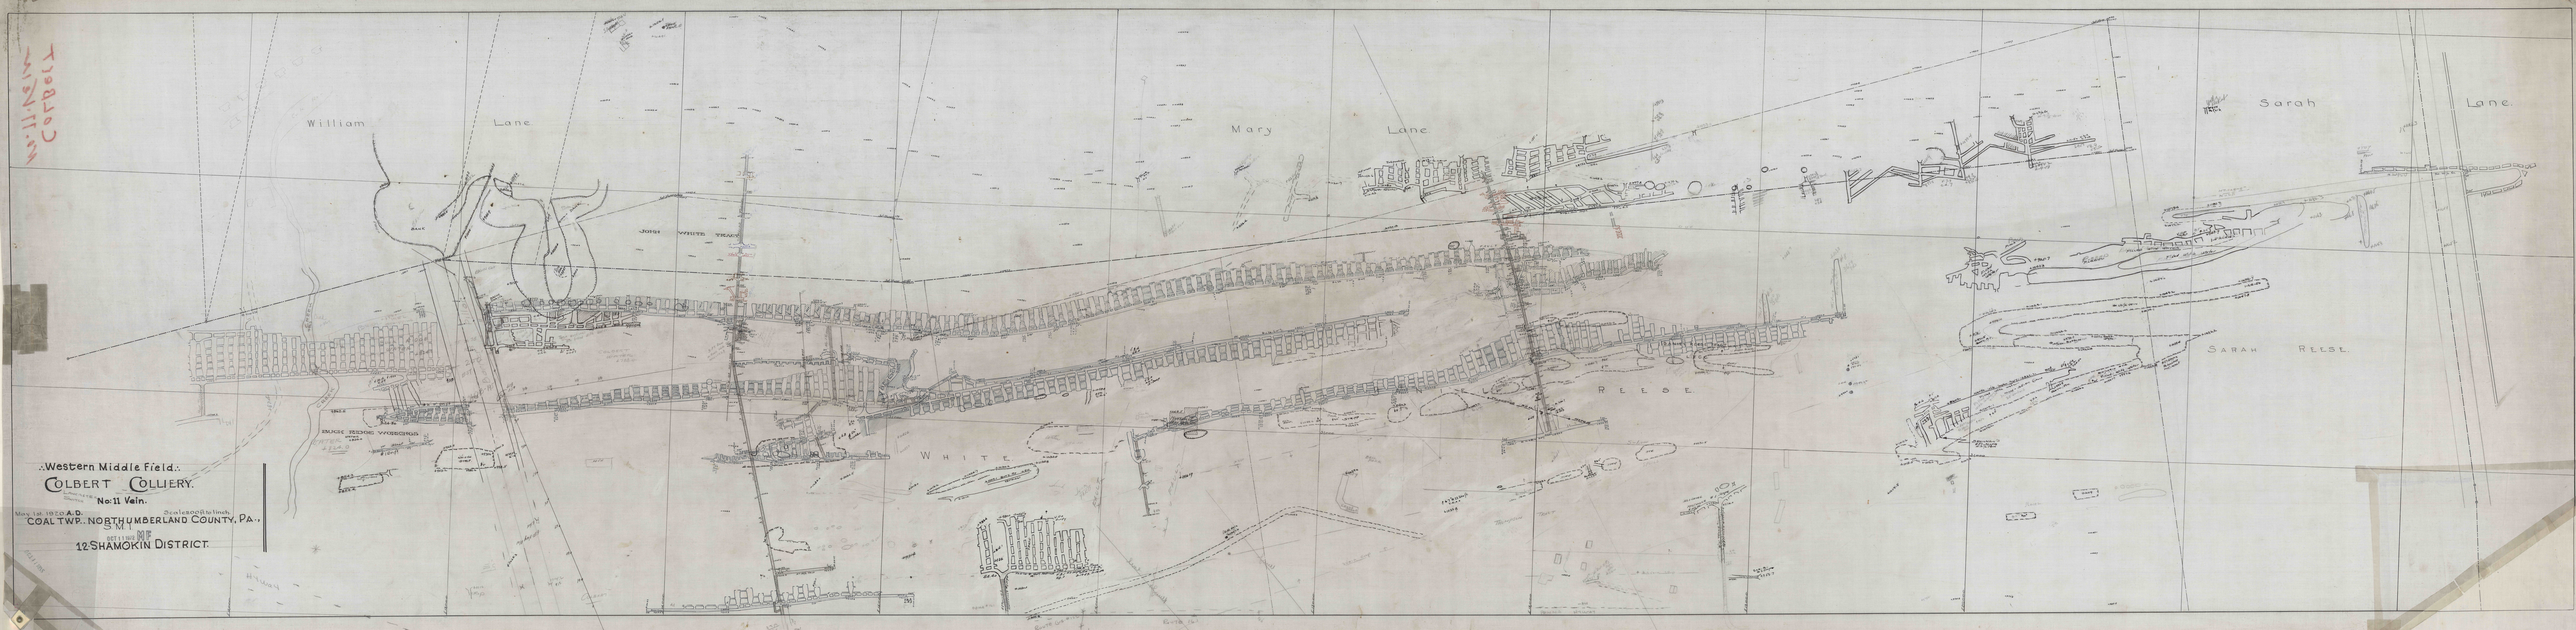
William Lane
Mary Lane
Sarah Lane
JOHN WHITE HEIRS
WHITE
REESE
SARAH REESE
Western Middle Field.
COLBERT COLLIERY.
No: 11 Vein.
May 1st 1920 A.D.
COAL TWP. NORTHUMBERLAND COUNTY, PA.,
12 SHAMOKIN DISTRICT.