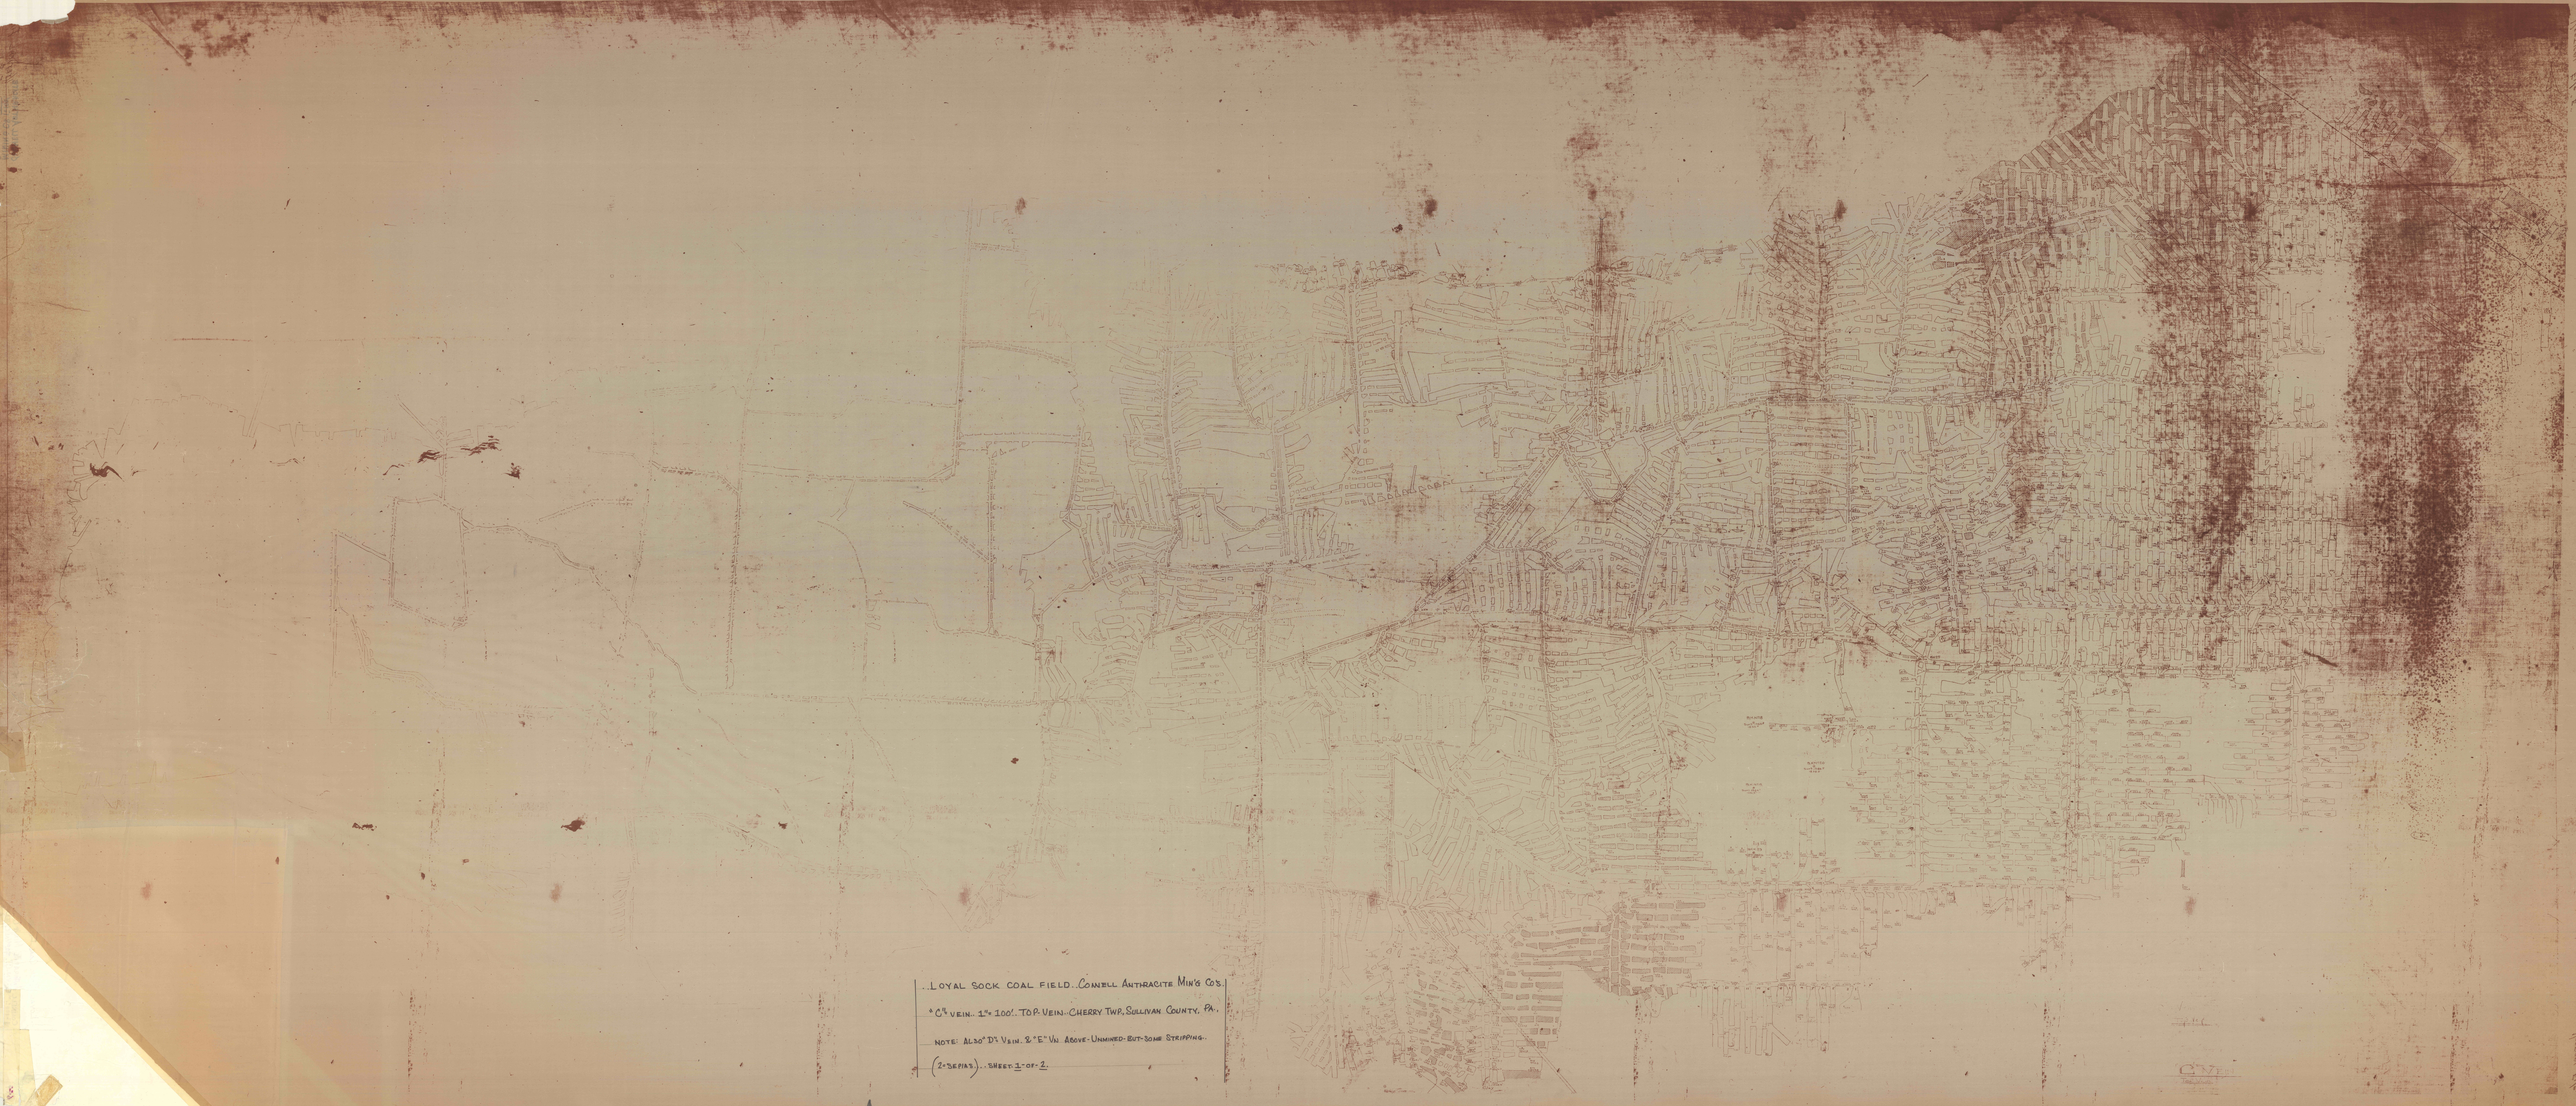
LOYAL SOCK COAL FIELD. CONELL ANTHRACITE MIN'G CO'S.
"C" VEIN. 1"= 100'. TOP VEIN. CHERRY TWP, SULLIVAN COUNTY, PA.
NOTE: ALSO "D" VEIN & "E" VN ABOVE. UNMINED. BUT SOME STRIPPING.
(2 SEPIAS). SHEET 1 OF 2.