


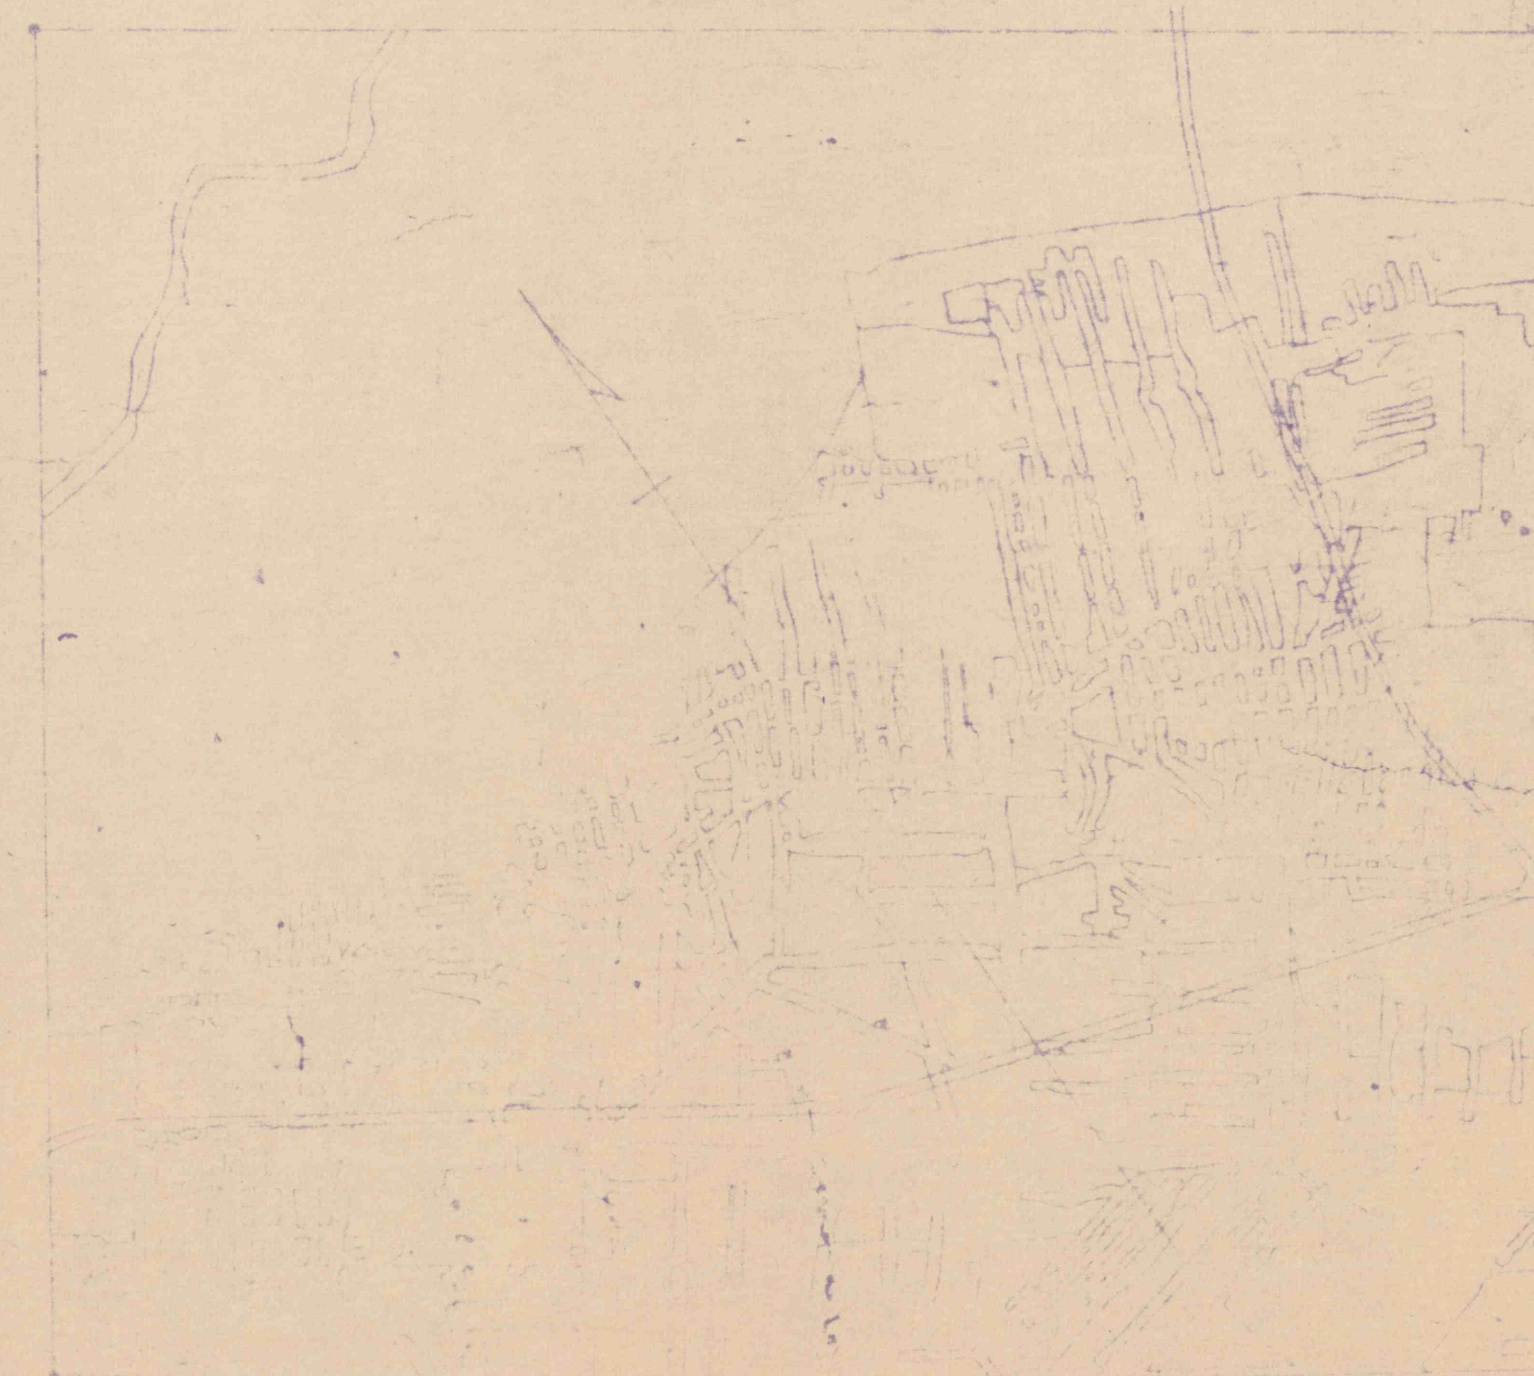

Connell Anthracite Mining Co's  
C vein workings  
at  
Bernice, Sull. Co. Pa.  
Scale 1" = 400 Ft.



C-1111

C-1111