


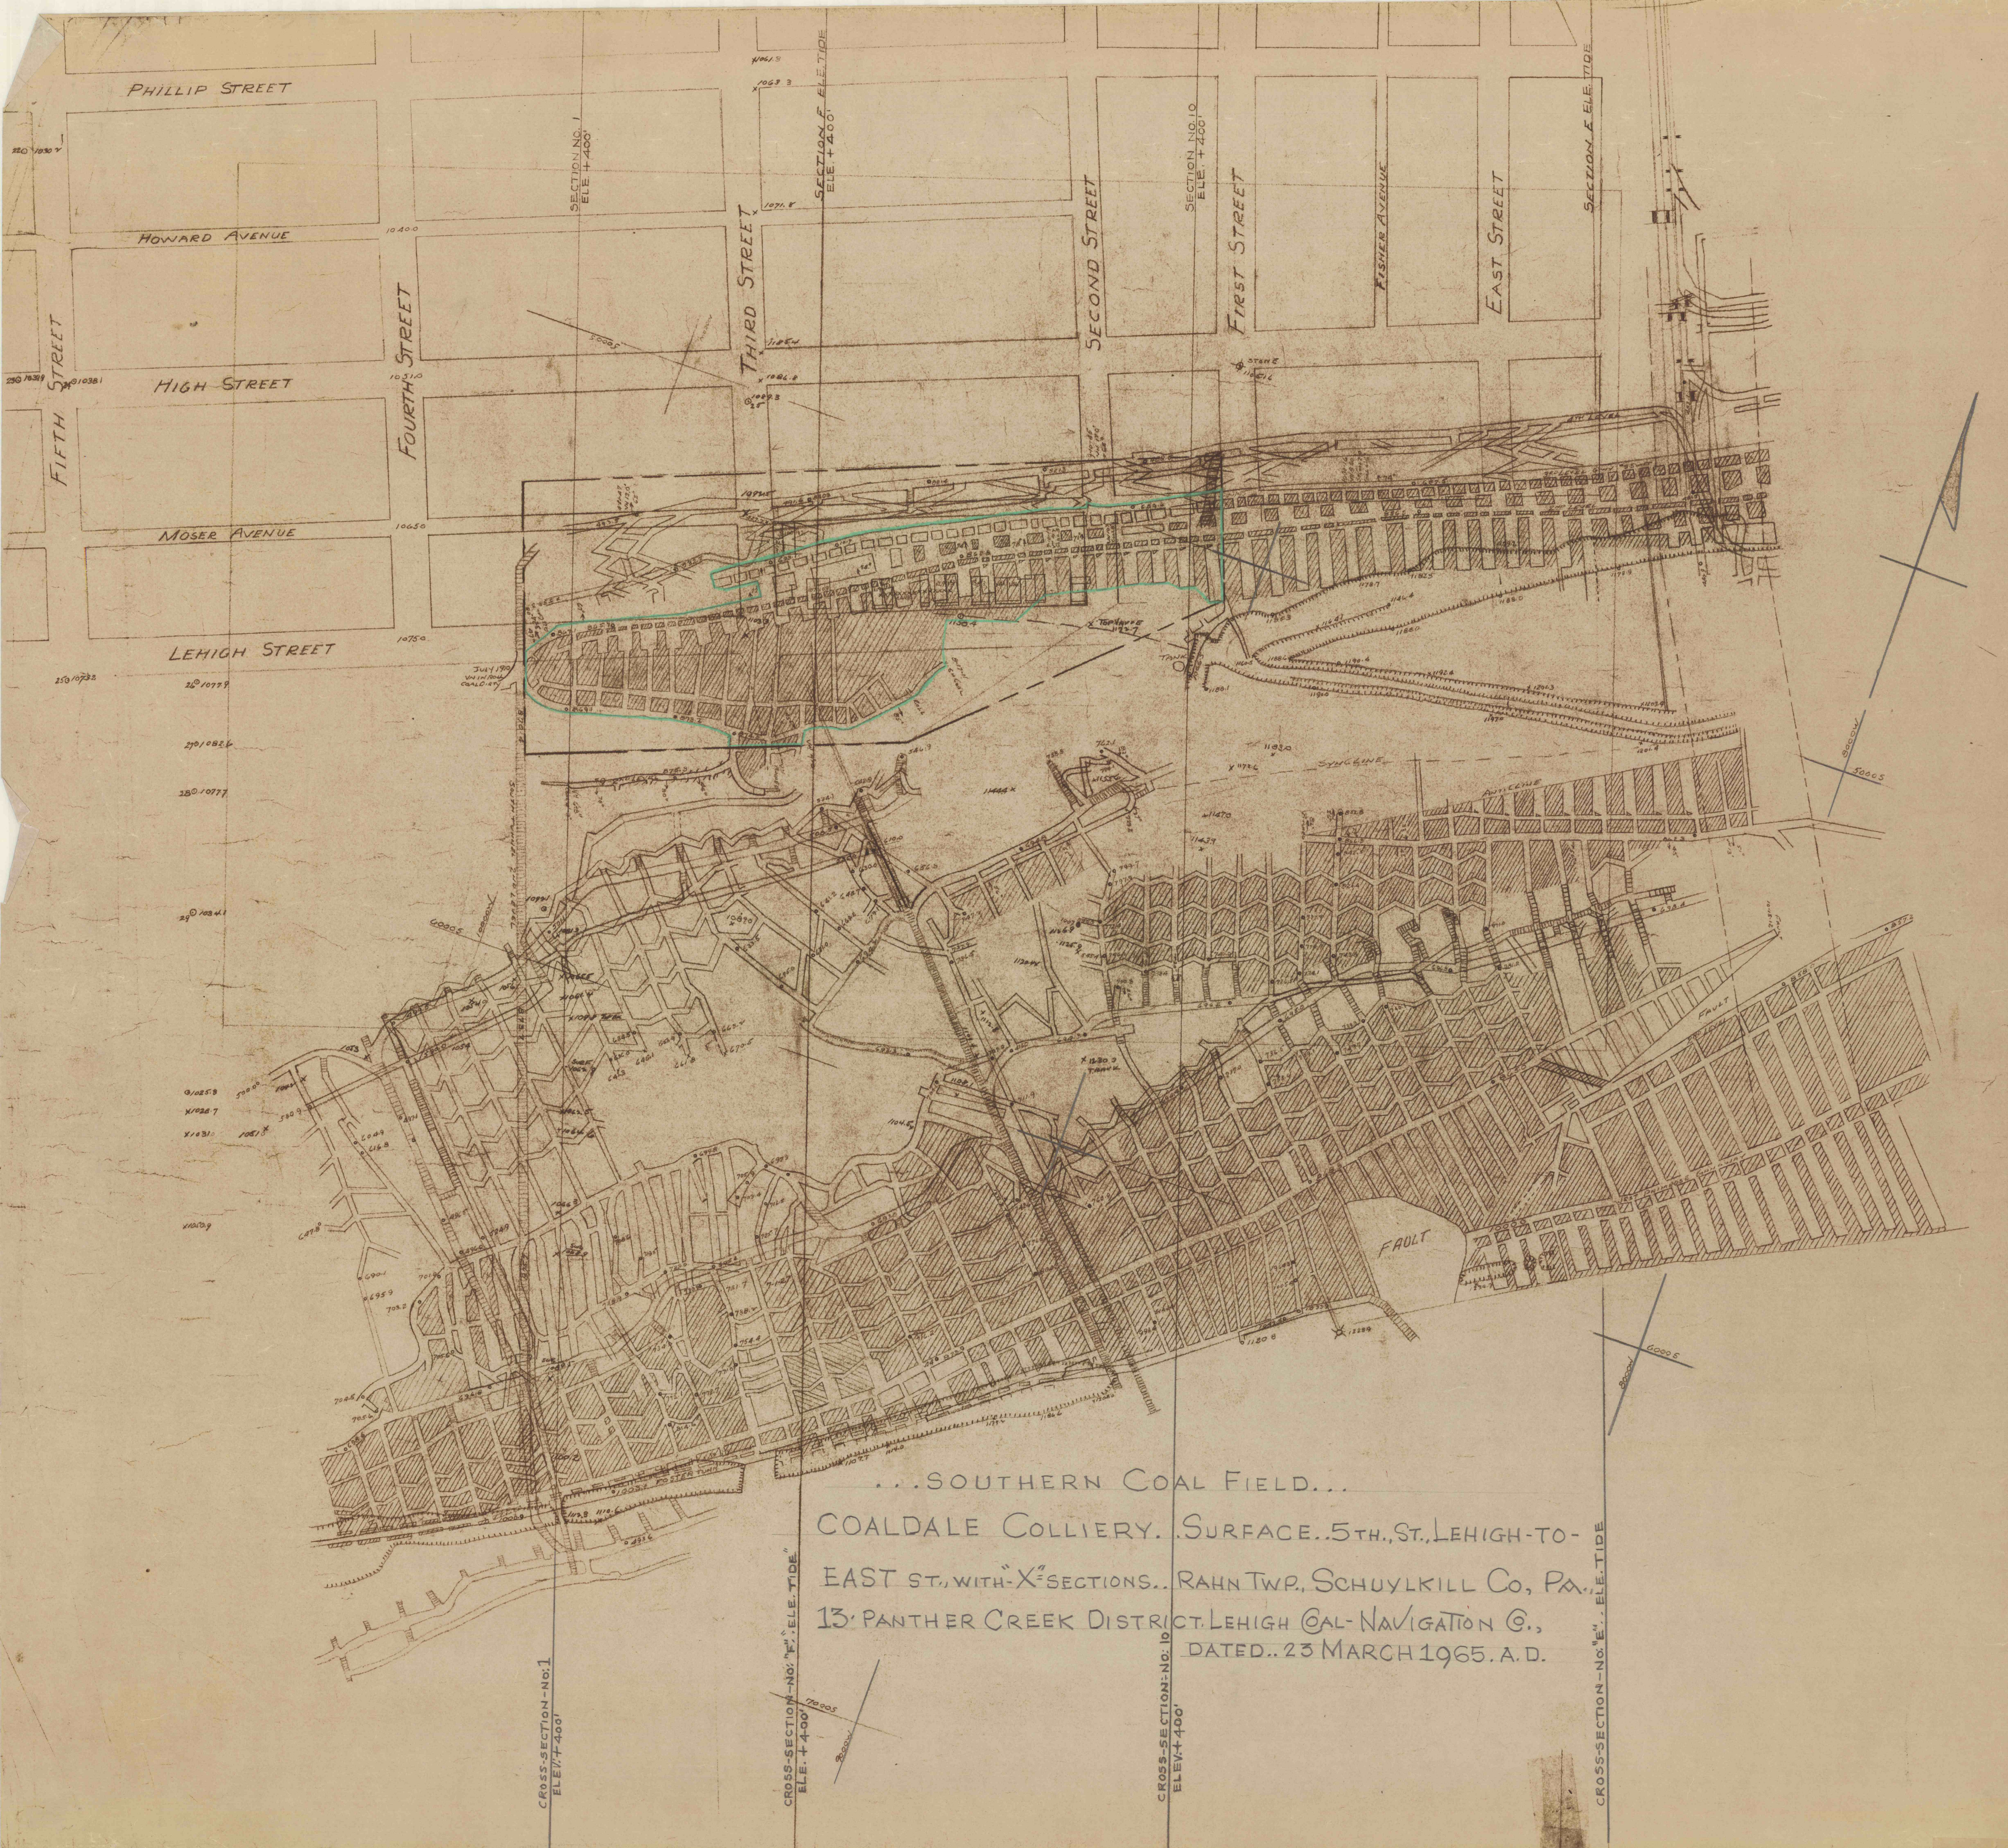

...SOUTHERN COAL FIELD...
COALDALE COLLIERY. SURFACE. 5TH. ST. LEHIGH TO-
EAST ST. WITH "X" SECTIONS. RAHN TWP. SCHUYLKILL CO., PA.
13. PANTHER CREEK DISTRICT. LEHIGH COAL NAVIGATION CO.,
DATED. 23 MARCH 1965. A.D.

CROSS-SECTION-NO. 1
ELE. +400'

ELE. +400'

CROSS-SECTION-NO. 10
ELE. +400'

ELE. +400'