


SEE DWG D-796 & D-855

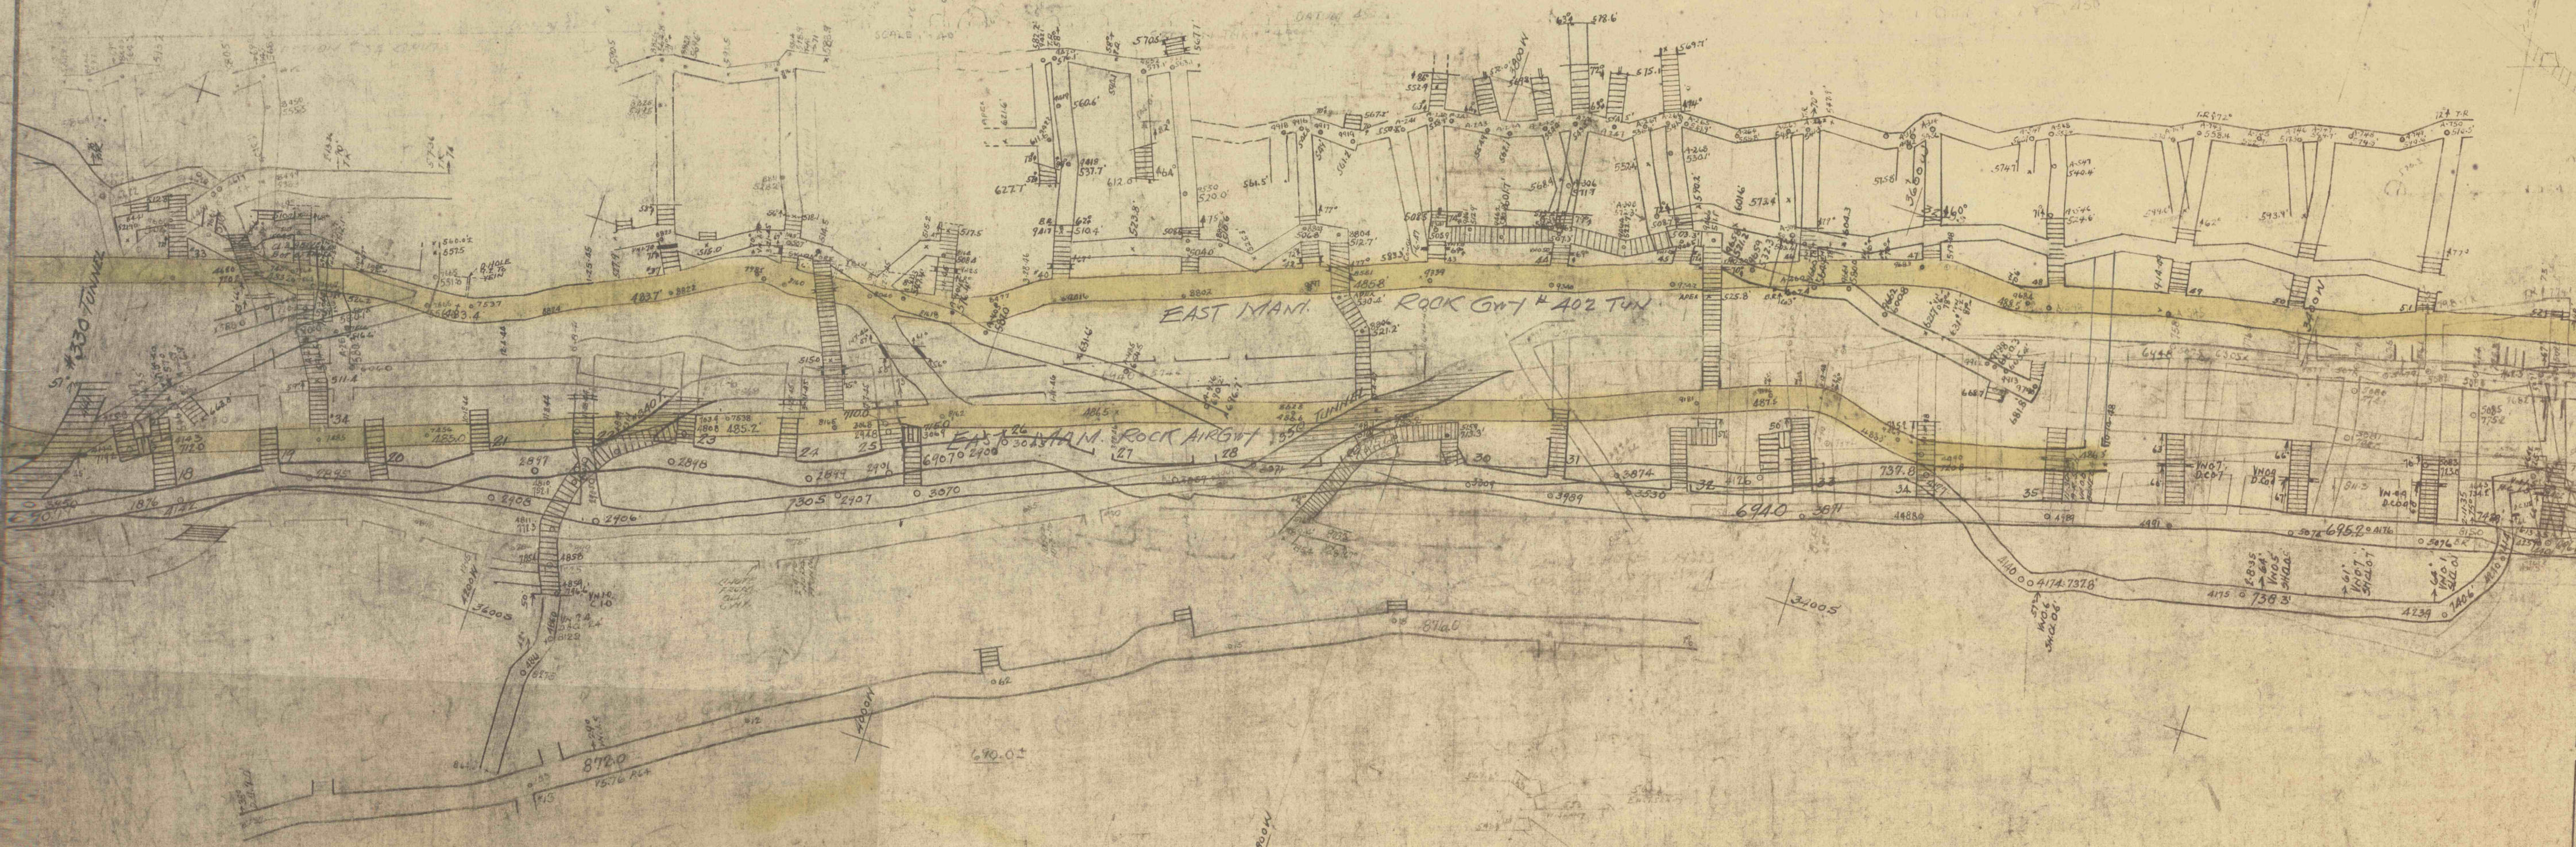

÷ NOTE ÷
NO MINING EAST OF "S20" WTE
BARRIER PILLAR.

BARRIER PILLAR

LEHIGH NAVIGATION COAL COMPANY
LANGFORD, PENNA.
MINING ENGINEERING DEPT.

GOALDALE COLLIERY
SKETCH SHOWING EAST MAIN ROBE
GANGWAY & AIRWAY #550 TUNNEL
FROM #330 TUNNEL TO BARRIER
PILLAR 3RD LEVEL 4TH FINE

SCALE 1"=40' DATE JAN 35
MADE BY J. G. STANLEY & J. G. STANLEY
REVISED
APPROVED

D781