


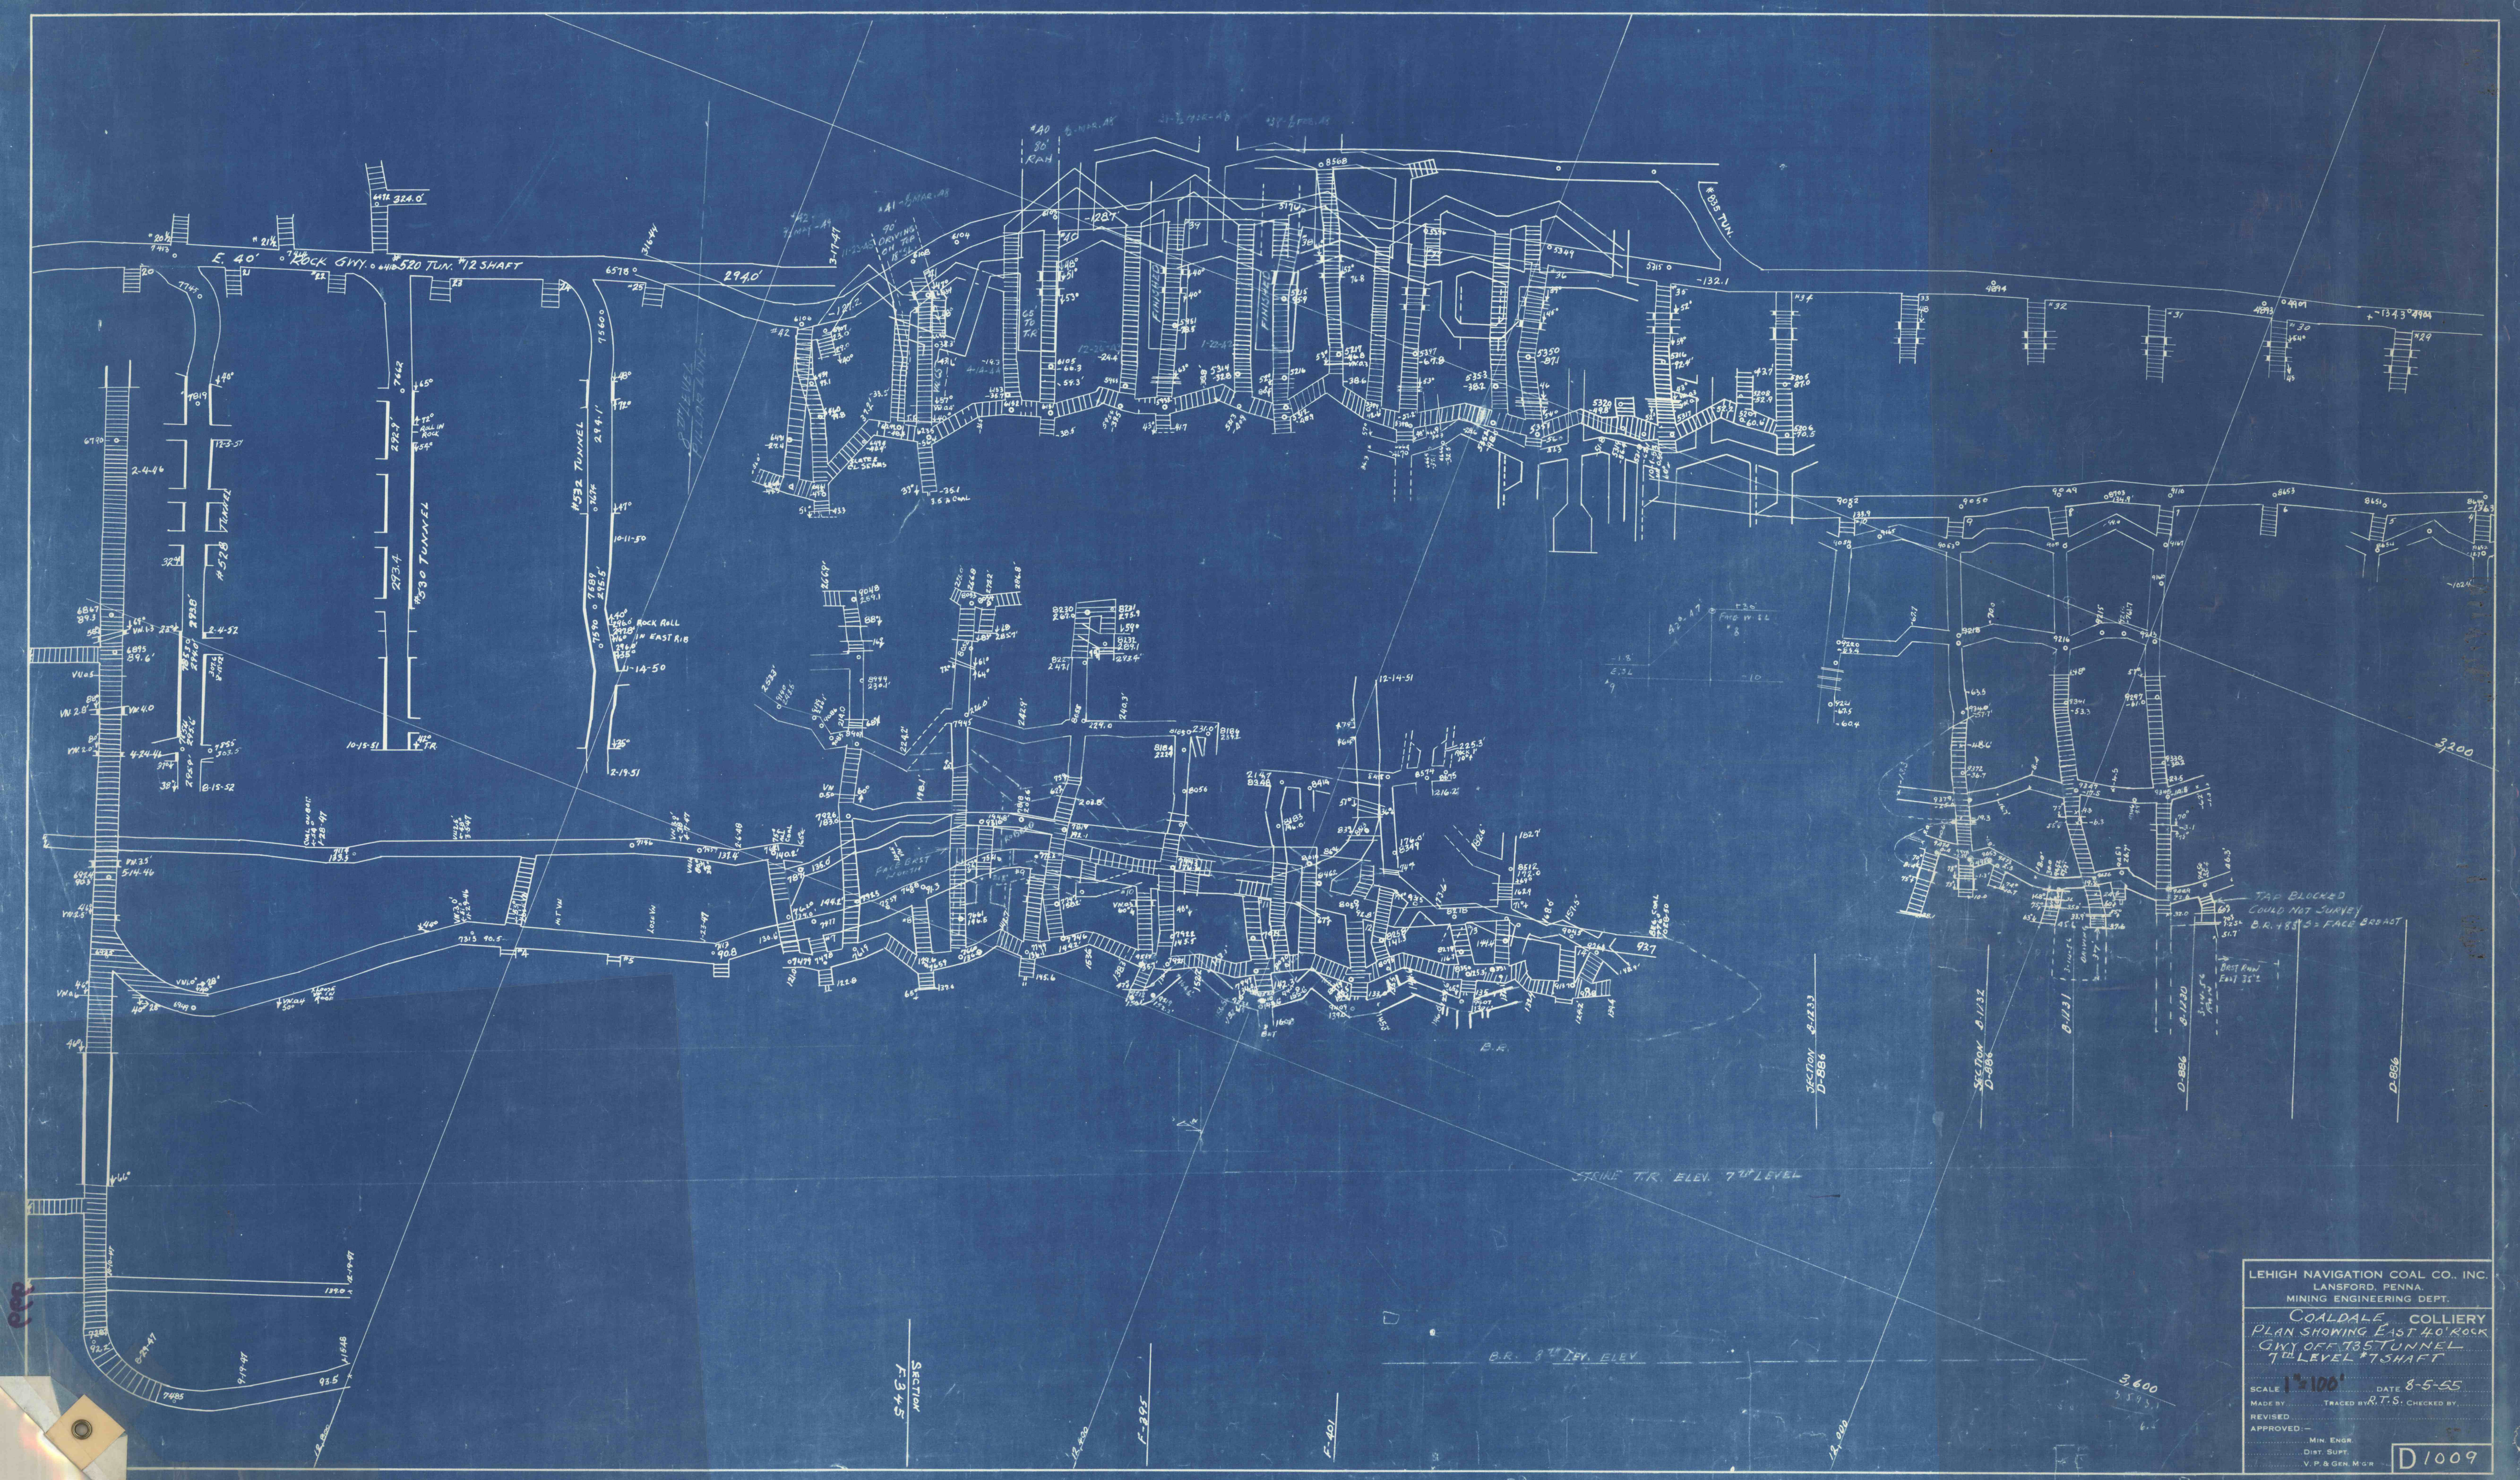

LEHIGH NAVIGATION COAL CO., INC.
LANSFORD, PENNA.
MINING ENGINEERING DEPT.

COALDALE COLLIERY
PLAN SHOWING EAST 40' ROCK

MADE BY TRACED BY R.T.S. CHECKED BY
REVISED APPROVED -
MIN. ENGR.
DIST. SUPT.
V.P. & GEN. MGR

3600
5595.1
6.2

D 1009