
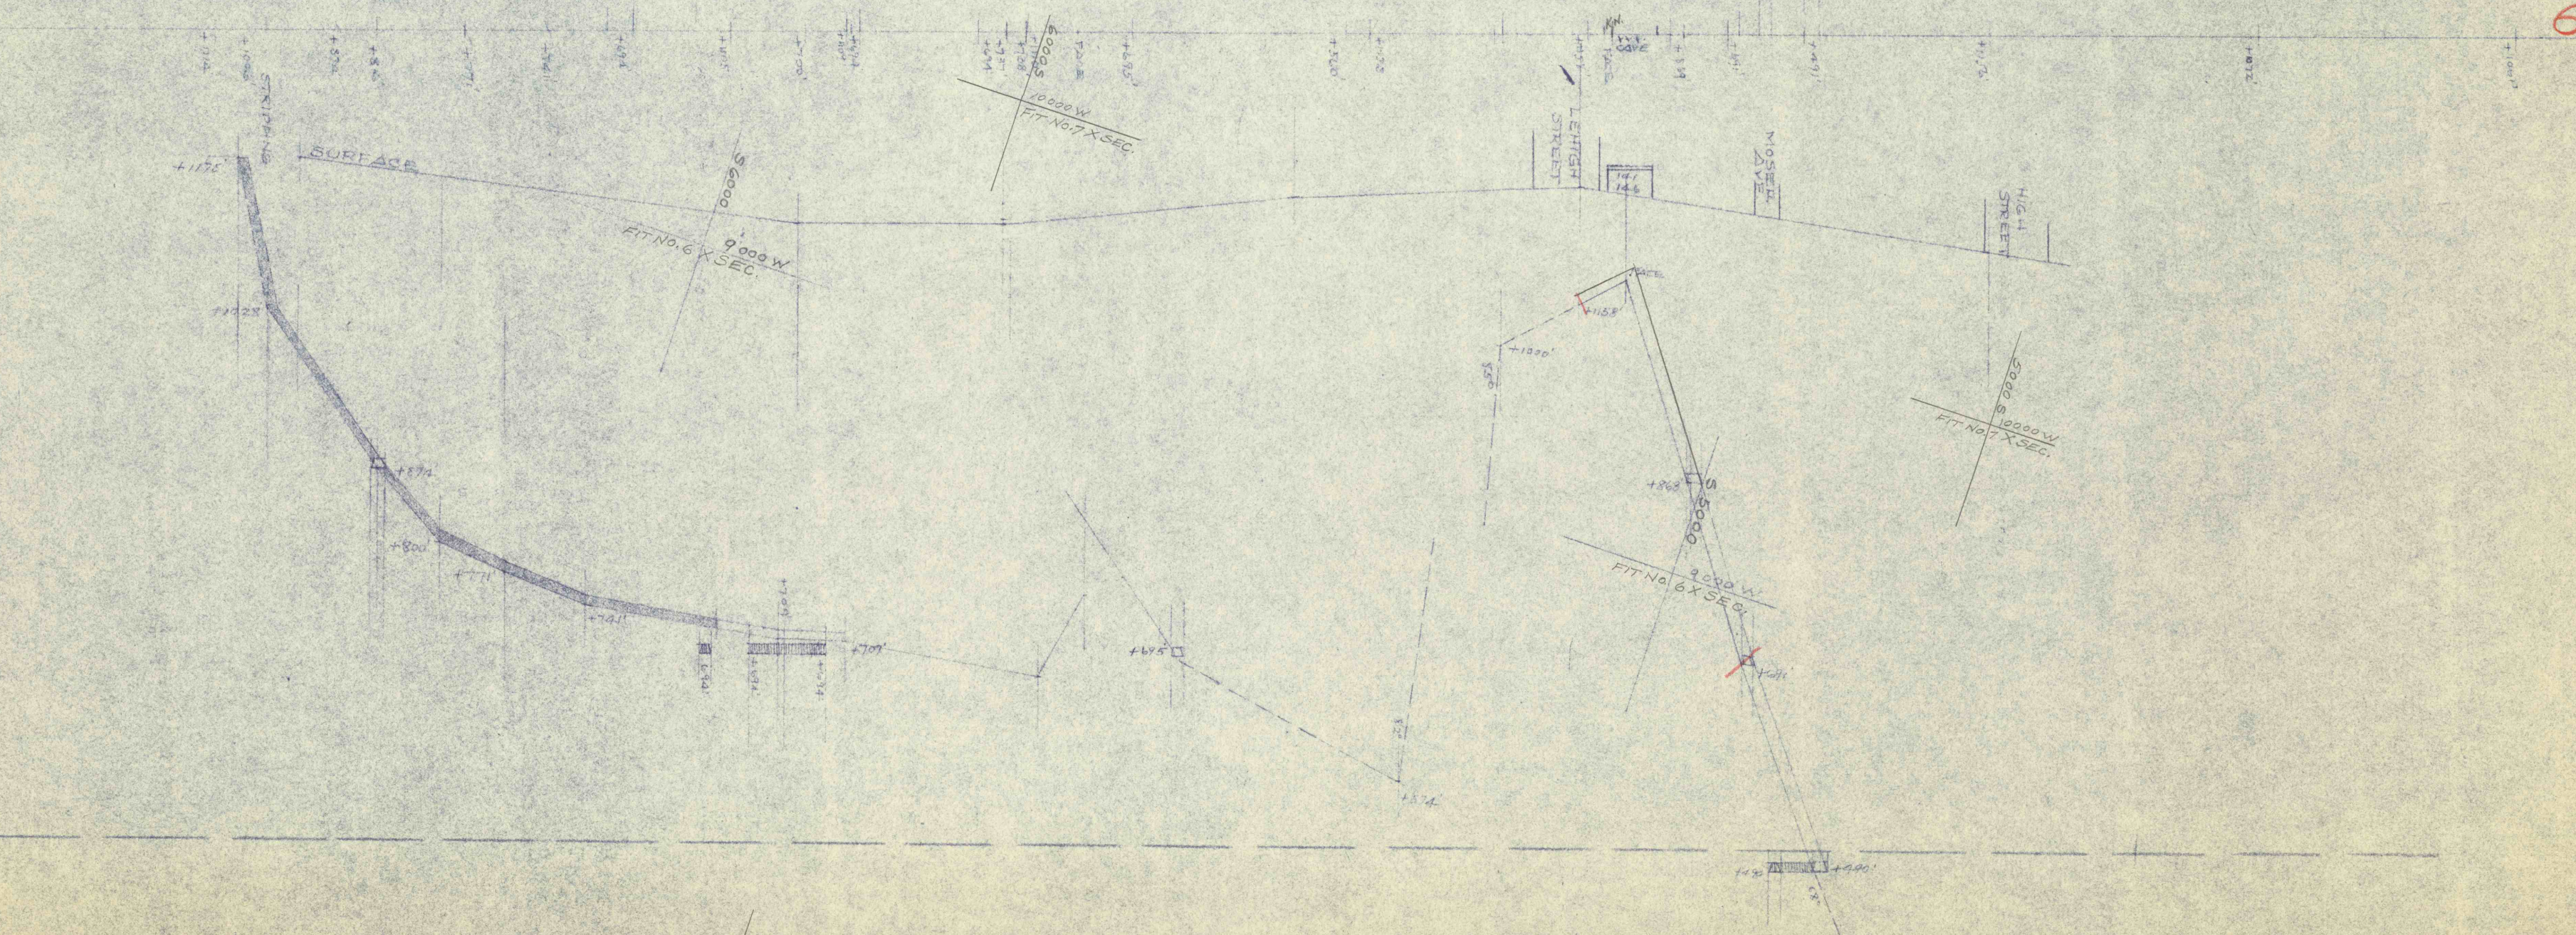


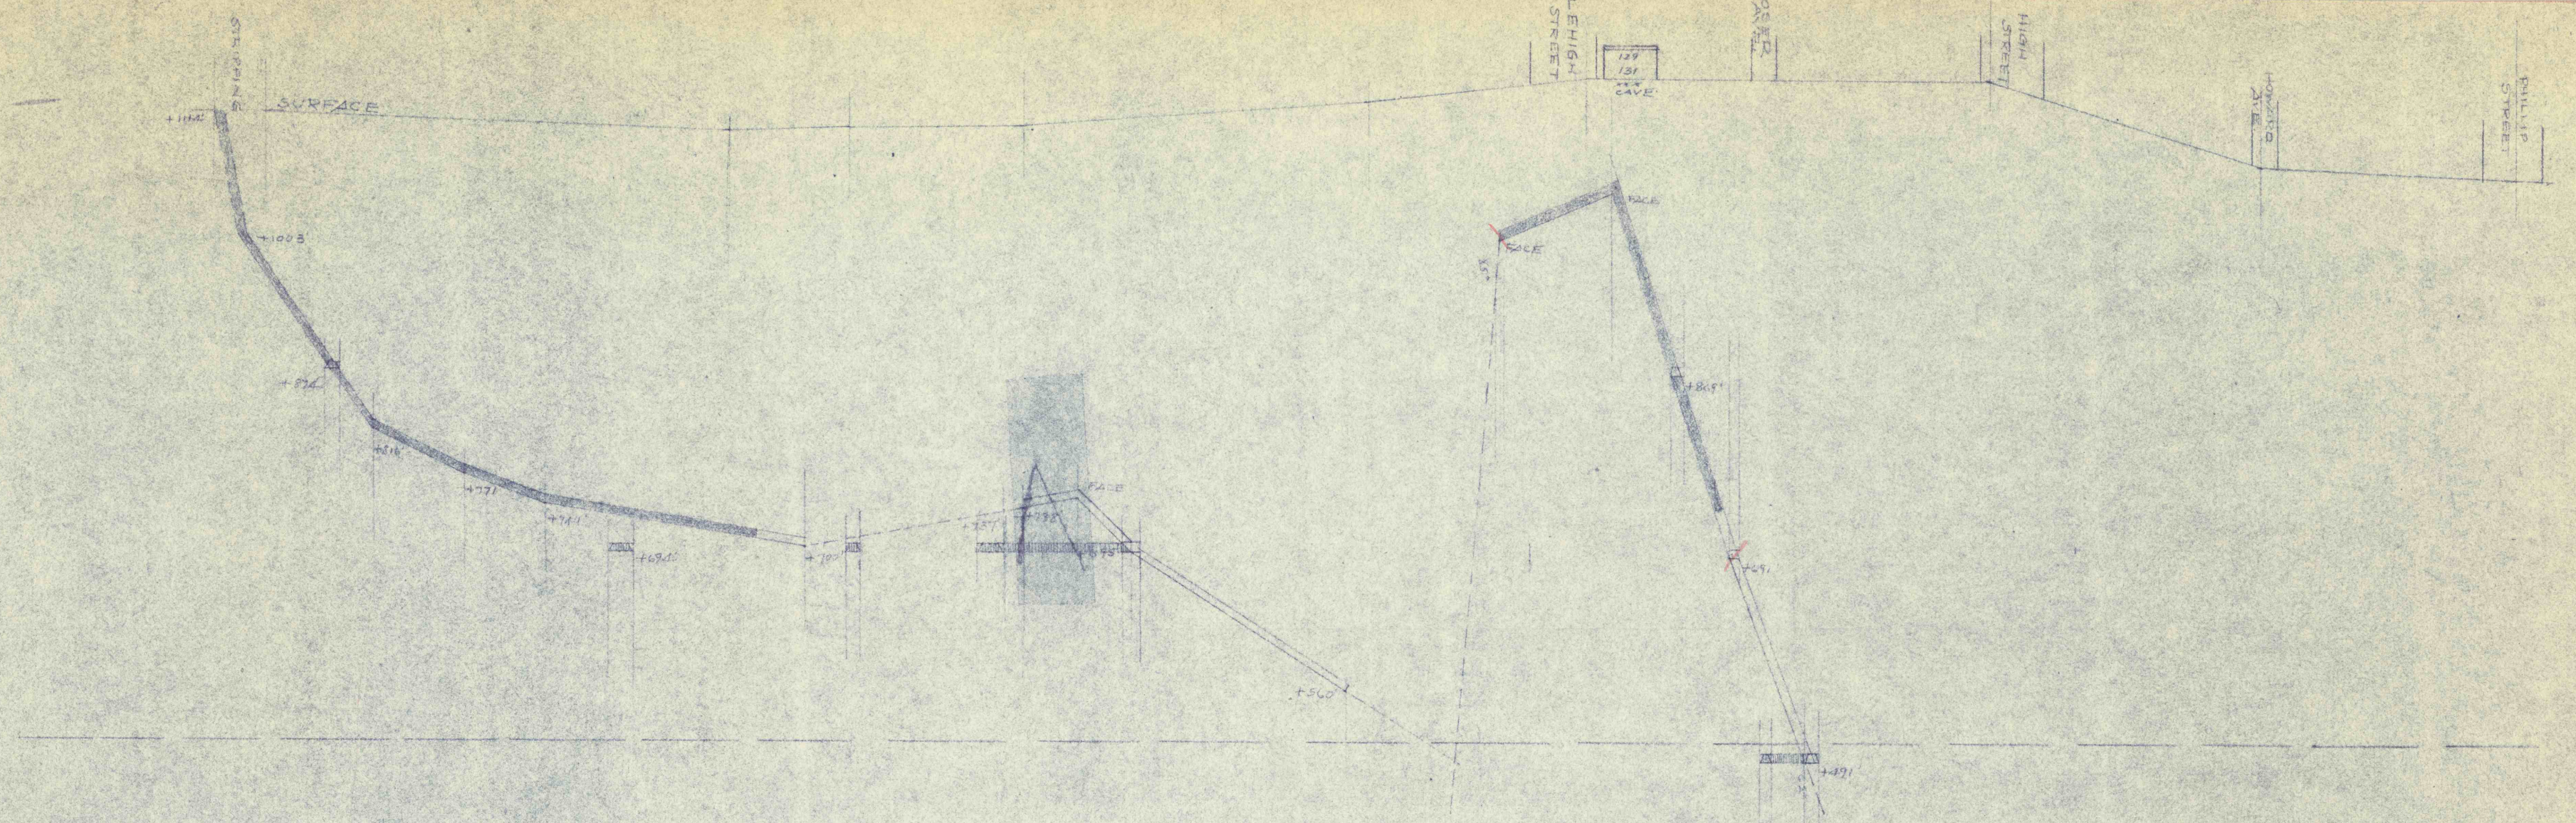

6

7

E