


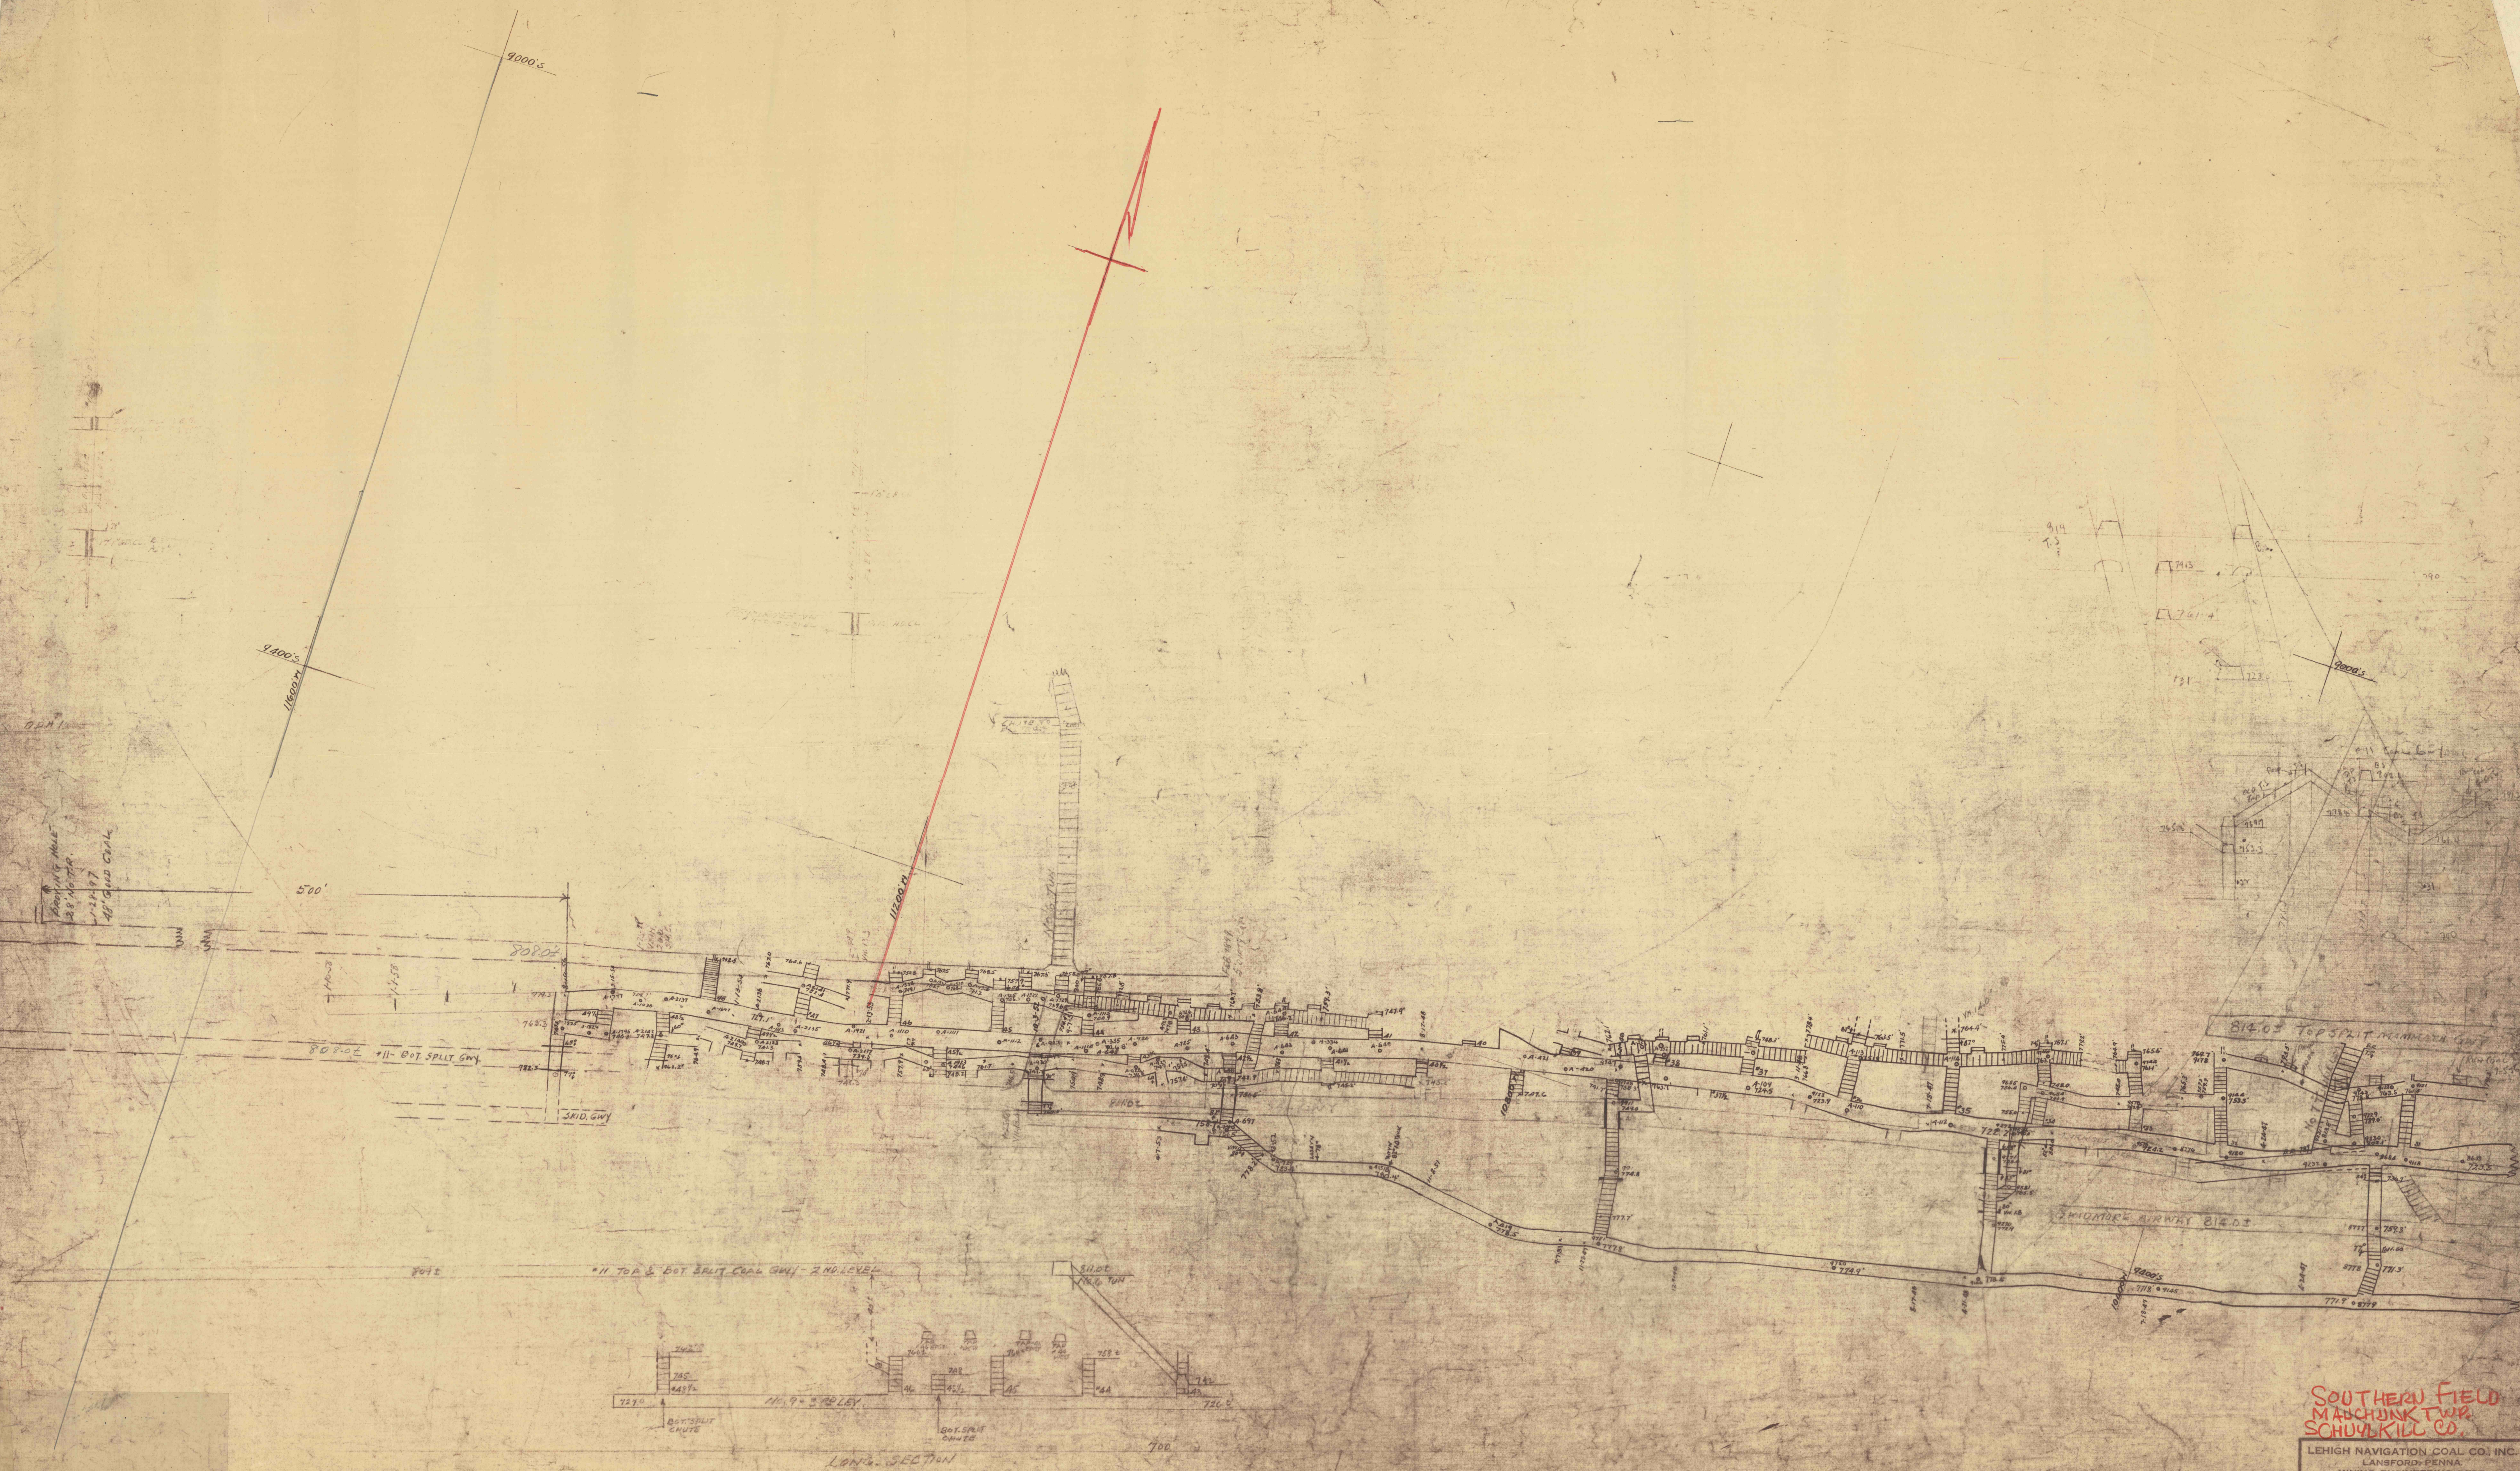

SOUTHERN FIELD
MACHUNKTOWN
SCHUYLKILL CO.

LEHIGH NAVIGATION COAL CO. INC.
LANSDOWN, PENNA.
MINING ENGINEERING DEPT.

COALDALE COLLIERY
PLAN SHOWING 3RD LEVEL
TO 4TH LEVEL OF 351 TUNNEL IN
"H" MOUNTAIN BASIN.

SCALE 1" = 40' DATE JUNE 25, 1917
MADE BY THAMES BY CHECKED BY
REVISED BY
APPROVED BY

G 305