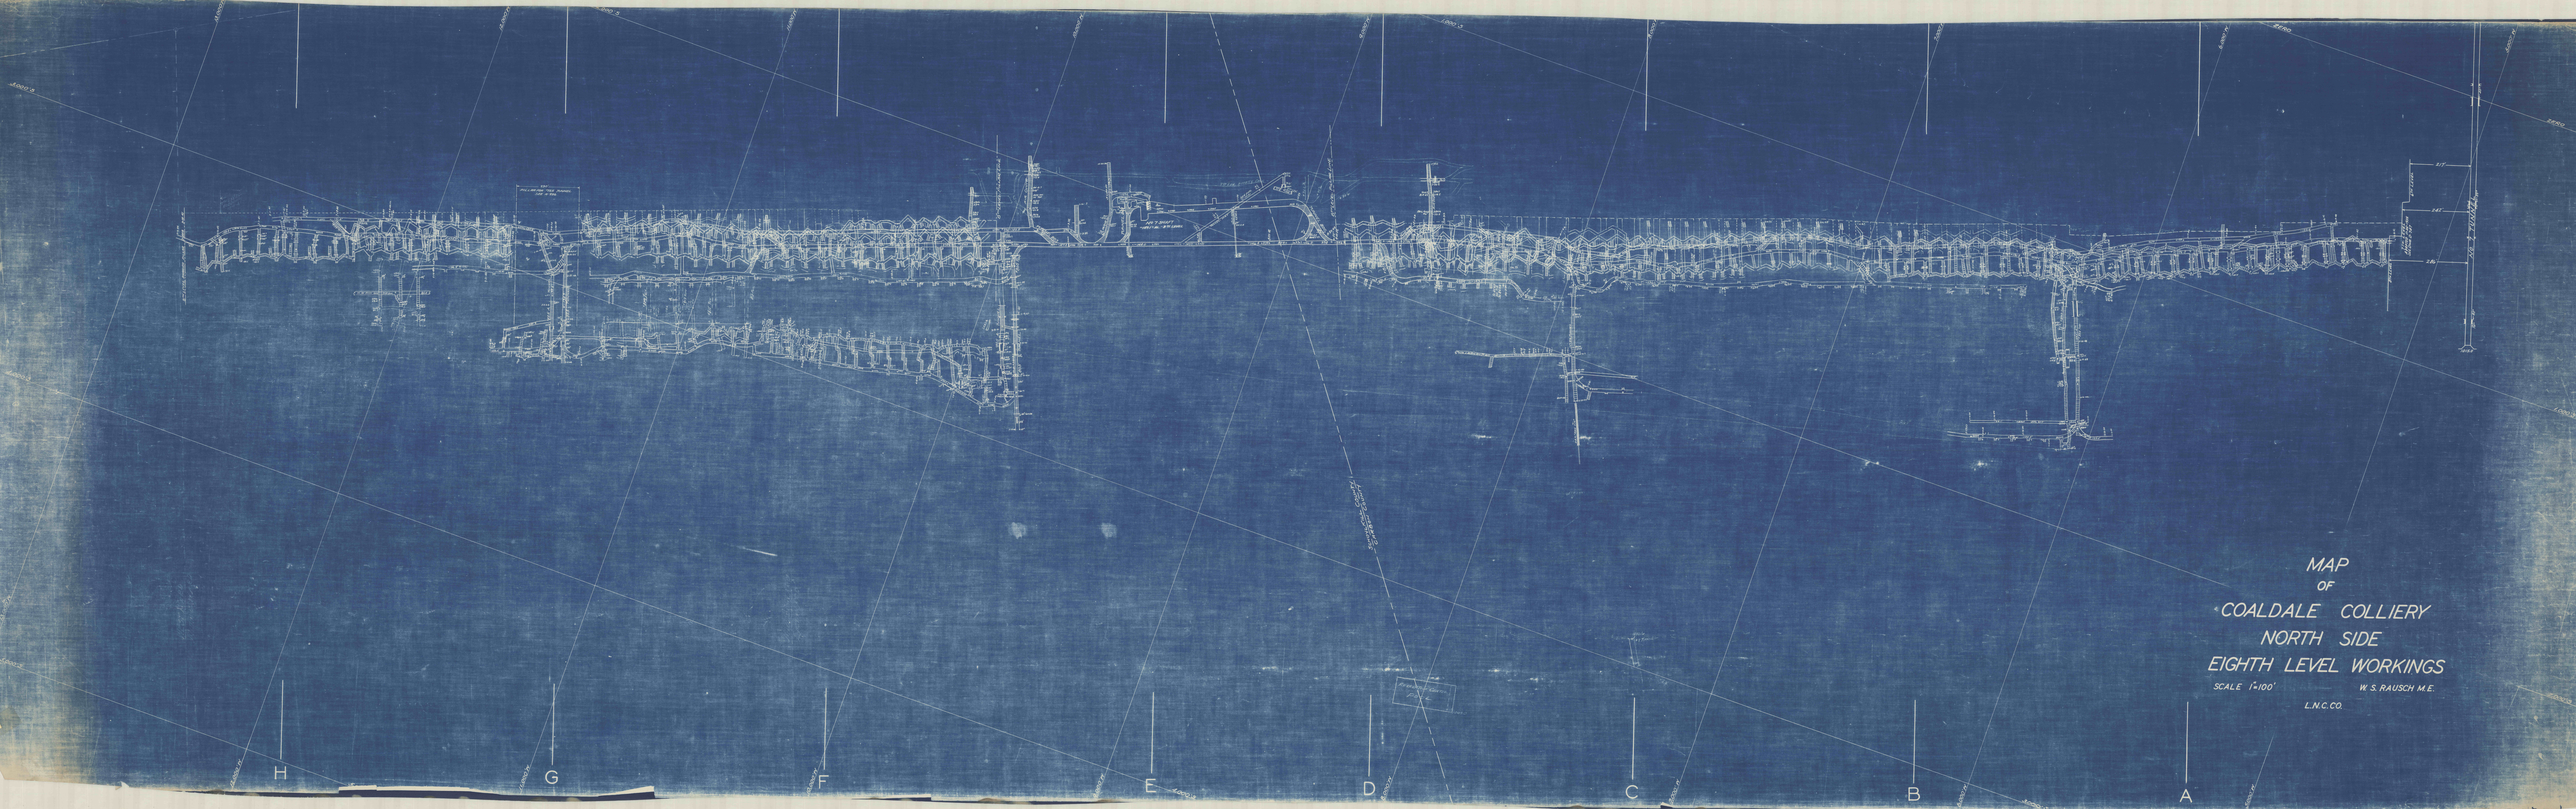

MAP
OF
COALDALE COLLIERY
NORTH SIDE
EIGHTH LEVEL WORKINGS

SCALE 1"=100'

W. S. RAUSCH M.E.

L.N.C. CO.